


BH: 2815' LAT: 39-35-00

BH: 5482' LONG: 80-27-30

Carnegie 7H
Carnegie
EQT Production Company

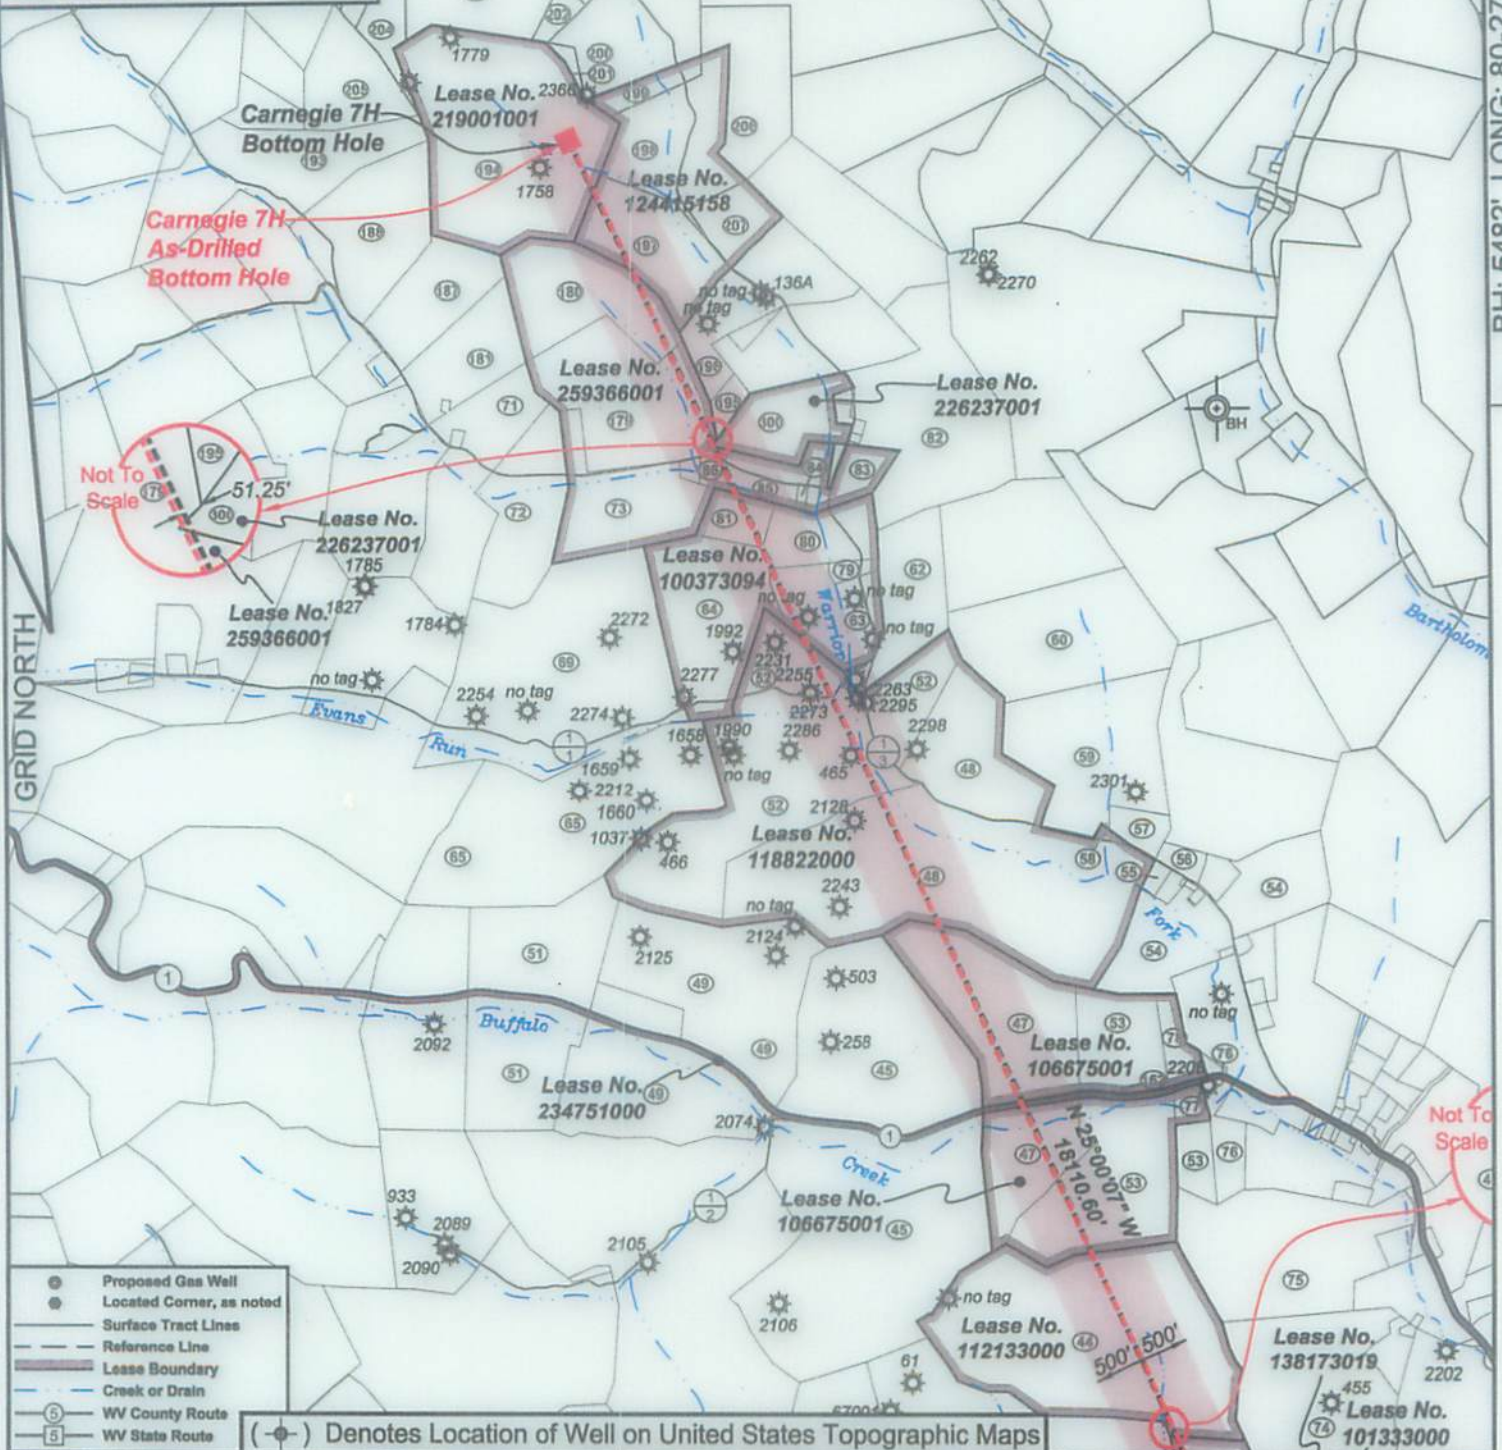

I, the undersigned, hereby certify that this plat is correct to the best of my knowledge and belief and shows all the information required by law and the regulations issued and prescribed by the Department of Environmental Protection.

Ben R. Singleton
P.S. 2092



SEAL

FILE NO: 92-21

DRAWING NO: Carnegie 7H

SCALE: 1" = 2000'

MINIMUM DEGREE OF ACCURACY:
1:2500PROVEN SOURCE OF ELEVATION:
NGS CORS Station

STATE OF WEST VIRGINIA
DEPARTMENT OF ENVIRONMENTAL PROTECTION
OIL AND GAS DIVISION

DATE: June 03 20 24

OPERATOR'S WELL NO.: Carnegie 7H

API WELL NO

47 - 049 - 02523
STATE COUNTY PERMIT

WELL TYPE: ☐ OIL ☒ GAS ☐ LIQUID INJECTION ☐ WASTE DISPOSAL
(IF GAS) PRODUCTION: ☐ STORAGE ☐ DEEP ☒ SHALLOW

LOCATION: ELEVATION: As-Built: 1318' WATERSHED: Laurel Run of Owen Davy Fork QUADRANGLE: Glover Gap

DISTRICT: Mannington COUNTY: Marion

SURFACE OWNER: Jeanne A. Musgrave Akers & Joseph Forte

ACREAGE: 28.96

ROYALTY OWNER: Bounty Minerals, LLC, et al.

LEASE NO: 112106000 ACREAGE: 135

PROPOSED WORK: ☒ DRILL ☐ CONVERT ☐ DRILL DEEPER ☒ FRACTURE OR STIMULATE ☐ PLUG OFF OLD FORMATION
☐ PERFORATE NEW FORMATION ☐ OTHER PHYSICAL CHANGE IN WELL (SPECIFY)

☐ PLUG AND ABANDON ☐ CLEAN OUT AND REPLUG TARGET FORMATION: Marcellus ESTIMATED DEPTH: 7712'

WELL OPERATOR: EQT Production Company

DESIGNATED AGENT: Joseph C. Mallow


ADDRESS: 400 Woodcliff Drive

ADDRESS: 427 Midstate Drive

Canonsburg, PA 15317

Clarksburg, WV 25301

09/19/2025

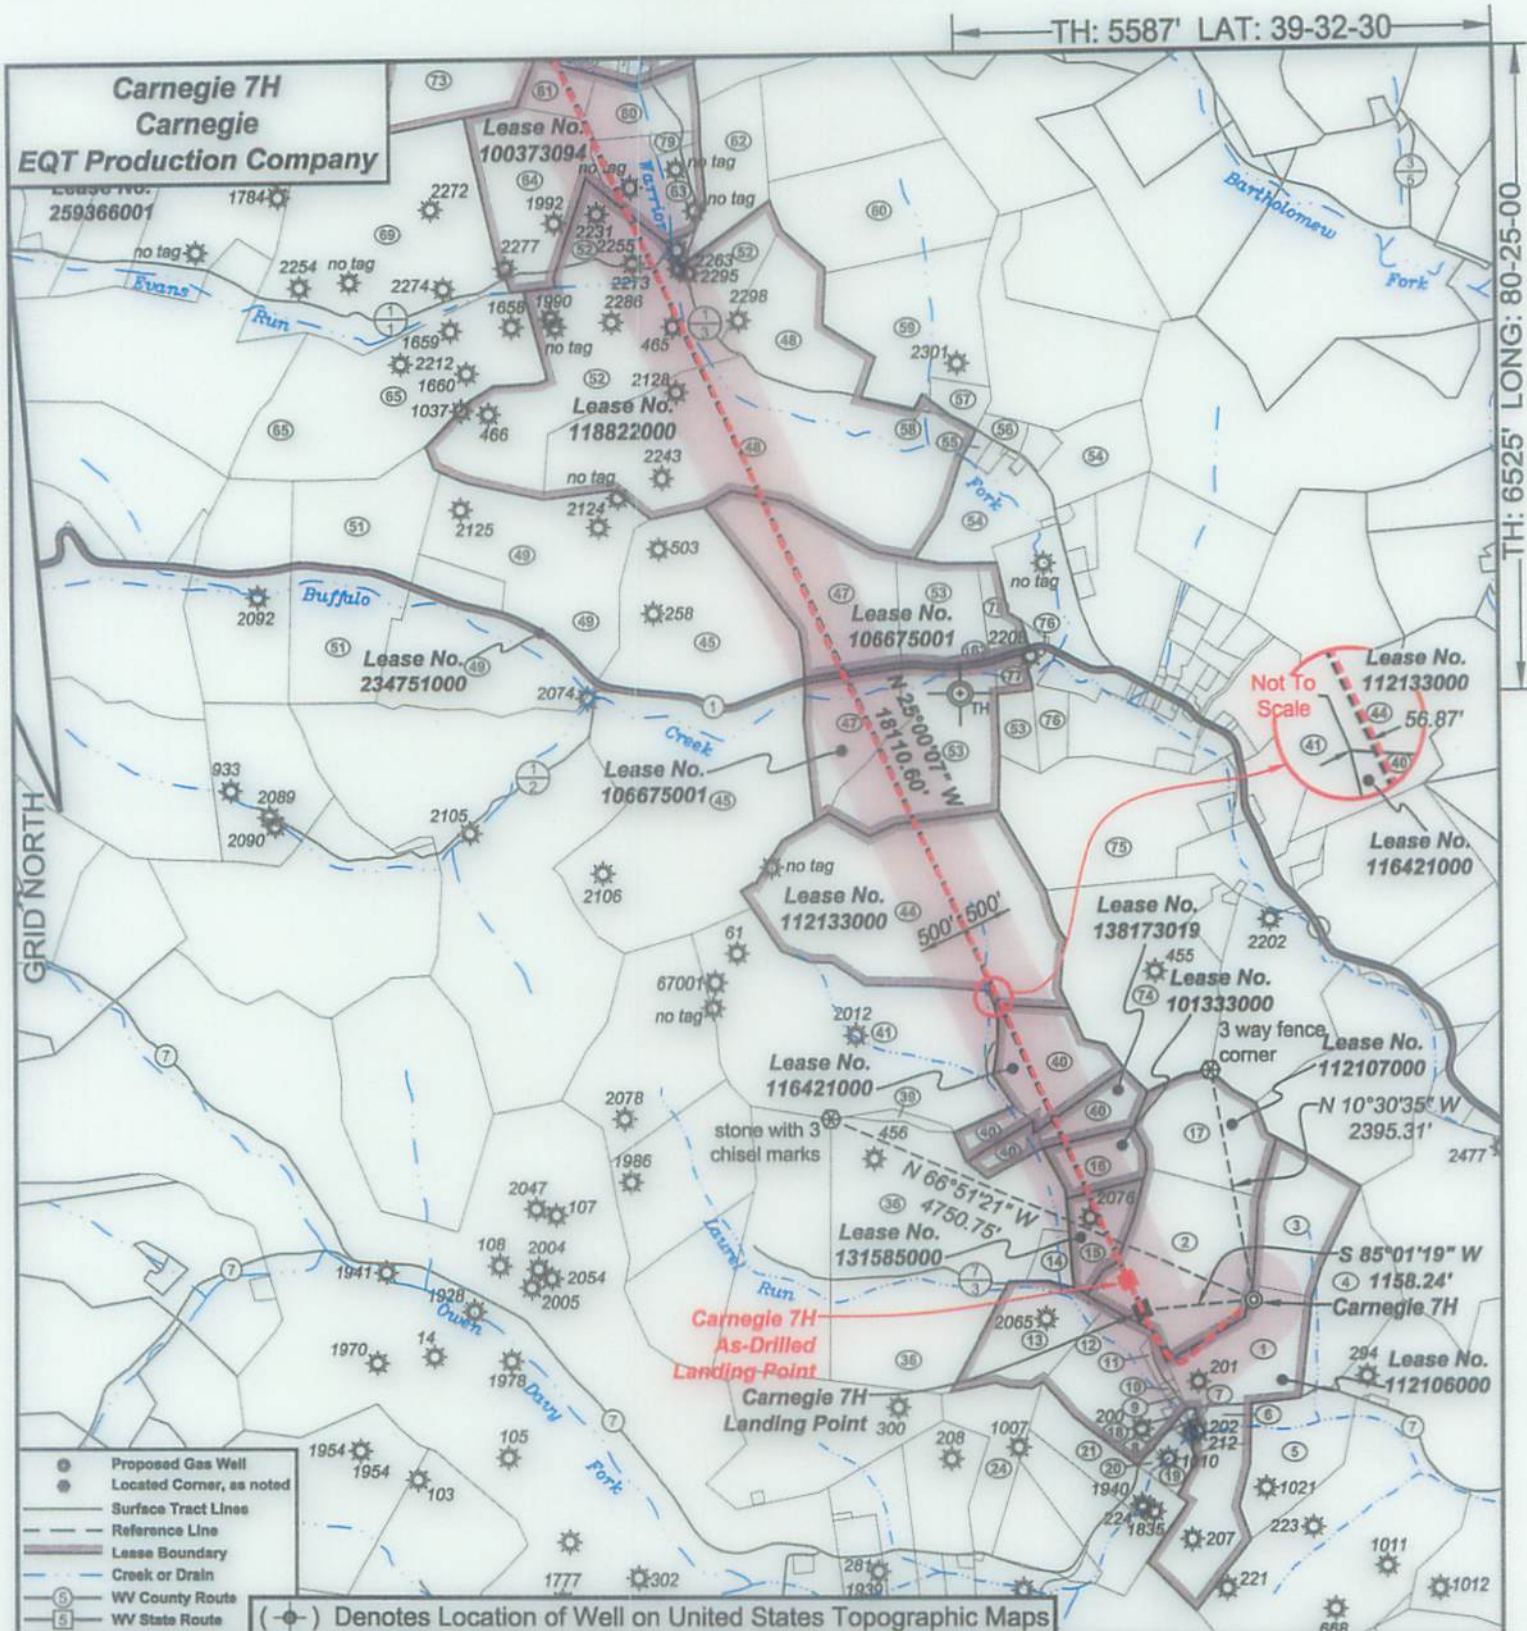

I, the undersigned, hereby certify that this plat is correct to the best of my knowledge and belief and shows all the information required by law and the regulations issued and prescribed by the Department of Environmental Protection.

Ben R. Singleton
P.S. 2092



SEAL

FILE NO: 92-21
DRAWING NO: Carnegie 7H
SCALE: 1" = 2000'
MINIMUM DEGREE OF ACCURACY:
1:2500
PROVEN SOURCE OF ELEVATION:
NGS CORS Station

STATE OF WEST VIRGINIA
DEPARTMENT OF ENVIRONMENTAL PROTECTION
OIL AND GAS DIVISION

DATE: June 03 20 24
OPERATOR'S WELL NO.: Carnegie 7H
API WELL NO
47 - 049 - 02523
STATE COUNTY PERMIT

WELL TYPE: ☐ OIL ☒ GAS ☐ LIQUID INJECTION ☐ WASTE DISPOSAL
(IF GAS) PRODUCTION: ☐ STORAGE ☐ DEEP ☒ SHALLOW

LOCATION: ELEVATION: As-Built: 1318' WATERSHED: Laurel Run of Owen Davy Fork QUADRANGLE: Glover Gap
DISTRICT: Mannington COUNTY: Marion

SURFACE OWNER: Jeanne A. Musgrave Akers & Joseph Forte ACREAGE: 28.96

ROYALTY OWNER: Bounty Minerals, LLC, et al. LEASE NO: 112106000 ACREAGE: 135

PROPOSED WORK: ☒ DRILL ☐ CONVERT ☐ DRILL DEEPER ☒ FRACTURE OR STIMULATE ☐ PLUG OFF OLD FORMATION
☐ PERFORATE NEW FORMATION ☐ OTHER PHYSICAL CHANGE IN WELL (SPECIFY)
☐ PLUG AND ABANDON ☐ CLEAN OUT AND REPLUG TARGET FORMATION: Marcellus ESTIMATED DEPTH: 7712'

WELL OPERATOR: EQT Production Company
ADDRESS: 400 Woodcliff Drive
Canonsburg, PA 15317

DESIGNATED AGENT: Joseph C. Mallow
ADDRESS: 427 Midstate Drive
Clarksburg, WV 25301

09/19/2025

Carnegie 7H
Carnegie
EQT Production Company



Lease No.	Owner	Acres
112106000	Bounty Minerals, LLC, et al.	135
112107000	EQT Production Company, et al.	81
131585000	EQT Production Company	17
101333000	Mannington Church of Christ	13
138173019	Mike Ross, Inc., et al.	16.5
116421000	Consolidation Coal Company, et al.	32
112133000	AMP IV, LP	106
106675001	Ann A. Kessler, et al.	158.76
234751000	West Virginia Department of Transportation, Division of Highways	46.86
118622000	John M. Bachman, et al.	260.4
100373094	Lou Ellen Brumage, et al.	93.23
259366001	Country Roads Minerals, LLC, et al.	143
226237001	Priscilla J. Vincent, et al.	18.02
124415158	Christ Episcopal Church, et al.	78.6
219001001	Country Roads Minerals LLC, et al.	90

As Drilled Well Information:
Carnegie 7H coordinates are
NAD 27 N: 374,249.64 E: 1,735,834.38
NAD 83 UTM N: 4,375,061.85 E: 548,451.37
Carnegie 7H Landing Point coordinates are
NAD 27 N: 374,458.64 E: 1,734,533.14
NAD 83 UTM N: 4,375,118.91 E: 548,053.87
Carnegie 7H Bottom Hole coordinates are
NAD 27 N: 390,562.99 E: 1,727,028.93
NAD 83 UTM N: 4,379,987.20 E: 545,685.93
West Virginia Coordinate system of 1927 (North Zone)
based upon Differential GPS Measurements.
Plat orientation, corner and well ties are based upon
the grid north meridian.
Well location references are based upon the grid north
meridian.
UTM coordinates are NAD83, Zone 17, Meters.

Carnegie


- ⊙ Carnegie 19H
- ⊙ Carnegie 17H
- ⊙ Carnegie 15H
- ⊙ Carnegie 13H
- ⊙ Carnegie 11H
- ⊙ Carnegie 9H
- ⊙ Carnegie 7H
- ⊙ Carnegie 5H
- ⊙ Carnegie 3H
- ⊙ Carnegie 1H

Well References

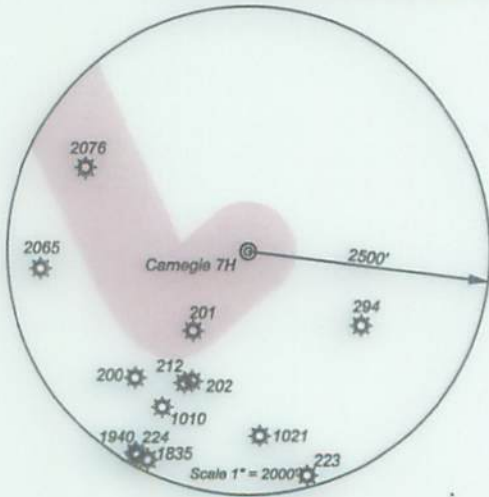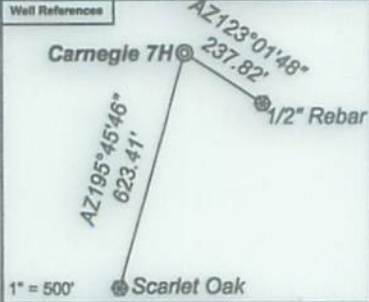

I, the undersigned, hereby certify that this plat is correct to the best of my knowledge and belief and shows all the information required by law and the regulations issued and prescribed by the Department of Environmental Protection.

[Signature]
P.S. 2092

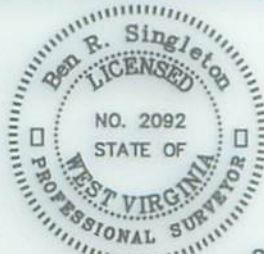

SEAL

FILE NO: 92-21
DRAWING NO: Carnegie 7H
SCALE: 1" = 2000'
MINIMUM DEGREE OF ACCURACY: 1:2500
PROVEN SOURCE OF ELEVATION: NGS CORS Station

STATE OF WEST VIRGINIA
DEPARTMENT OF ENVIRONMENTAL PROTECTION
OIL AND GAS DIVISION

DATE: June 03 20 24
OPERATOR'S WELL NO.: Carnegie 7H
API WELL NO
47 - 049 - 02523
STATE COUNTY PERMIT

WELL TYPE: ☐ OIL ☒ GAS ☐ LIQUID INJECTION ☐ WASTE DISPOSAL
(IF GAS) PRODUCTION: ☐ STORAGE ☐ DEEP ☒ SHALLOW
LOCATION: ELEVATION: As-Built: 1316' WATERSHED Laurel Run of Owen Davy Fork QUADRANGLE: Glover Gap
DISTRICT: Mannington COUNTY: Marion
SURFACE OWNER: Jeanne A. Musgrave Akers & Joseph Forte ACREAGE: 28.96
ROYALTY OWNER: Bounty Minerals, LLC, et al. LEASE NO: 112106000 ACREAGE: 135
PROPOSED WORK: ☒ DRILL ☐ CONVERT ☐ DRILL DEEPER ☒ FRACTURE OR STIMULATE ☐ PLUG OFF OLD FORMATION
☐ PERFORATE NEW FORMATION ☐ OTHER PHYSICAL CHANGE IN WELL (SPECIFY)
☐ PLUG AND ABANDON ☐ CLEAN OUT AND REPLUG TARGET FORMATION: Marcellus ESTIMATED DEPTH: 7712'

WELL OPERATOR: EQT Production Company DESIGNATED AGENT: Joseph C. Mallow
ADDRESS: 400 Woodcliff Drive ADDRESS: 427 Midstate Drive
Canonsburg, PA 15317 Clarksburg, WV 25301