




I, the undersigned, hereby certify that this plat is correct to the best of my knowledge and belief and shows all the information required by law and the regulations issued and prescribed by the Department of Environmental Protection.

Ben R. Singleton

P.S. 2092

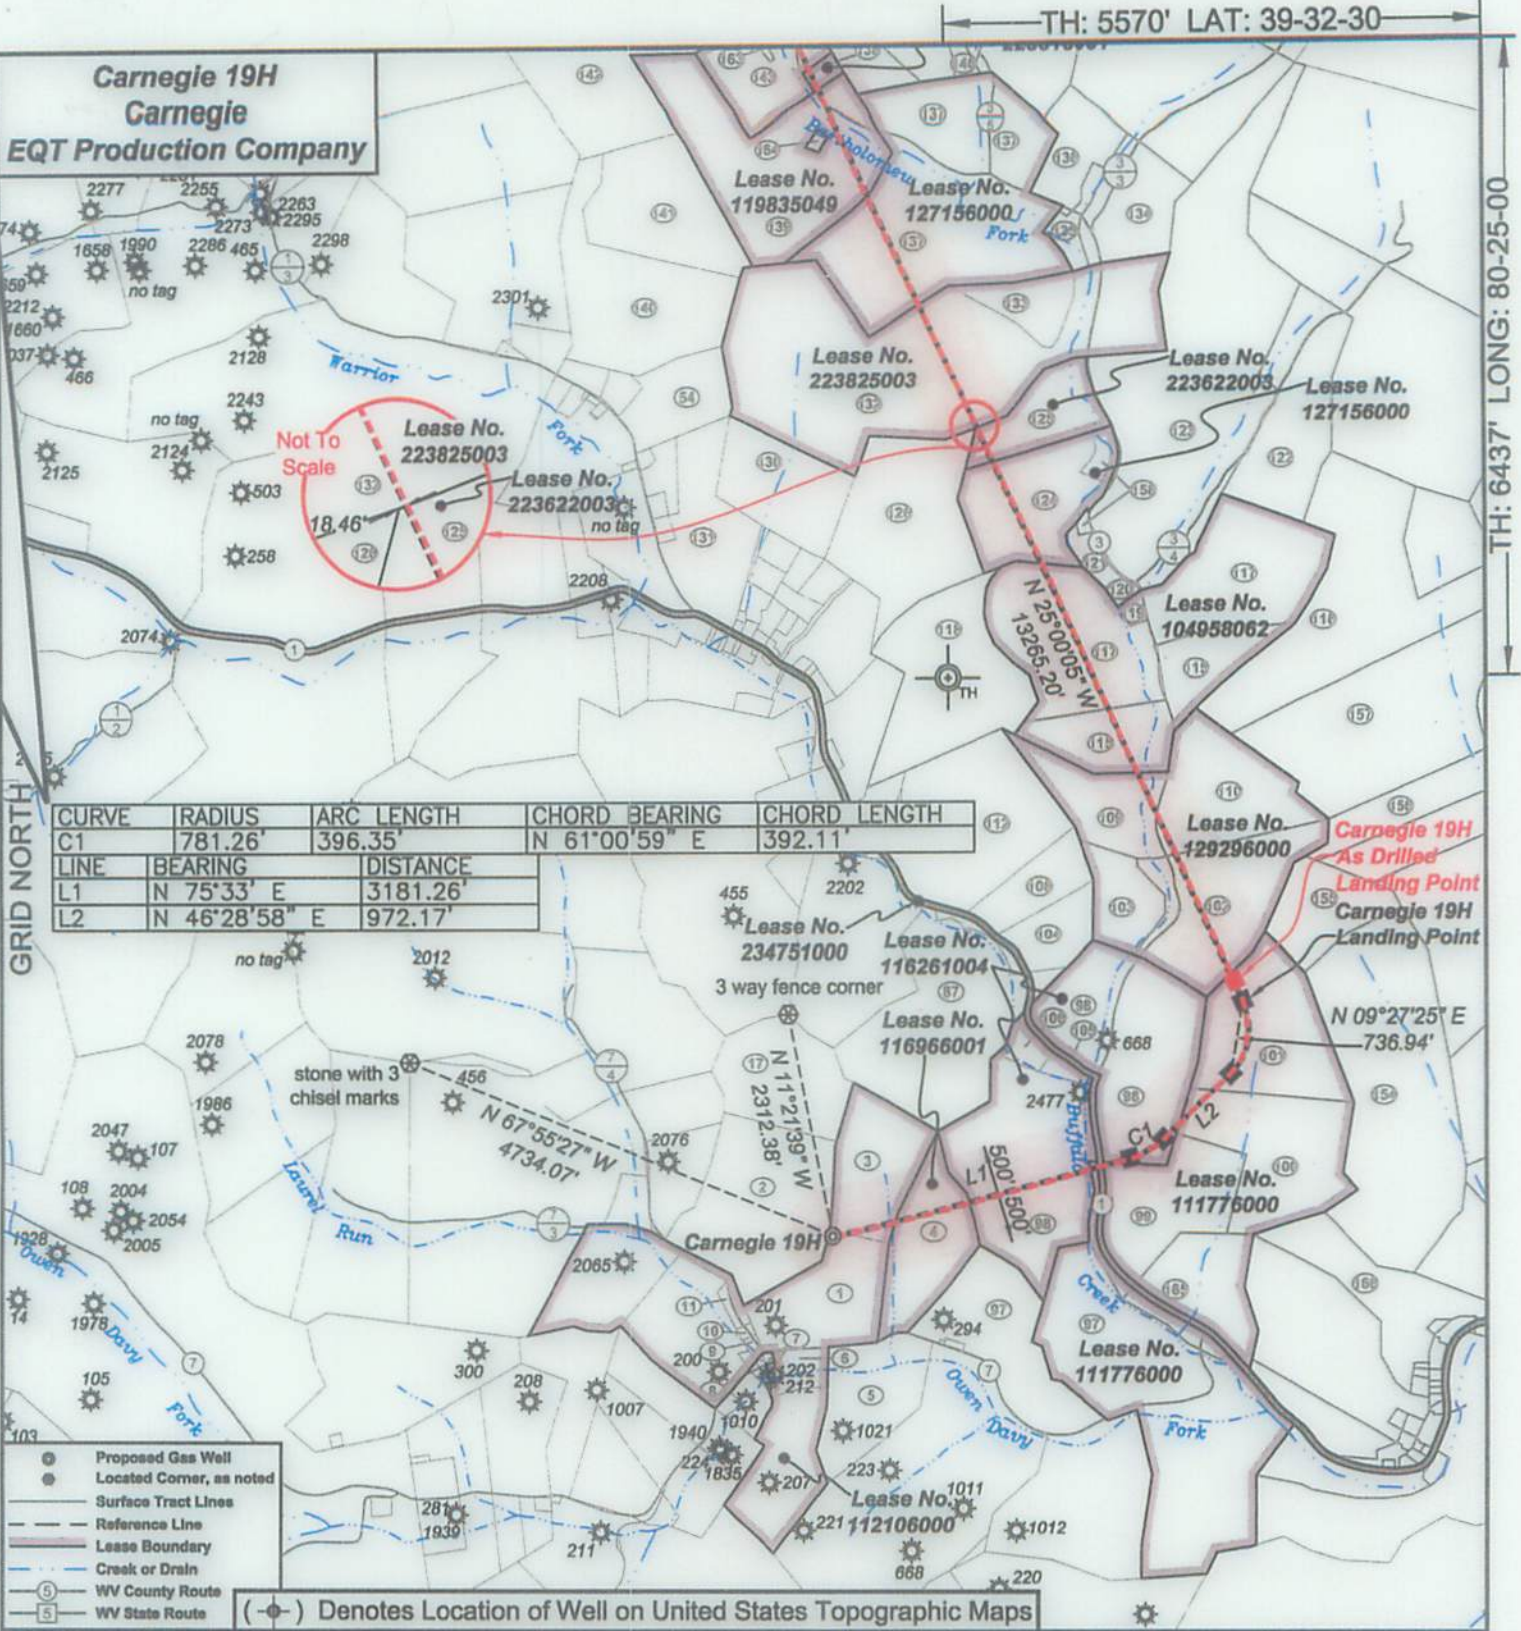

SEAL

FILE NO: 92-21
DRAWING NO: Carnegie 19H
SCALE: 1" = 2000'
MINIMUM DEGREE OF ACCURACY: 1:2500
PROVEN SOURCE OF ELEVATION: NGS CORS Station

STATE OF WEST VIRGINIA
DEPARTMENT OF ENVIRONMENTAL PROTECTION
OIL AND GAS DIVISION

DATE: July 12 20 24
OPERATOR'S WELL NO.: Carnegie 19H
API WELL NO
47 - 049 - 02529
STATE COUNTY PERMIT

WELL TYPE: ☐ OIL ☒ GAS ☐ LIQUID INJECTION ☐ WASTE DISPOSAL
(IF GAS) PRODUCTION: ☐ STORAGE ☐ DEEP ☒ SHALLOW
LOCATION: ELEVATION: As-Built: 1318' WATERSHED: Laurel Run of Owen Davy Fork QUADRANGLE: Glover Gap
DISTRICT: Mannington COUNTY: Marion
SURFACE OWNER: Jeanne A. Musgrave Akers & Joseph Forte ACREAGE: 28.96
ROYALTY OWNER: Bounty Minerals, LLC, et al. LEASE NO: 112106000 ACREAGE: 135
PROPOSED WORK: ☒ DRILL ☐ CONVERT ☐ DRILL DEEPER ☒ FRACTURE OR STIMULATE ☐ PLUG OFF OLD FORMATION
☐ PERFORATE NEW FORMATION ☐ OTHER PHYSICAL CHANGE IN WELL (SPECIFY)
☐ PLUG AND ABANDON ☐ CLEAN OUT AND REPLUG TARGET FORMATION: Marcellus ESTIMATED DEPTH: 7,712'

WELL OPERATOR: EQT Production Company DESIGNATED AGENT: Joseph C. Mallow
ADDRESS: 400 Woodcliff Drive ADDRESS: 427 Midstate Drive
Canonsburg, PA 15317 Clarksburg, WV 25301

WELL OPERATOR: EQT Production Company
ADDRESS: 400 Woodcliff Drive
Canonsburg, PA 15317
DESIGNATED AGENT: Joseph C. Mallow
427 Midstate Drive
Clarkspurg, WV 25301

WELL TYPE: ☐ OIL ☒ GAS ☐ LIQUID INJECTION ☐ WASTE DISPOSAL
(IF GAS) PRODUCTION: ☐ STORAGE ☐ DEEP ☒ SHALLOW

LOCATION: ELEVATION: As-Built: 1318' DISTRICT: Marietta
SURFACE OWNER: Jessie A. Musgrave Akers & Joseph Fore
ROYALTY OWNER: Bonny Minerals, LLC, et al.
PROPOSED WORK: ☒ DRILL ☐ CONVERT ☐ DRILL DEEPER ☐ FRACTURE OR STIMULATE ☐ PLUG OFF OLD FORMATION
☐ PERFORATE NEW FORMATION ☐ OTHER PHYSICAL CHANGE IN WELL (SPECIFY)
☐ PLUG AND ABANDON ☐ CLEAN OUT AND REPLUG TARGET FORMATION: Marcellus ESTIMATED DEPTH: 7,715'


STATE OF WEST VIRGINIA
DEPARTMENT OF ENVIRONMENTAL PROTECTION
OIL AND GAS DIVISION

DATE: July 15, 2024
OPERATOR'S WELL NO.: Carmegie 19H
API WELL NO. 47 - 049 - 02529
STATE COUNTY PERMIT




I, the undersigned, hereby certify that this plat is correct to the best of my knowledge and belief and shows all the information required by law and the regulations issued and prescribed by the Department of Environmental Protection.

P.S. 2092

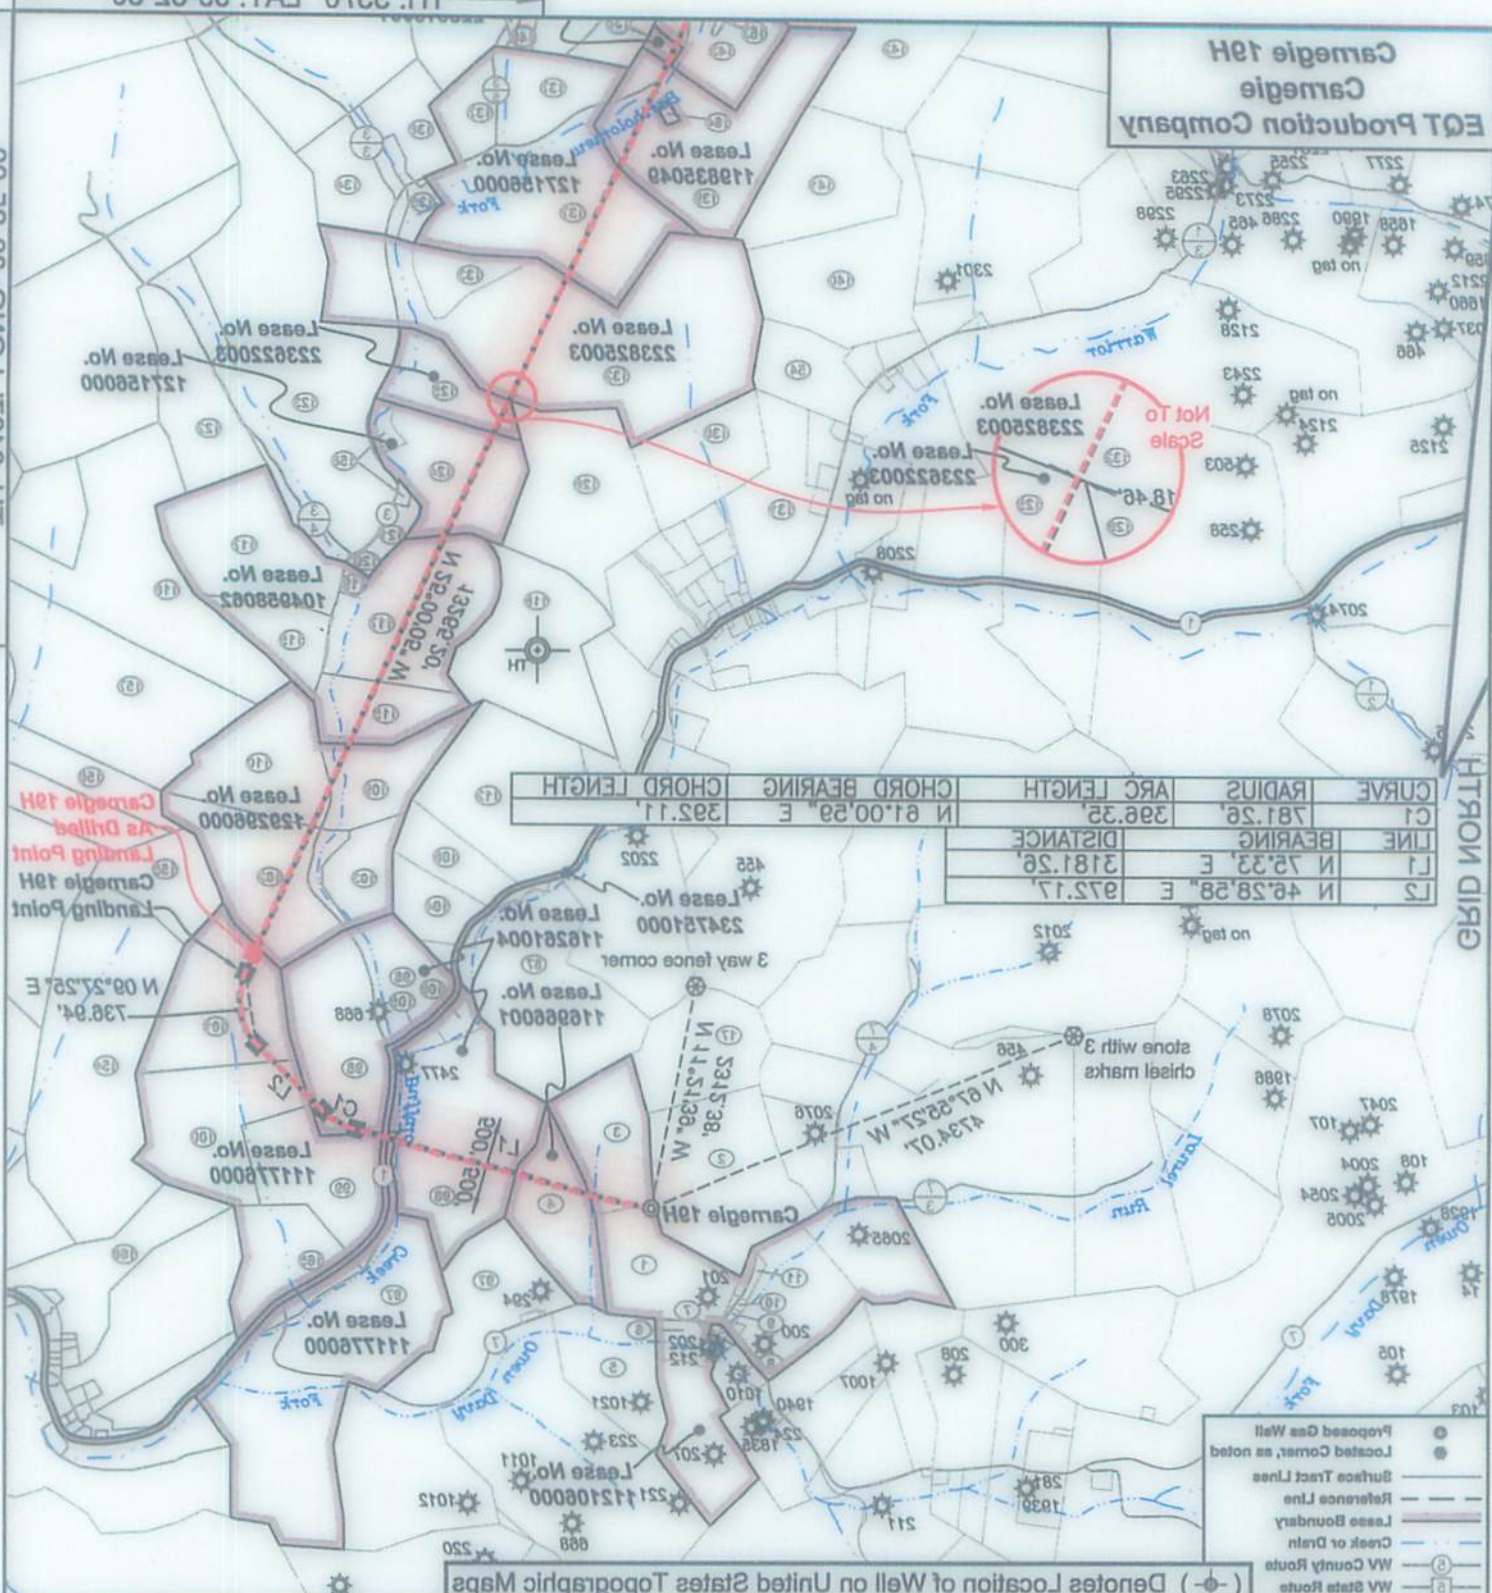


BH: 7225' LONG: 80-25-00

GRID NORTH

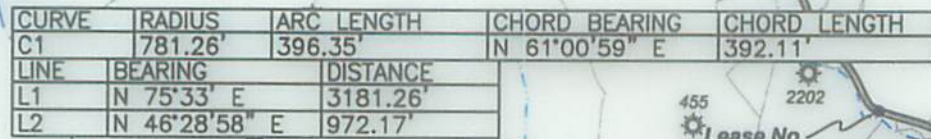

P.S. 2092

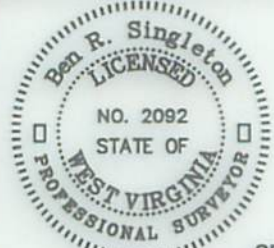

SEAL

STATE OF WEST VIRGINIA
DEPARTMENT OF ENVIRONMENTAL PROTECTION
OIL AND GAS DIVISION

DATE: July 12 2024
 OPERATOR'S WELL NO.: Carnegie 19H
 API WELL NO
47 - 049 - 02529
 STATE COUNTY PERMIT

09/19/2025

WELL OPERATOR: <u>EQT Production Company</u>	DESIGNATED AGENT: <u>Joseph C. Mallow</u>
ADDRESS: <u>400 Woodcliff Drive</u>	ADDRESS: <u>427 Midstate Drive</u>
<u>Canonsburg, PA 15317</u>	<u>Clarksburg, WV 25301</u>

WELL OPERATOR: EQT Production Company

ADDRESS: 400 Woodcote Drive

Canonsburg, PA 15317

DESIGNATED AGENT: Joseph C. Mallow

457 Midstate Drive

Clarkspurg, WV 25301

☐ PLUG AND ABANDON

☐ CLEAN OUT AND REPLUG

☐ TARGET FORMATION: Marcellus

☐ ESTIMATED DEPTH: 7,715'

☐ PERFORATE NEW FORMATION

☐ OTHER PHYSICAL CHANGE IN WELL (SPECIFY)

☒ DRILL DEEPER

☐ FRACTURE OR STIMULATE

☐ PLUG OFF OLD FORMATION

ROYALTY OWNER: Bounty Minerals, LLC, et al.

LEASE NO: 112108000

ACREAGE: 135

SURFACE OWNER: Jeanne A. Musgrave Akers & Joseph Fore

DISTRICT: Mannington

COUNTY: Marion

LOCATION: ELEVATION: 1318'

WATERSHED: Laurel Run of Owen Davy Fork

QUADRANGLE: Glover Gap

WELL TYPE: ☐ OIL ☒ GAS

☐ LIQUID INJECTION

☐ WASTE DISPOSAL

(IF GAS) PRODUCTION: ☐ STORAGE ☐ DEEP ☒ SHALLOW

☐ GAS

☐ LIQUID INJECTION

☐ WASTE DISPOSAL

PROVEN SOURCE OF ELEVATION: NGS CORS Station

1:2500

MINIMUM DEGREE OF ACCURACY: 1"

SCALE: 1" = 200'

DRAWING NO: Carnegie 19H

FILE NO: 95-21

STATE OF WEST VIRGINIA

DEPARTMENT OF ENVIRONMENTAL PROTECTION

OIL AND GAS DIVISION

DATE: July 15, 2024

OPERATOR'S WELL NO.: Carnegie 19H

API WELL NO: 47 - 049 - 05259

STATE COUNTY PERMIT

ALLIANCE SURVEYS, INC.

I, the undersigned, hereby certify that this plat is correct to the best of my knowledge and belief and shows all the information required by law and the regulations issued and prescribed by the Department of Environmental Protection.

P.S. 2092

Ben R. Singleton

LICENSED

NO. 2092


STATE OF WEST VIRGINIA

PROFESSIONAL SURVEYOR

Denotes Location of Well on United States Topographic Maps	WV State Route	WV County Route	Creek or Drain	Lease Boundary	Reference Line	Surface Tract Lines	Located Corner as noted	Proposed Gas Well
Curve	Radius	Arc Length	Chord Bearing	Chord Length	Line	Bearing	Distance	
C1	781.28'	398.35'	N 61.00.59" E	392.11'				
L1	N 75.33' E	3181.28'						
L2	N 46.28.28" E	927.17'						

Carnegie 19H
Carnegie
EQT Production Company

Tract I.D.	Map No.	Parcel No.	County	District	Surface Tract Owner	Acres
1	49	39	Marion	Mannington	Jeanne A. Musgrave Akers & Joseph Forte	26.96
2	49	37	Marion	Mannington	Equitans LP	51.5
3	49	35.1	Marion	Mannington	Jeanne A. Musgrave Akers & Joseph Forte	21.9
4	49	40	Marion	Mannington	Marshall & Dirk Cartright	26
5	50	14	Marion	Mannington	Melvin L. Goudy Sr.	28
6	50	15	Marion	Mannington	Perry R. & Janice M. Thorne	5.61
7	50	16	Marion	Mannington	Richard H. & Lucy M. Lambert	0.46
8	50	17	Marion	Mannington	Jason H. & Brandy L. Batson	0.32
9	48	13	Marion	Mannington	Harlen G. & Diana S. Batson	1.1
10	48	13.2	Marion	Mannington	Dustin Carl	0.73
11	48	13.1	Marion	Mannington	Gary A. & Sheila D. Earl	2.02
17	49	38	Marion	Mannington	Thomas R. Wright	30
54	44	26	Marion	Mannington	Charles P. & Kelly R. Glover	41.05
82	41	1	Marion	Mannington	Walter L. & Peppie L. Upton	58.6/2
87	49	14	Marion	Mannington	Marion County Coal Resources Inc.	61
96	41	20	Marion	Mannington	Joseph A. Tucker	40
97	50	12	Marion	Mannington	Perry R. & Janice M. Thorne	283.83
98	49	12	Marion	Mannington	Robert S. Thorne, Sr., et al.	116.825
99	43	11	Marion	Mannington	Joseph R. & Whitney N. Elliott	39
100	49	47	Marion	Mannington	Joseph R. & Whitney N. Elliott	40.7
101	49	11	Marion	Mannington	Joseph R. & Whitney N. Elliott	38.2
102	49	8	Marion	Mannington	Donald L. & Larayne M. Lafferty	10.21
103	27	14	Marion	Mannington	Kevin M. & Glenda S. Brewer	19.79
104	31	13	Marion	Mannington	Joseph & Larry Baker	22.23
109	49	13	Marion	Mannington	CNK Land LLC	2.59
126	49	12.1	Marion	Mannington	CHK Land LLC	4.175
138	31	13.2	Marion	Mannington	John H. & Carol L. Tennant	13.14
109	37	15	Marion	Mannington	George F. How, Jr.	18.1
110	37	26	Marion	Mannington	Delbert R. Triplett	10.15
112	37	15.1	Marion	Mannington	Larry E. & Patricia Baker	52.28
115	37	16	Marion	Mannington	Marion County Coal Resources Inc.	35
116	37	28	Marion	Mannington	Marion County Coal Resources Inc.	21
117	37	17	Marion	Mannington	Jeffrey H. Michael	86.04
118	37	10	Marion	Mannington	Kevin D. & Heather Glasscock	51
119	37	17.1	Marion	Mannington	Ronald C. & Betty L. Michael	1.49
120	37	22.3	Marion	Mannington	Ronald C. & Betty L. Michael	1.5
121	37	22.1	Marion	Mannington	Ronald C. & Betty L. Michael	5.17
122	37	29	Marion	Mannington	Jeffrey H. Michael	38.9
123	37	27	Marion	Mannington	Jeffrey H. Michael	106.83
124	37	18	Marion	Mannington	Tommy L. & Tam A. Snodgrass	31.66
125	37	20	Marion	Mannington	No Patent Information	NA
126	37	3	Marion	Mannington	Kevin D. & Heather Glasscock	49.25
130	37	23	Marion	Mannington	Rosemary A. & Samuel M. Snodgrass	2.83
131	44	77	Marion	Mannington	Daniel Reinken	36.236
132	37	21	Marion	Mannington	Cynthia M. & Kim S. Tilley	1.35
137	37	21.1	Marion	Mannington	Julie A. Littley & Justin K. Cain	11.1/1
134	38	13.1	Marion	Mannington	Christine L. Fagnier, et al.	10.76
135	38	13.2	Marion	Mannington	Christine L. Fagnier, et al.	7
136	38	13.3	Marion	Mannington	Christine L. Fagnier, et al.	15.87
137	44	1	Marion	Mannington	Edna M. Cain	107.5
138	44	3	Marion	Mannington	Thomas E. & Andrea G. Ryan	1
139	44	4	Marion	Mannington	Richard L. Cain	54.33
140	44	24.1	Marion	Mannington	Bel of The Most Worshipful Grd Log of A' & AMWV	43.56
141	44	24	Marion	Mannington	Stratford LTD	86.17
142	44	6	Marion	Mannington	John D. & Raji K. Carson	55
143	44	5	Marion	Mannington	Thomas E. & Andrea G. Ryan	24.51
144	38	9	Marion	Mannington	Thomas E. & Andrea G. Ryan	63
145	38	10	Marion	Mannington	Thomas E. & Andrea G. Ryan	175.15
146	38	20.1	Marion	Mannington	Michael L. & Laura A. Gorbey	1.15
147	38	11	Marion	Mannington	Yulia Nikitavna	115
148	38	8	Marion	Mannington	John D. & Raji K. Carson	64.56
149	38	8.1	Marion	Mannington	John D. & Raji K. Carson	2.40
150	44	8	Marion	Mannington	Charles D. & June Shaver	16.5
151	44	7	Marion	Mannington	Charles D. & June Shaver	19
152	44	9	Marion	Mannington	Charles D. & June Shaver	19
153	44	10	Marion	Mannington	Charles D. & June Shaver	128.75
154	42	10	Marion	Mannington	Harrison County Coal Resources Inc.	102.8
155	49	9	Marion	Mannington	Derek Nisum	33.75
156	49	7	Marion	Mannington	Willie E. & Pelly R. Anderson	30
157	37	27	Marion	Mannington	Harrison County Coal Resources Inc.	35.5
158	37	19	Marion	Mannington	Gary F. Snodgrass	3.61
159	38	6	Marion	Mannington	Thomas R. & Margaret M. Williams	11.19
160	44	5.1	Marion	Mannington	Thomas E. & Andrea G. Ryan	0.49
164	44	4.1	Marion	Mannington	Matthew T. Cain	0.67
166	50	11	Marion	Mannington	Joseph R. & Whitney N. Elliott	27.082
166	49	54	Marion	Mannington	Janice C. Drusil	48.21
167	42	18	Marion	Mannington	Nathaniel C. Hilden	34.4
168	44	16	Marion	Mannington	Charles D. & June Shaver	30
169	44	15	Marion	Mannington	Charles D. & June Shaver	30
170	44	11	Marion	Mannington	Charles D. & June Shaver	37.79

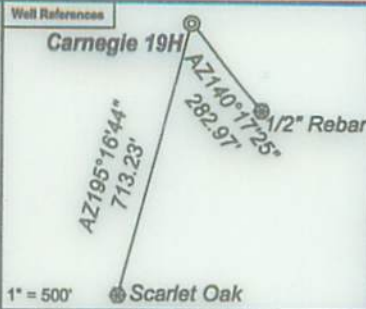


As Drilled Well Information:
Carnegie 19H coordinates are
NAD 27 N: 374,337.69 E: 1,735,852.98
NAD 83 UTM N: 4,375,088.77 E: 548,456.59
Carnegie 19H Landing Point coordinates are
NAD 27 N: 376,924.93 E: 1,740,018.44
NAD 83 UTM N: 4,375,898.18 E: 549,712.53
Carnegie 19H Bottom Hole coordinates are
NAD 27 N: 388,666.90 E: 1,734,530.93
NAD 83 UTM N: 4,379,447.66 E: 547,981.13
West Virginia Coordinate system of 1927 (North Zone)
based upon Differential GPS Measurements.
Plat orientation, corner and well ties are based upon
the grid north meridian.
Well location references are based upon the grid north
meridian.
UTM coordinates are NAD83, Zone 17, Meters.

Carnegie

● Carnegie 19H
● Carnegie 17H
● Carnegie 15H
● Carnegie 13H
● Carnegie 11H
● Carnegie 9H
● Carnegie 7H
● Carnegie 5H
● Carnegie 3H
● Carnegie 1H

Lease No.	Owner	Acres
112106000	Bounty Minerals, LLC, et al.	135
116986001	Judith Ann Myers, et al.	36
116261004	Sarahbeth Lamm, et al.	123
234751000	West Virginia Department of Transportation, Division of Highways	46.88
111776000	Joseph R. Elliott and Whitney N. Elliott, et al.	250
128296000	Lee and Hall Royalties	119.25
104958002	Country Roads Minerals, LLC, et al.	174
127156000	EQT Production Company, et al.	34.75 & 0.5
223622003	Ferrari VI OG, LLC, et al.	18
223825003	Bradley W. Thomas, et al.	141
127156000	EQT Production Company, et al.	66.5 & 34.25
119635049	Lee and Hall Royalties, et al.	55 of 226.45 lease
228818001	Charles L. Castor, Jr., et al.	1
127156000	EQT Production Company, et al.	26
100146000	Alice Lou Schomer, et al.	21.75
118823006	June Shaver, et al.	22.25
105544000	Ridgetop ELEVEN LLC	128.75

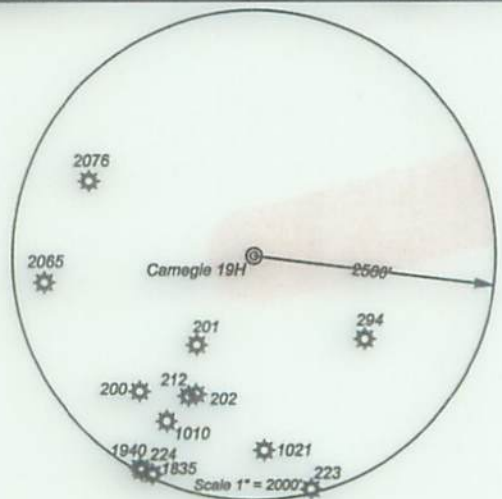

I, the undersigned, hereby certify that this plat is correct to the best of my knowledge and belief and shows all the information required by law and the regulations issued and prescribed by the Department of Environmental Protection.

Ben R. Singleton
P.S. 2092



SEAL

FILE NO: 92-21
DRAWING NO: Carnegie 19H
SCALE: 1" = 2000'
MINIMUM DEGREE OF ACCURACY: 1:2500
PROVEN SOURCE OF ELEVATION: NGS CORS Station

STATE OF WEST VIRGINIA
DEPARTMENT OF ENVIRONMENTAL PROTECTION
OIL AND GAS DIVISION


DATE: July 12 20 24
OPERATOR'S WELL NO.: Carnegie 19H
API WELL NO
47 - 049 - 02529
STATE COUNTY PERMIT

WELL TYPE: ☐ OIL ☒ GAS ☐ LIQUID INJECTION ☐ WASTE DISPOSAL
(IF GAS) PRODUCTION: ☐ STORAGE ☐ DEEP ☒ SHALLOW
LOCATION: ELEVATION: As-Built: 1318' WATERSHED: Laurel Run of Owen Davy Fork QUADRANGLE: Glover Gap
DISTRICT: Mannington COUNTY: Marion
SURFACE OWNER: Jeanne A. Musgrave Akers & Joseph Forte ACREAGE: 28.96
ROYALTY OWNER: Bounty Minerals, LLC, et al. LEASE NO: 112106000 ACREAGE: 135
PROPOSED WORK: ☒ DRILL ☐ CONVERT ☐ DRILL DEEPER ☒ FRACTURE OR STIMULATE ☐ PLUG OFF OLD FORMATION
☐ PERFORATE NEW FORMATION ☐ OTHER PHYSICAL CHANGE IN WELL (SPECIFY)
☐ PLUG AND ABANDON ☐ CLEAN OUT AND REPLUG TARGET FORMATION: Marcellus ESTIMATED DEPTH: 7,712'

WELL OPERATOR: EQT Production Company DESIGNATED AGENT: Joseph C. Mallow
ADDRESS: 400 Woodcliff Drive ADDRESS: 427 Midstate Drive
Canonsburg, PA 15317 Clarksburg, WV 25301

EQT Production Company
Carnegie
Carnegie 19H


Index	Lot	Acres	County	Owner
1	28	0.00	Marion	Marion
2	29	0.00	Marion	Marion
3	30	0.00	Marion	Marion
100	127	0.00	Marion	Marion

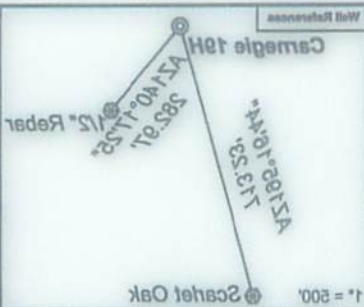

UTM coordinates are NAD83, Zone 17, Meters.
Well location references are based upon the grid north
the grid north meridian.
Based upon Differential GPS Measurements.
West Virginia Coordinate system of 1983 (North Zone)
NAD 83 UTM N: 4,370,447.88 E: 547,881.13
NAD 83 UTM N: 4,370,447.88 E: 547,881.13
Carnegie 19H Bottom Hole coordinates are
NAD 83 UTM N: 4,370,447.88 E: 547,881.13
Carnegie 19H Landing Point coordinates are
NAD 83 UTM N: 4,370,447.88 E: 547,881.13
Carnegie 19H coordinates are
NAD 83 UTM N: 4,370,447.88 E: 547,881.13
As Drilled Well Information:

- ① Carnegie 19H
- ② Carnegie 17H
- ③ Carnegie 15H
- ④ Carnegie 13H
- ⑤ Carnegie 11H
- ⑥ Carnegie 9H
- ⑦ Carnegie 7H
- ⑧ Carnegie 5H
- ⑨ Carnegie 3H
- ⑩ Carnegie 1H

Acres	Owner	Lease No.
178	Bounty Minerals, LLC, et al.	112108000
36	Liberty Ann Myers, et al.	110880001
173	Samuel Lamm, et al.	110881004
48.88	West Virginia Department of Transportation, Division of Highways	234781000
250	Joseph R. Elliott and Whitney N. Elliott, et al.	111778000
119.25	Lee and Hall Royalties	125288000
174	County Roads Minerals, LLC, et al.	104888002
34.75 & 0.5	EQT Production Company, et al.	127188000
18	Farm VI OG, LLC, et al.	233823003
141	Bridley W. Thomas, et al.	233825003
88.5 & 34.25	EQT Production Company, et al.	127188000
55 of 228.45 acres	Lee and Hall Royalties, et al.	110880001
1	Charles L. Castor, Jr., et al.	233818001
28	EQT Production Company, et al.	127188000
21.75	Alice Lou Schomer, et al.	100148000
22.25	June Shaver, et al.	110823008
128.75	Ridgely ELVEN LLC	108440000

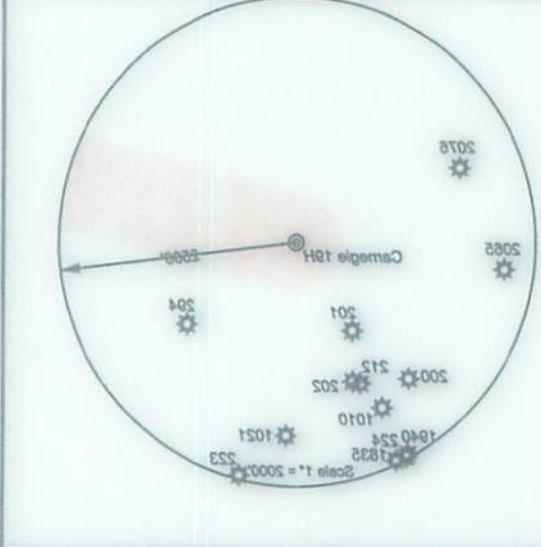

I, the undersigned, hereby certify that this plat is correct to the best of my knowledge and belief and shows all the information required by law and the regulations issued and prescribed by the Department of Environmental Protection.



FILE NO.: 95-24	DRAWING NO.: Carnegie 19H	SCALE: 1" = 200'	MINIMUM DEGREE OF ACCURACY: 1:2500	PROVEN SOURCE OF ELEVATION: NGS CORS Station
WELL TYPE: ☐ OIL ☐ GAS ☐ LIQUID INJECTION ☐ WASTE DISPOSAL				
(IF GAS) PRODUCTION: ☐ STORAGE ☐ DEEP ☒ SHALLOW				
LOCATION: As-Built: 1318' WATERSHED: Laurel Run of Owen Davy Fork QUADRANGLE: Glover Gap				
DISTRICT: Marion COUNTY: Marion				
SURFACE OWNER: Jeanne A. Mustave Akers & Joseph Fore				
ROYALTY OWNER: Bounty Minerals, LLC, et al.				
PROPOSED WORK: ☒ DRILL ☐ CONVERT ☐ DRILL DEEPER ☐ FRACTURE OR STIMULATE ☐ PLUG OFF OLD FORMATION				
☐ PERFORATE NEW FORMATION ☐ OTHER PHYSICAL CHANGE IN WELL (SPECIFY)				
☐ PLUG AND ABANDON ☐ CLEAN OUT AND REPLUG TARGET FORMATION: Marcellus ESTIMATED DEPTH: 7,715'				
WELL OPERATOR: EQT Production Company				
ADDRESS: 400 Woodcliff Drive				
Carnersburg, PA 15317				
DESIGNATED AGENT: Joseph C. Mallow				
ADDRESS: 427 Midstate Drive				
Clarksburg, WV 25301				
STATE: COUNTY: PERMIT: 02529				
API WELL NO: 47 - 049 - 02529				
OPERATOR'S WELL NO.: Carnegie 19H				
DATE: July 15 20				