


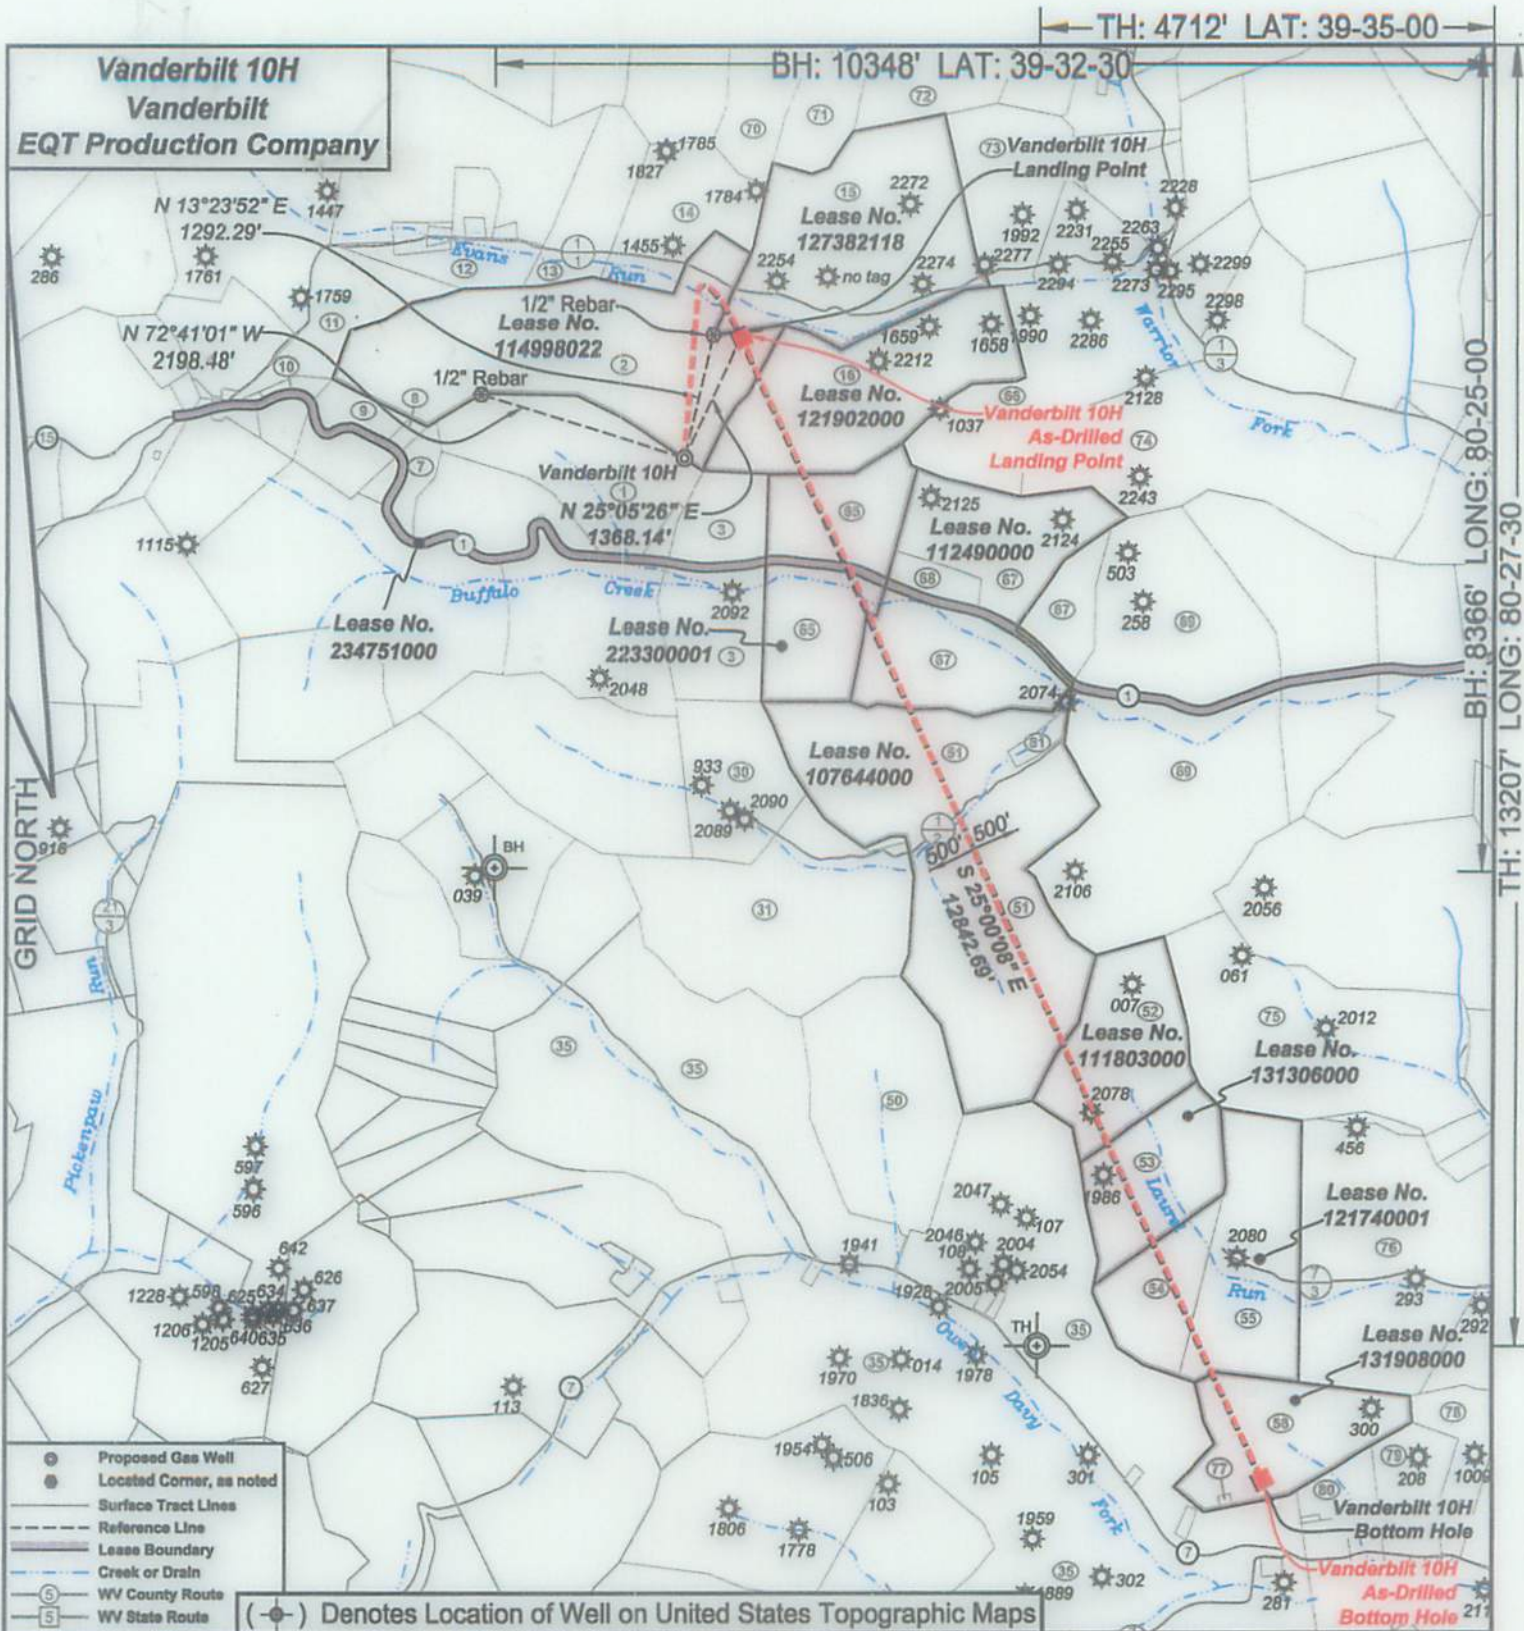

I, the undersigned, hereby certify that this plat is correct to the best of my knowledge and belief and shows all the information required by law and the regulations issued and prescribed by the Department of Environmental Protection.

Ben R. Singleton

P.S. 2092



SEAL

FILE NO: 93-21

DRAWING NO: Vanderbilt 10H

SCALE: 1" = 2000'

MINIMUM DEGREE OF ACCURACY:
1:2500

PROVEN SOURCE OF ELEVATION:
NGS CORS Station

STATE OF WEST VIRGINIA
DEPARTMENT OF ENVIRONMENTAL PROTECTION
OIL AND GAS DIVISION

DATE: January 20 20 25

OPERATOR'S WELL NO.: Vanderbilt 10H

API WELL NO

47 - 049 - 02538
STATE COUNTY PERMIT

WELL TYPE: ☐ OIL ☒ GAS ☐ LIQUID INJECTION ☐ WASTE DISPOSAL

(IF GAS) PRODUCTION: ☐ STORAGE ☐ DEEP ☒ SHALLOW

LOCATION: ELEVATION: As-Built: 1358' WATERSHED: Evans Run & Buffalo Creek QUADRANGLE: 09/19/2025

DISTRICT: Mannington COUNTY: Marion

SURFACE OWNER: EQT Production Company ACREAGE: 125.73

ROYALTY OWNER: Bounty Minerals, LLC, et al. LEASE NO: 114998022 ACREAGE: 125.73

PROPOSED WORK: ☒ DRILL ☐ CONVERT ☐ DRILL DEEPER ☒ FRACTURE OR STIMULATE ☐ PLUG OFF OLD FORMATION
☐ PERFORATE NEW FORMATION ☐ OTHER PHYSICAL CHANGE IN WELL (SPECIFY)

☐ PLUG AND ABANDON ☐ CLEAN OUT AND REPLUG TARGET FORMATION: Marcellus ESTIMATED DEPTH: 7,735'

WELL OPERATOR: EQT Production Company

DESIGNATED AGENT: Joseph C. Mallow

ADDRESS: 400 Woodcliff Drive

ADDRESS: 115 Professional Place PO Box 280



Canonsburg, PA 15317

Bridgeport, WV 26330

Vanderbilt 10H
Vanderbilt
EQT Production Company

Tract I.D.	TexMap No.	Parcel No.	County	District	Surface Tract Owner	Acres
1	45	11	Marion	Mannington	Larry D. & Trisha B. Higgins	60
2	45	17	Marion	Mannington	EQT Production Company	125.73
3	45	5	Marion	Mannington	Harry R. & Susanne M. Morris	52
7	45	13	Marion	Mannington	Thelma L. Coben	11
8	45	14.2	Marion	Mannington	Thelma L. Coben	1.6
9	45	14.1	Marion	Mannington	Patricia F. Powell	8.59
10	45	14.4	Marion	Mannington	Thomas A. & Karen J. Hbenbaugh	3
11	45	16	Marion	Mannington	Keith A. Powell	27.29
12	45	26	Marion	Mannington	John M. Proffitt, Sr.	14.6
13	45	25.1	Marion	Mannington	Richard K. & Dawn K. Jones	5.71
14	45	24	Marion	Mannington	Barbara E. Henderson, et al.	38.5
15	45	23	Marion	Mannington	Thomas L. Shodgrass	105.5
16	45	20	Marion	Mannington	EQT Production Company	78.5
30	46	6.1	Marion	Mannington	Patricia A. Cotheman	40
31	46	6	Marion	Mannington	Patricia A. Cotheman	100
35	46	2	Marion	Mannington	Marion County Commission	844.34
50	46	4	Marion	Mannington	Mike Ross Inc	67.47
51	46	5	Marion	Mannington	Ruby L. Herndon	182.04
52	48	1	Marion	Mannington	David L. & Karla A. James	56.5
53	48	2	Marion	Mannington	EQT Production Company	40
54	48	3	Marion	Mannington	Mark A. Barron	27.5
55	48	4	Marion	Mannington	Mark A. Barron	57
56	48	5	Marion	Mannington	Marion County Coal Resources Inc.	46.83
65	45	10	Marion	Mannington	Lisa A. & Baron R. Powell	68
66	45	21	Marion	Mannington	Vickie E. Lucas	103.19
67	45	9	Marion	Mannington	Jaffrey B. & Pamela J. Gray	107.28
68	45	6.1	Marion	Mannington	Barron R. & Mary A. Powell	8
69	45	8	Marion	Mannington	Sharon A. Grim	185.96
70	43	2	Marion	Mannington	Gary E. & Alice E. Young	37.2
71	43	1	Marion	Mannington	Wilbert & Alberta Higgins	32.5
72	42	7	Marion	Mannington	Sharon A. Grim	33
73	45	22	Marion	Mannington	Thomas L. Shodgrass	44.43
74	44	37	Marion	Mannington	Priscilla A. Hamilton	157.3
75	46	18	Marion	Mannington	Jason D. Beatty, et al.	101.25
76	46	17	Marion	Mannington	George A. & Ada D. Stahl	117.5
77	46	5.1	Marion	Mannington	County Commission of Marion County	0.36
78	46	8	Marion	Mannington	Timothy & Tonya Haight	18.18
79	46	7	Marion	Mannington	Marion County Coal Resources Inc.	26.61
80	46	6	Marion	Mannington	Marion County Coal Resources Inc.	19.34
81	46	5.1	Marion	Mannington	Nancy A. & Tracy R. Powell	2.96

As-Drilled Well Information:
Vanderbilt 10H coordinates are
NAD 27 N: 382,858.87 E: 1,725,047.22
NAD 83 UTM N: 4,377,629.98 E: 545,121.25
Vanderbilt 10H Landing Point coordinates are
NAD 27 N: 384,080.10 E: 1,725,649.80
NAD 83 UTM N: 4,378,005.08 E: 545,298.64
Vanderbilt 10H Bottom Hole coordinates are
NAD 27 N: 372,469.42 E: 1,731,074.41
NAD 83 UTM N: 4,374,495.29 E: 547,010.20
West Virginia Coordinate system of 1927 (North Zone)
based upon Differential GPS Measurements.
Plat orientation, corner and well ties are based upon
the grid north meridian.
Well location references are based upon the grid north
meridian.
UTM coordinates are NAD83, Zone 17, Meters.

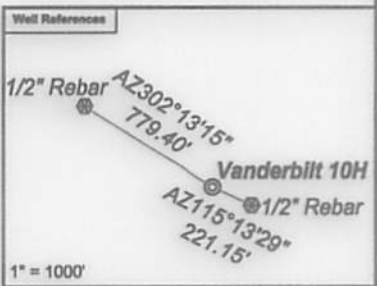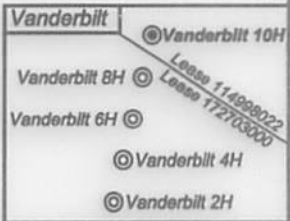

Lease No.	Owner	Acres
114998022	Bounty Minerals, LLC, et al.	125.73
127382118	Regina C. Evans, et al.	105.5
121902000	Timothy D. Gooch	78.5
223300001	Lee and Hall Royalties, et al.	68
234751000	West Virginia Department of Transportation, Division of Highways	46.86
112490000	Ridgetop Appalachia LLC, et al.	108
107644000	XTO Energy, Inc.	185
111803000	Country Roads Minerals LLC, et al.	56
131306000	EQT Production Company	40
121740001	EQT Production Company, et al.	84
131908000	Bounty Minerals, LLC	48

