


SURFACE HOLE DEC. LONG: 80.131474
SURVEYED LONG: 80°07'53.3"

1,820'

Latitude: 39° 37' 30" (NAD27)


Longitude: 80° 07' 30" (NAD27)

14,370'

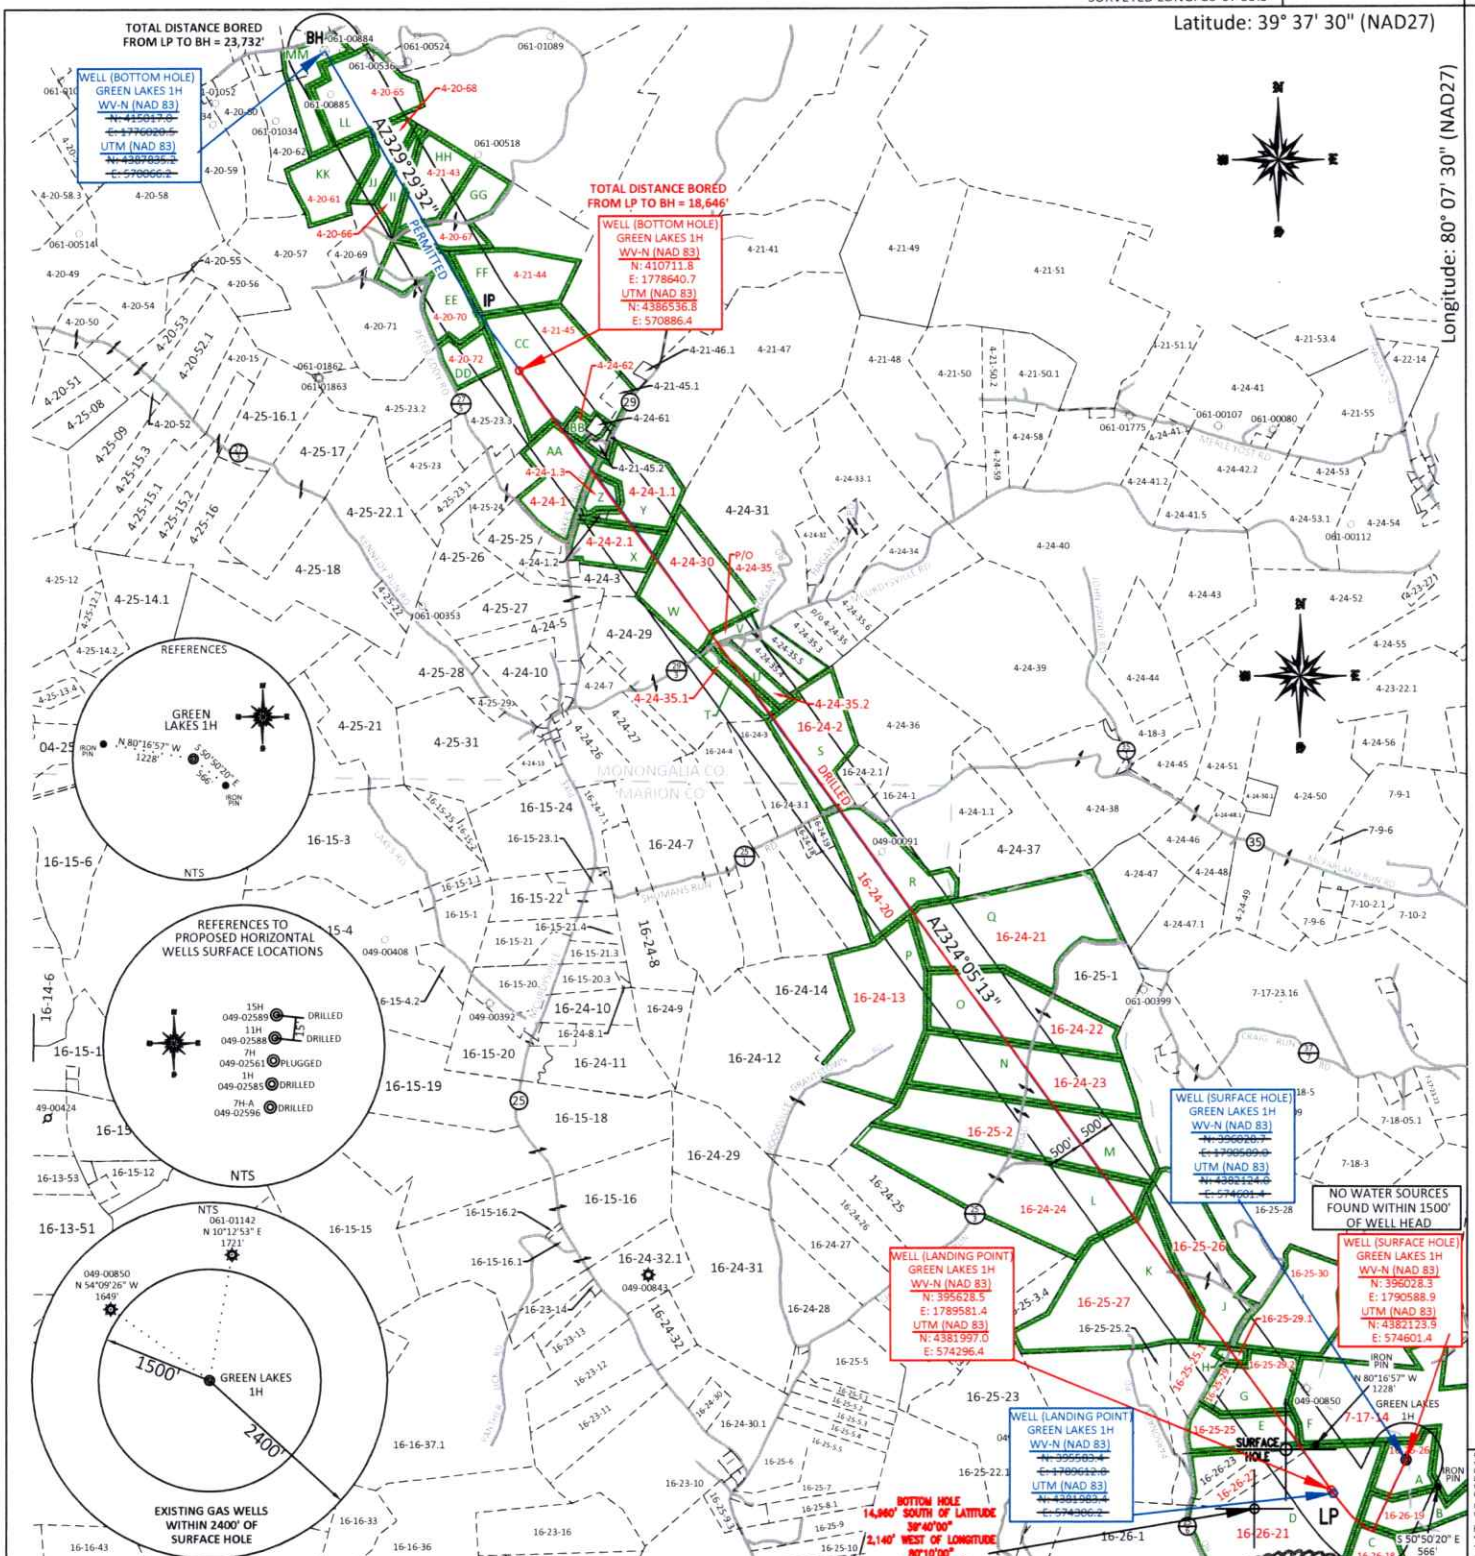

FILE #: NNE20
DRAWING #: 4054
SCALE: PLAT: 1" = 2700'
TICK: 1" = 2000'
MINIMUM DEGREE OF ACCURACY: 1/200
PROVEN SOURCE OF ELEVATION: SUBMETER MAPPING GRADE GPS

I, THE UNDERSIGNED, HEREBY CERTIFY THAT THIS PLAT IS CORRECT TO THE BEST OF MY KNOWLEDGE AND BELIEF AND SHOWS ALL THE INFORMATION REQUIRED BY LAW AND THE REGULATIONS ISSUED AND PRESCRIBED BY THE DEPARTMENT OF ENVIRONMENTAL PROTECTION.
Signed:
L.L.S. #2124 : Ernest J. Benchek III

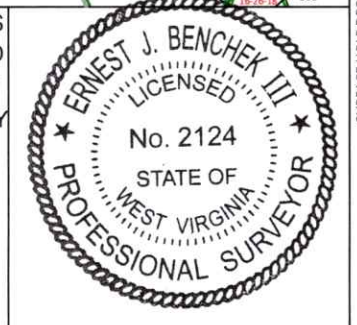

(+) DENOTES LOCATION OF WELL ON UNITED STATES TOPOGRAPHIC MAPS
WVDEP
OFFICE OF OIL & GAS
601 57TH STREET
CHARLESTON, WV 25304
Well Type: ☐ Oil ☐ Waste Disposal ☐ Production ☐ Deep
☒ Gas ☐ Liquid Injection ☐ Storage ☒ Shallow
WATERSHED: Upper Monongahela River
COUNTY/DISTRICT: MONONGALIA CO., GRANT DISTRICT / MARION CO., PAW PAW DISTRICT
SURFACE OWNER: Ministers Run Property Management LLC
OIL & GAS ROYALTY OWNER: Luther E. Howell and Nettie E. Howell
LEASE NUMBERS:
DATE: APRIL 3, 2026
OPERATOR'S WELL #: GREEN LAKES 1H (AS-DRILLED)
API WELL #: 47 49 02585
STATE COUNTY PERMIT
AS-BUILT ELEVATION: 1,448.7'
QUADRANGLE: GRANT TOWN
ACREAGE: 1235.47
ACREAGE: 12.97 +/-
08/28/2026
DRILL ☒ CONVERT ☐ DRILL DEEPER ☐ REDRILL ☐ FRACTURE OR STIMULATE ☒
PLUG OFF FORMATION ☐ PERFORATE NEW FORMATION ☐ PLUG & ABANDON ☐
CLEAN OUT & REPLUG ☐ OTHER CHANGE ☐ (SPECIFY):
TARGET FORMATION: MARCELLUS
WELL OPERATOR: NORTHEAST NATURAL ENERGY LLC
ADDRESS: 707 VIRGINIA STREET EAST, SUITE 1200
CITY: CHARLESTON STATE: WV ZIP CODE: 25301
DESIGNED AGENT: JOHN ADAMS
ADDRESS: 707 VIRGINIA STREET EAST, SUITE 1200
CITY: CHARLESTON STATE: WV ZIP CODE: 25301


	PROPERTY INDEX
4-20-72	ROBERT JAMES BUCHANAN
4-20-70	ARTHUR L & SANDRA R MAIN
4-20-68	RICHARD L & LINDA K EDDY
4-20-67	SAMUEL A & RACHEL HOLMES
4-20-66	ARTHUR L & SANDRA R MAIN
4-20-65	P BRETT & FRANCI M KENNEY
4-20-61	WILLIAM W KNISLEY JR & RACHEL L KNISLEY
4-21-45	BRAD A EDDY
4-21-44	RANDY B EDDY ET AL
4-21-43	SAMUEL A & RACHEL RAE HOLMES
4-24-62	TRAVIS R & JESSICA N FRANKHOUSER
4-24-30	DAVID E EDDY
4-24-1.3	GARY L & KRISTEN K GROSS
4-24-1	EVELYN F FURBEE
4-24-2.1	ROBERT E & SHARON J WILMOTH
4-24-1.1	RAYMOND J EBNER III
4-24-35.2	ROBERT E HARRIS
4-24-35.1	MARIAN M & PAUL E LAWSON
4-24-35	SUNDAY BERRY, KAREN BELL, TAMMY COUGER, FRANK HARRIS, JODY HARRIS & JESSIE HARRIS
16-24-24	WILLIAM R & JONNETT D BRAGG
16-24-23	GENE J & LORENA M BRAGG
16-24-22	VINCENT & LEE ATTARDI
16-24-21	GENE J BRAGG (1/2 INT)
16-24-20	WALTER S & LLOYD W MUNDELL
16-24-13	STEVE J KISH SR ETAL
16-24-2	CHRISTOPHER M & STEFANIE P HINES
16-25-30	CALVIN F PLYMALE
16-25-29.2	JAMES W BURTON III
16-25-29.1	JAMES W BURTON III
16-25-29	WRIGHT P BOWEN
16-25-27	RICHARD STEPHEN MICHAEL
16-25-26	JAMES W BURTON III
16-25-25.1	TRAVIS L & KATIE F DAVIS
16-25-25	HEATHER ALKIRE
16-26-22	JERRY G & SHARON D SISLER
16-25-2	WILLIAM R & JONNETTE D BRAGG
16-26-26	MINISTERS RUN PROPERTY MANAGEMENT LLC
16-26-21	JERRY G & SHARON D SISLER
16-26-18	GARY W DAYTON
16-26-19	GARY W DAYTON
7-17-14	ALICE J BELL

	LEASE INDEX	
A	WV-049-106675-001	U WV-061-004363-002
B	WV-049-106358-001	V WV-061-006482-001
C	WV-049-106358-001	W WV-061-006618-001
D	WV-049-106380-001	X WV-061-002157-003
E	WV-049-106638-007	Y WV-061-006147-001
F	WV-049-106675-001	Z WV-061-004967-000
G	WV-049-106552-006	AA WV-061-006716-001
H	WV-049-106596-002	BB WV-061-005104-000
I	WV-049-106637-001	CC WV-061-006152-001
J	WV-049-106457-001	DD WV-061-003015-015
K	WV-049-104417-002	EE WV-061-004563-000
L	WV-049-105165-001	FF WV-061-003869-005
M	WV-049-106604-002	GG WV-061-004224-001
N	WV-049-104202-019	HH WV-061-005556-001
OW	WV-061-000211-001-LOI	II WV-061-005569-001
P	WV-049-1061392-004	JJ WV-061-005557-001
Q	WV-049-104146-004	KK WV-061-005161-098
R	WV-049-006485-001	LL WV-061-005480-007
S	WV-049-004609-049	MM WV-061-800040-001
T	WV-061-001930-003	

08/28/2026

FILE #: NEE20	DATE: APRIL 3, 2026
DRAWING #: 4054	OPERATOR'S WELL #: GREEN LAKES 1H
SCALE: N/A	API WELL #: 47 49 02585 STATE COUNTY PERMIT

WELL NAME: GREEN LAKES 1H
GRANT TOWN & BLACKSVILLE

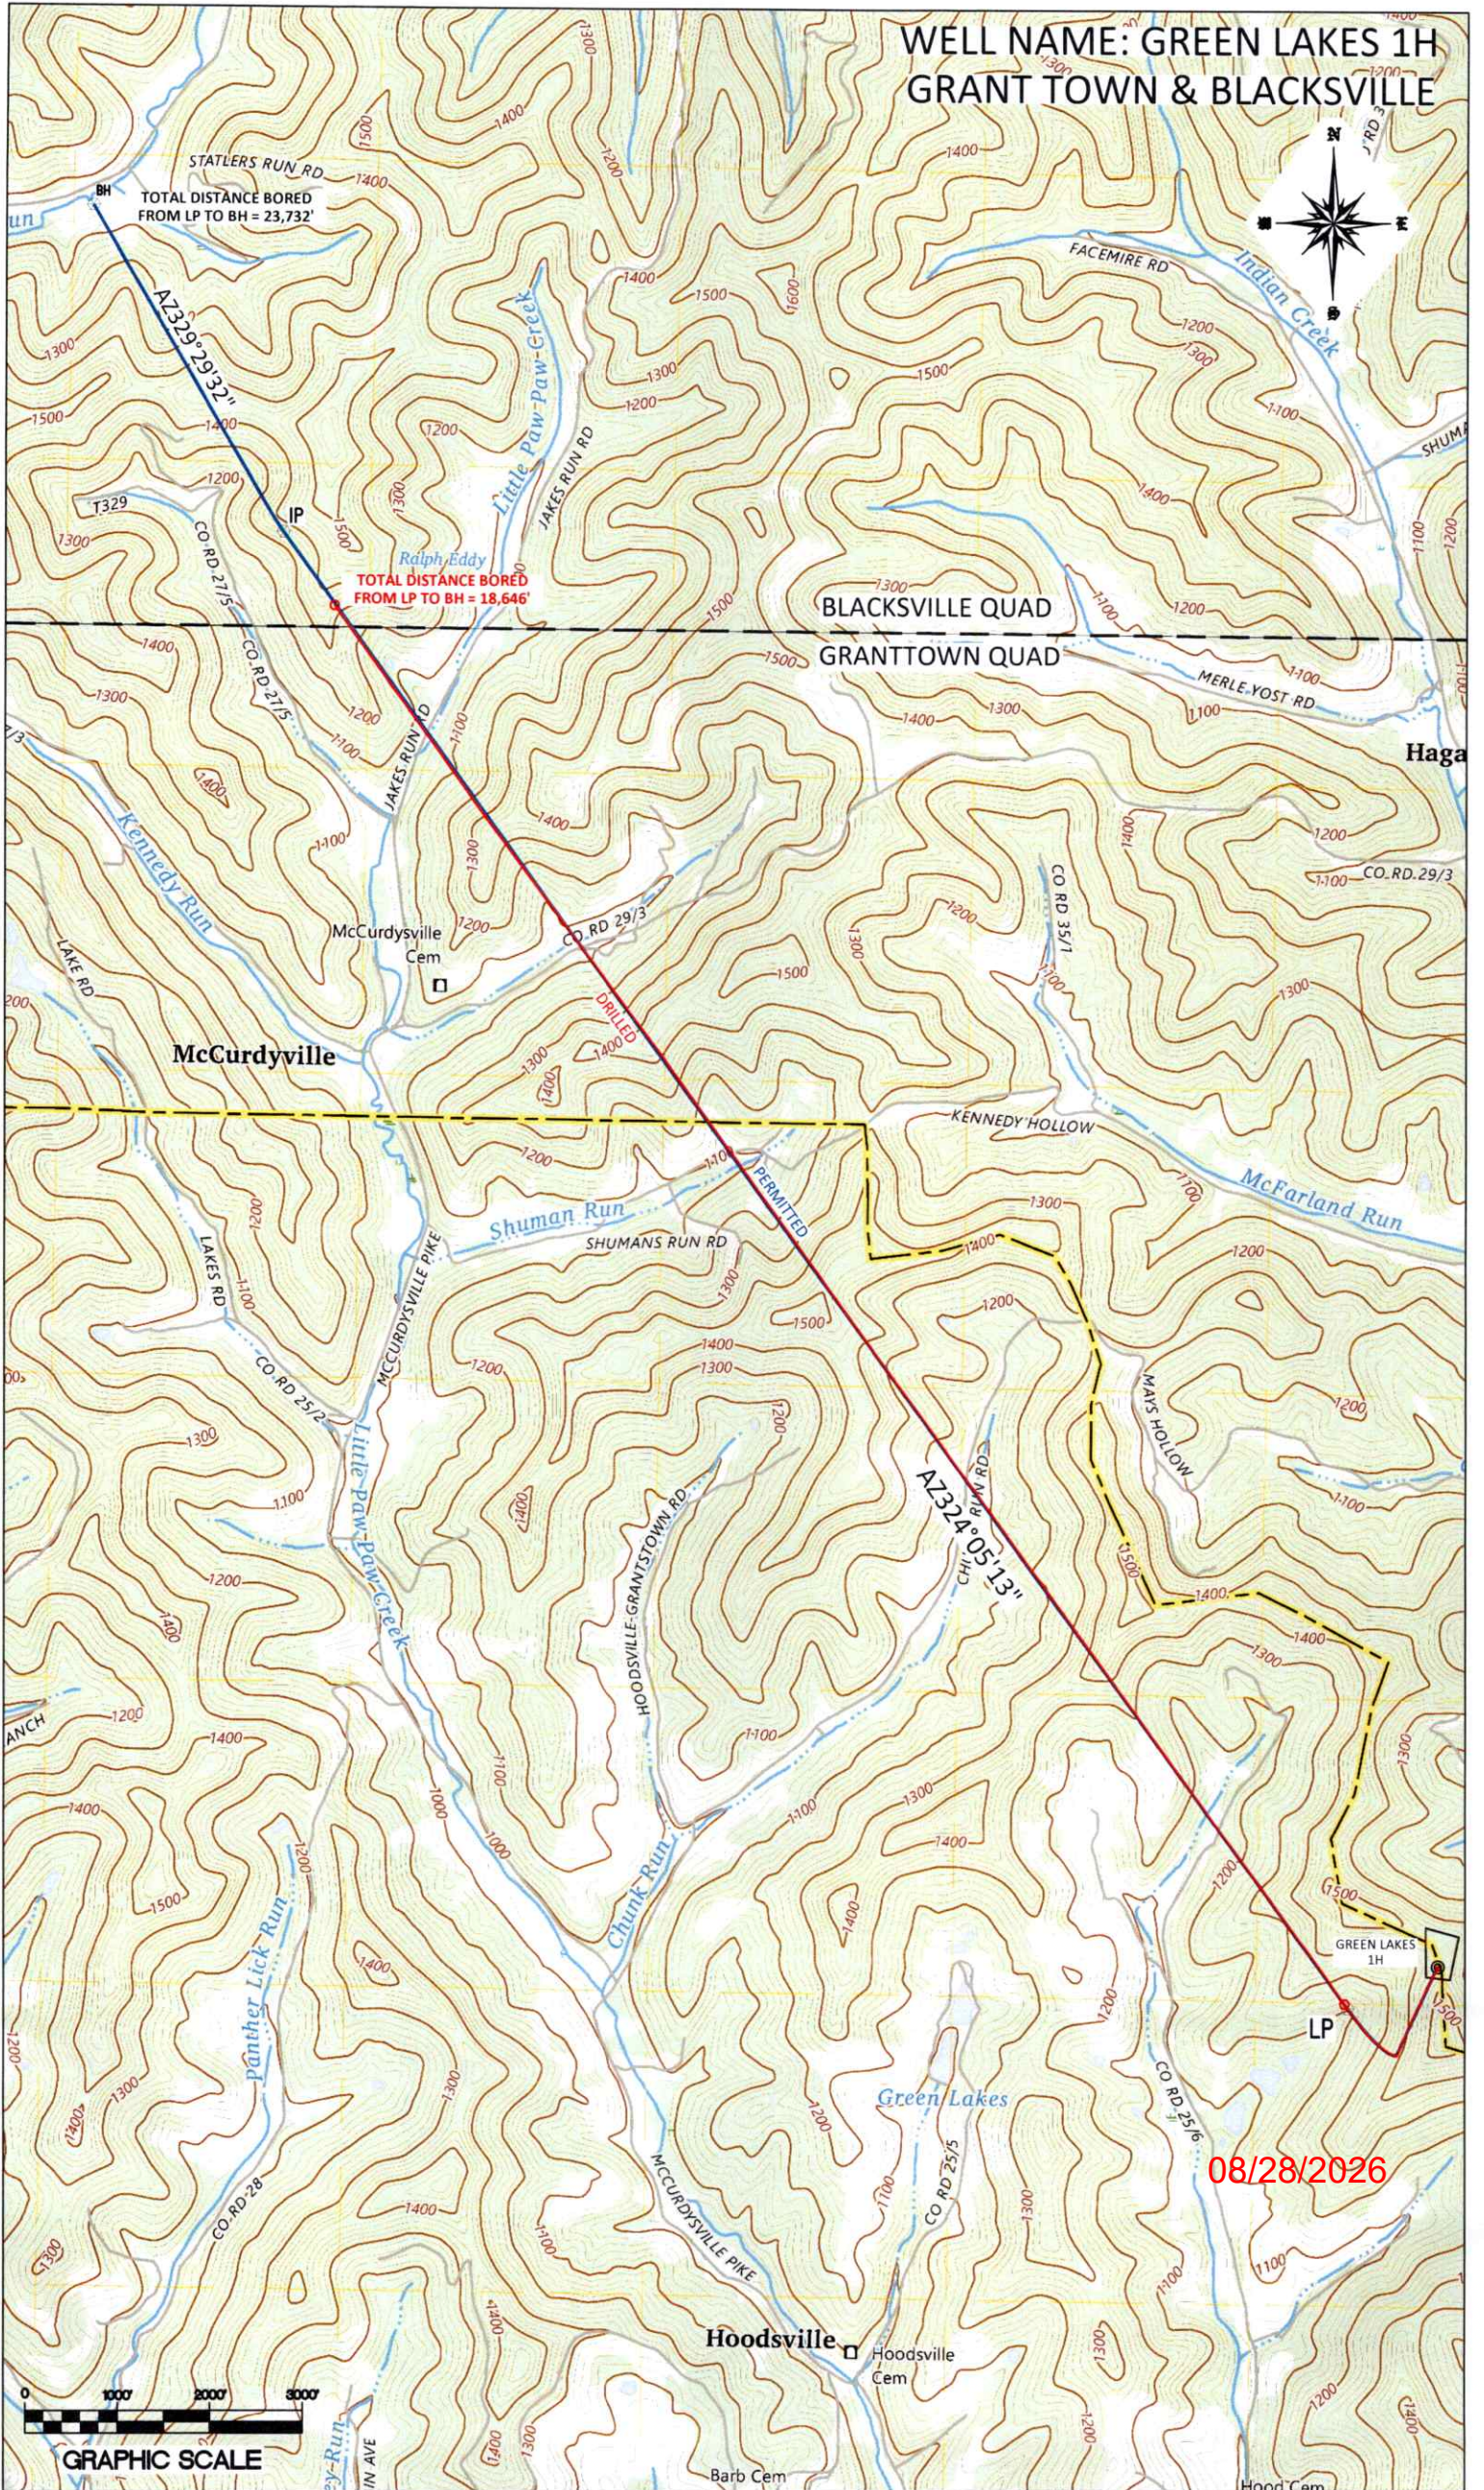

Ralph Eddy
TOTAL DISTANCE BORED
FROM LP TO BH = 18,646'

TOTAL DISTANCE BORED
FROM LP TO BH = 23,732'

BLACKSVILLE QUAD

GRANTTOWN QUAD

McCurdyville

Hoodsville

08/28/2026



GRAPHIC SCALE