


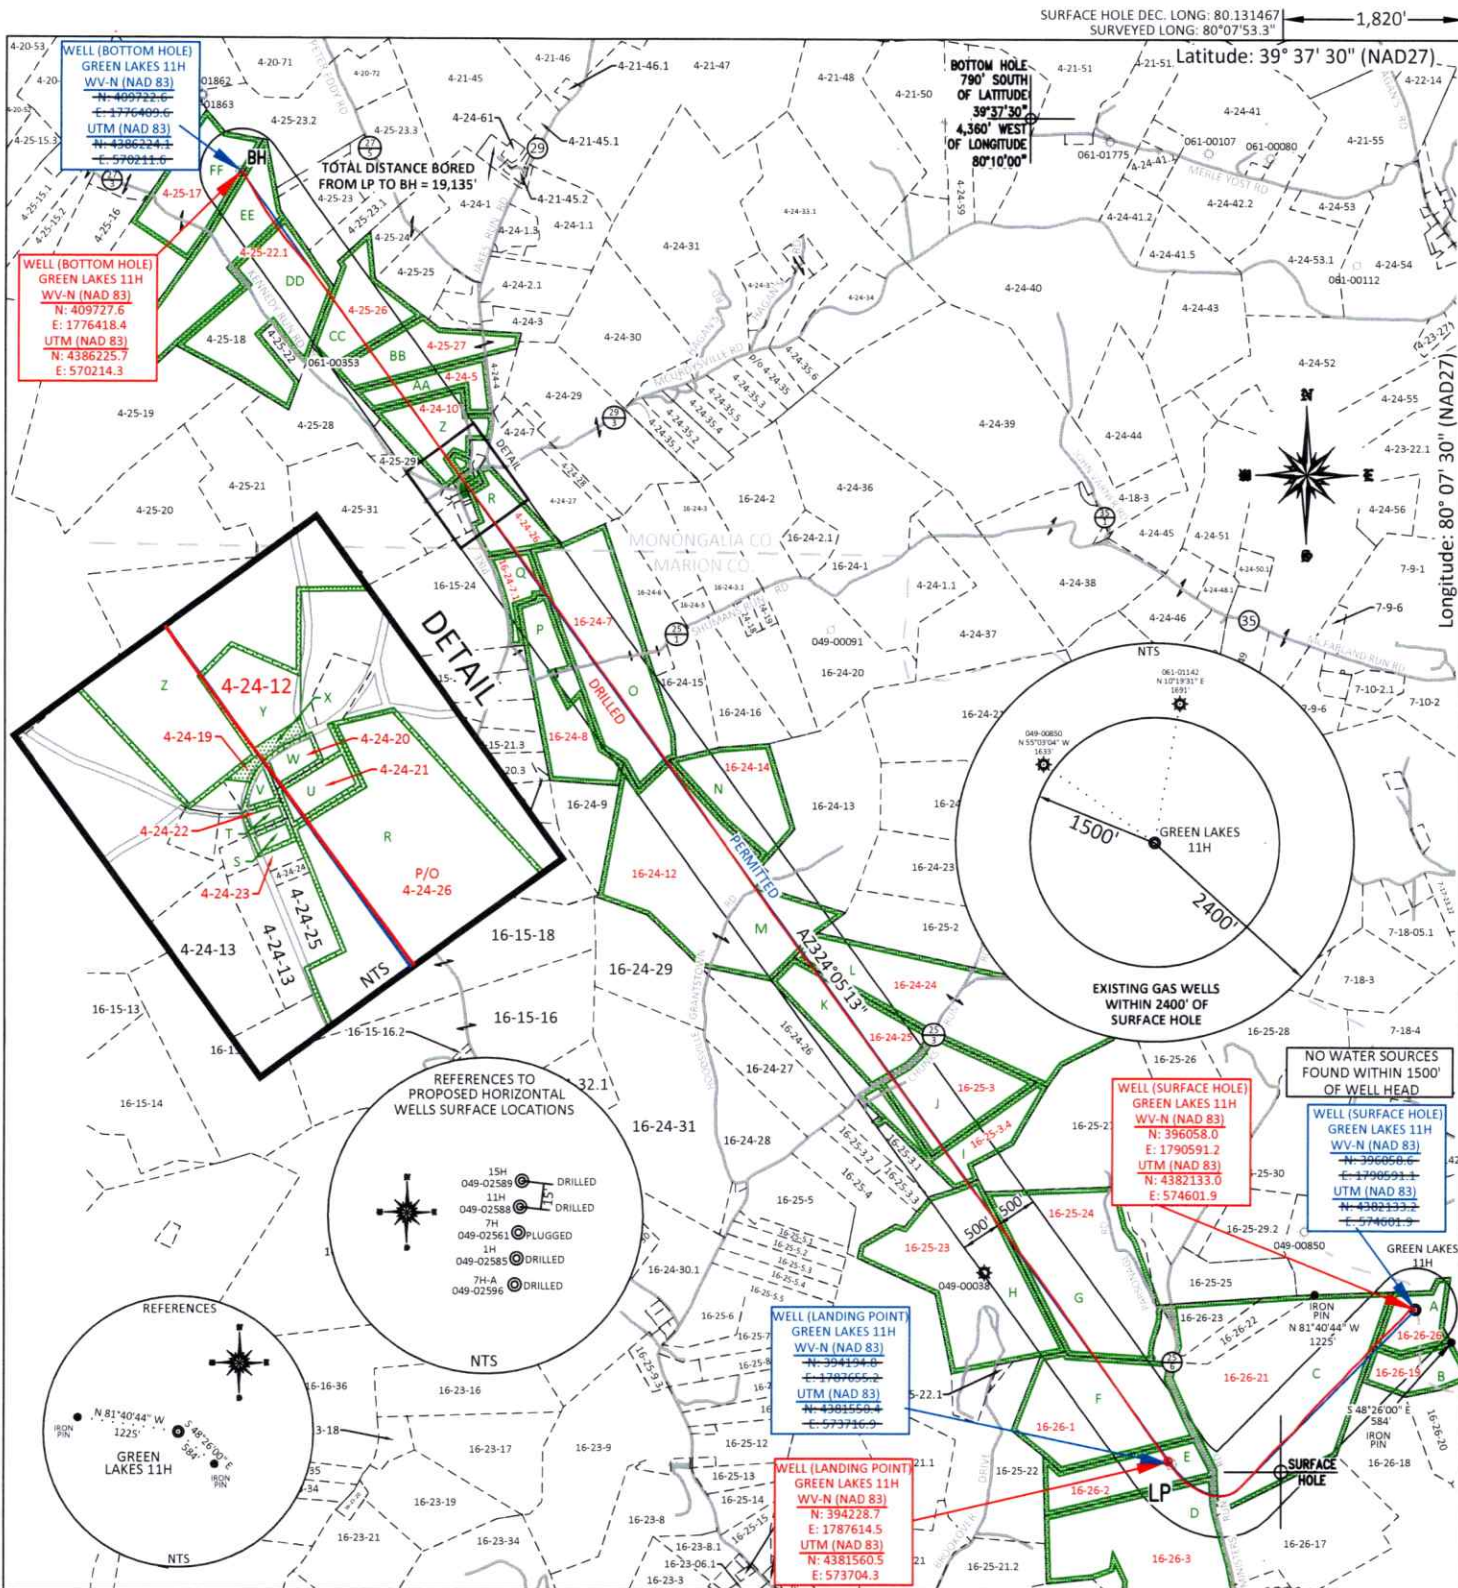

FILE #: NNE20
DRAWING #: 4052
SCALE: PLAT: 1" = 2400'
TICK: 1" = 2000'
MINIMUM DEGREE OF ACCURACY: 1/200
PROVEN SOURCE OF ELEVATION: SUBMETER MAPPING GRADE GPS

I, THE UNDERSIGNED, HEREBY CERTIFY THAT THIS PLAT IS CORRECT TO THE BEST OF MY KNOWLEDGE AND BELIEF AND SHOWS ALL THE INFORMATION REQUIRED BY LAW AND THE REGULATIONS ISSUED AND PRESCRIBED BY THE DEPARTMENT OF ENVIRONMENTAL PROTECTION.
Signed: *[Signature]*
L.L.S. #2124 : Ernest J. Benchek III



(+) DENOTES LOCATION OF WELL ON UNITED STATES TOPOGRAPHIC MAPS
WVDEP
OFFICE OF OIL & GAS
601 57TH STREET
CHARLESTON, WV 25304
Well Type: ☐ Oil ☐ Waste Diposal ☐ Production ☐ Deep
☒ Gas ☐ Liquid Injection ☐ Storage ☒ Shallow
WATERSHED: Upper Monongahela River
COUNTY/DISTRICT: MONONGALIA CO., GRANT DISTRICT / MARION CO., PAW PAW DISTRICT
SURFACE OWNER: Ministers Run Property Management LLC
OIL & GAS ROYALTY OWNER: Luther E. Howell and Nettie E. Howell
LEASE NUMBERS:

DATE: APRIL 3, 2026
OPERATOR'S WELL #: GREEN LAKES 11H (AS-DRILLED)
API WELL #: 47 49 02588
STATE COUNTY PERMIT
AS-BUILT ELEVATION: 1,448.7'
QUADRANGLE: GRANT TOWN
ACREAGE: 1003.08/28/2026
ACREAGE: 12.97 +/-

DRILL ☒ CONVERT ☐ DRILL DEEPER ☐ REDRILL ☐ FRACTURE OR STIMULATE ☒
PLUG OFF FORMATION ☐ PERFORATE NEW FORMATION ☐ PLUG & ABANDON ☐
CLEAN OUT & REPLUG ☐ OTHER CHANGE ☐ (SPECIFY):
TARGET FORMATION: MARCELLUS
WELL OPERATOR: NORTHEAST NATURAL ENERGY LLC
ADDRESS: 707 VIRGINIA STREET EAST, SUITE 1200
CITY: CHARLESTON STATE: WV ZIP CODE: 25301
DRILLED DEPTH: TVD: 7,968' TMD: 28,827'
DESIGNATED AGENT: JOHN ADAMS
ADDRESS: 707 VIRGINIA STREET EAST, SUITE 1200
CITY: CHARLESTON STATE: WV ZIP CODE: 25301

	PROPERTY INDEX
4-25-17	JOHN E STATLER
4-25-22.1	JOHN E STATLER
4-25-26	LONGIN PIOTROWSKI
4-25-27	DAVID S BRACKEN II & DEBRA L SHAFFER
4-24-5	LARRY W & ELEANOR BOGGS MOORE
4-24-10	LARRY W & ELEANOR BOGGS MOORE
4-24-26	LELAND JR & COREY M HURLEY
16-24-7.1	JAMES E LONG
16-24-7	ROBERT L OR PENNY D WHITE
16-24-8	ROBERT W & WILLIAM J & JOHN C & GARY V WHITE
16-24-14	STEVE J KISH SR ETAL
16-24-12	ARNOLD J & SAUNDRA A MORGAN
16-24-24	WILLIAM R & JONNETT D BRAGG
16-24-25	WILLIAM R BRAGG
16-25-3	HAROLD E PERKINS
16-25-3.4	REGINA A ENNIS (LIFE 1225-914)
16-25-23	JOSEPH E URSE JR
16-25-24	JAMES W BURTON III
16-26-26	MINISTERS RUN PROPERTY MANAGEMENT LLC
16-26-19	GARY W DAYTON
16-26-1	BARBARA TROUT (2/12 INT)
16-26-21	JERRY G & SHARON D SISLER
16-26-2	KENNETH E & SHIRLEY J BRAGG
16-26-3	KENNETH E & SHIRLEY J BRAGG
4-24-20	BRADLEY A & CHANDRA LYN WOLFE (LIFE: WILLIAM R & LYNN A COCHRAN)
4-24-19	NULL
4-24-21	CORY KING
4-24-22	CORY KING
4-24-23	JAMES E HARDWAY
4-24-12	CORY KING

	LEASE INDEX	
A	WV-049-106675-001	Q WV-049-005373-001
B	WV-049-106358-001	R WV-061-004575-000
C	WV-049-106380-001	S WV-061-006103-003
D	WV-049-106757-001	T WV-061-006143-001
E	WV-049-106757-001	U WV-061-006366-001
F	WV-049-106604-002	V WV-061-006143-001
G	WV-049-106457-001	W WV-061-004732-000
H	WV-049-106677-001	X WV-061-006143-001
I	WV-049-106493-001	Y WV-061-006143-001
J	WV-049-086241-001	Z WV-061-006863-001
K	WV-049-105165-001	AA WV-061-006863-001
L	WV-049-105165-001	BB WV-061-004259-001
M	WV-049-106376-001	CC WV-061-003015-015
N	WV-049-106392-001	DD WV-061-000212-001-ACT
O	WV-049-004394-002	EE WV-061-004293-005
P	WV-061-006366-001	FF WV-061-000212-001-ACT


08/28/2026

FILE #: NEE20	DATE: APRIL 3, 2026
DRAWING #: 4052	OPERATOR'S WELL #: GREEN LAKES 11H
SCALE: N/A	API WELL #: 47 49 02588 STATE COUNTY PERMIT

WELL NAME: GREEN LAKES 11H
GRANT TOWN



TOTAL DISTANCE BORED
FROM LP TO BH = 19,135'

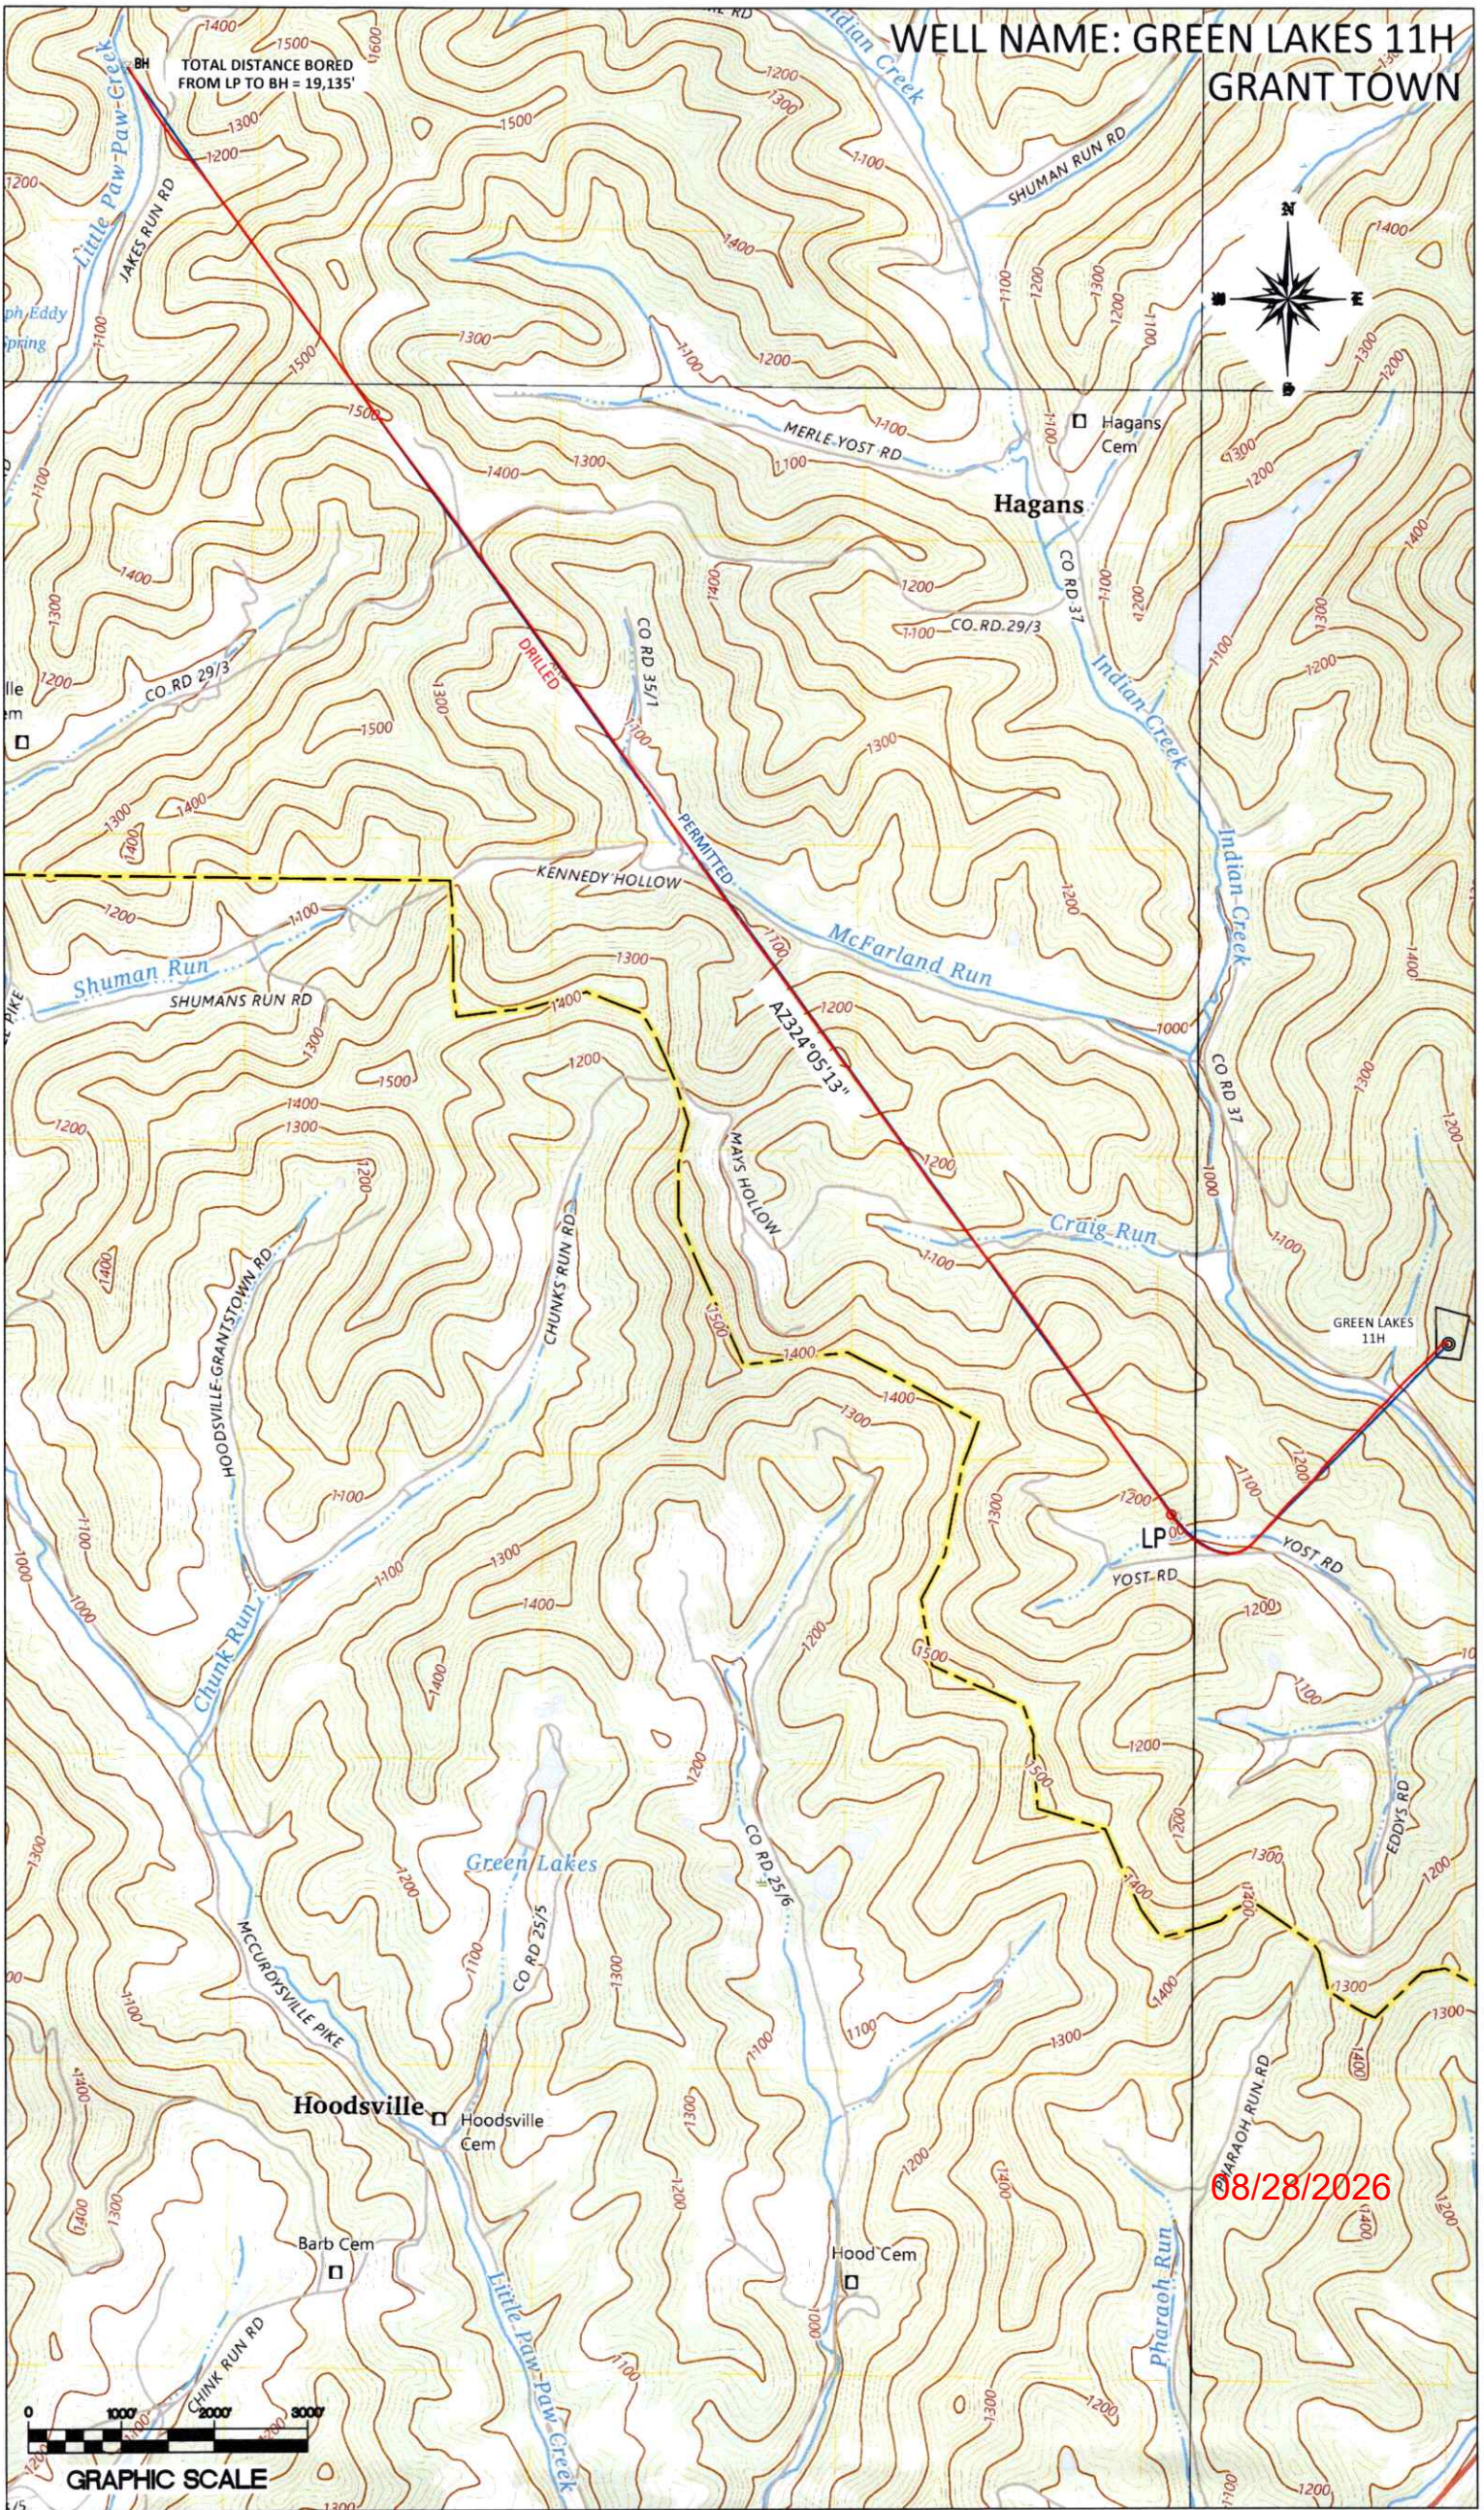

08/28/2026

GRAPHIC SCALE