


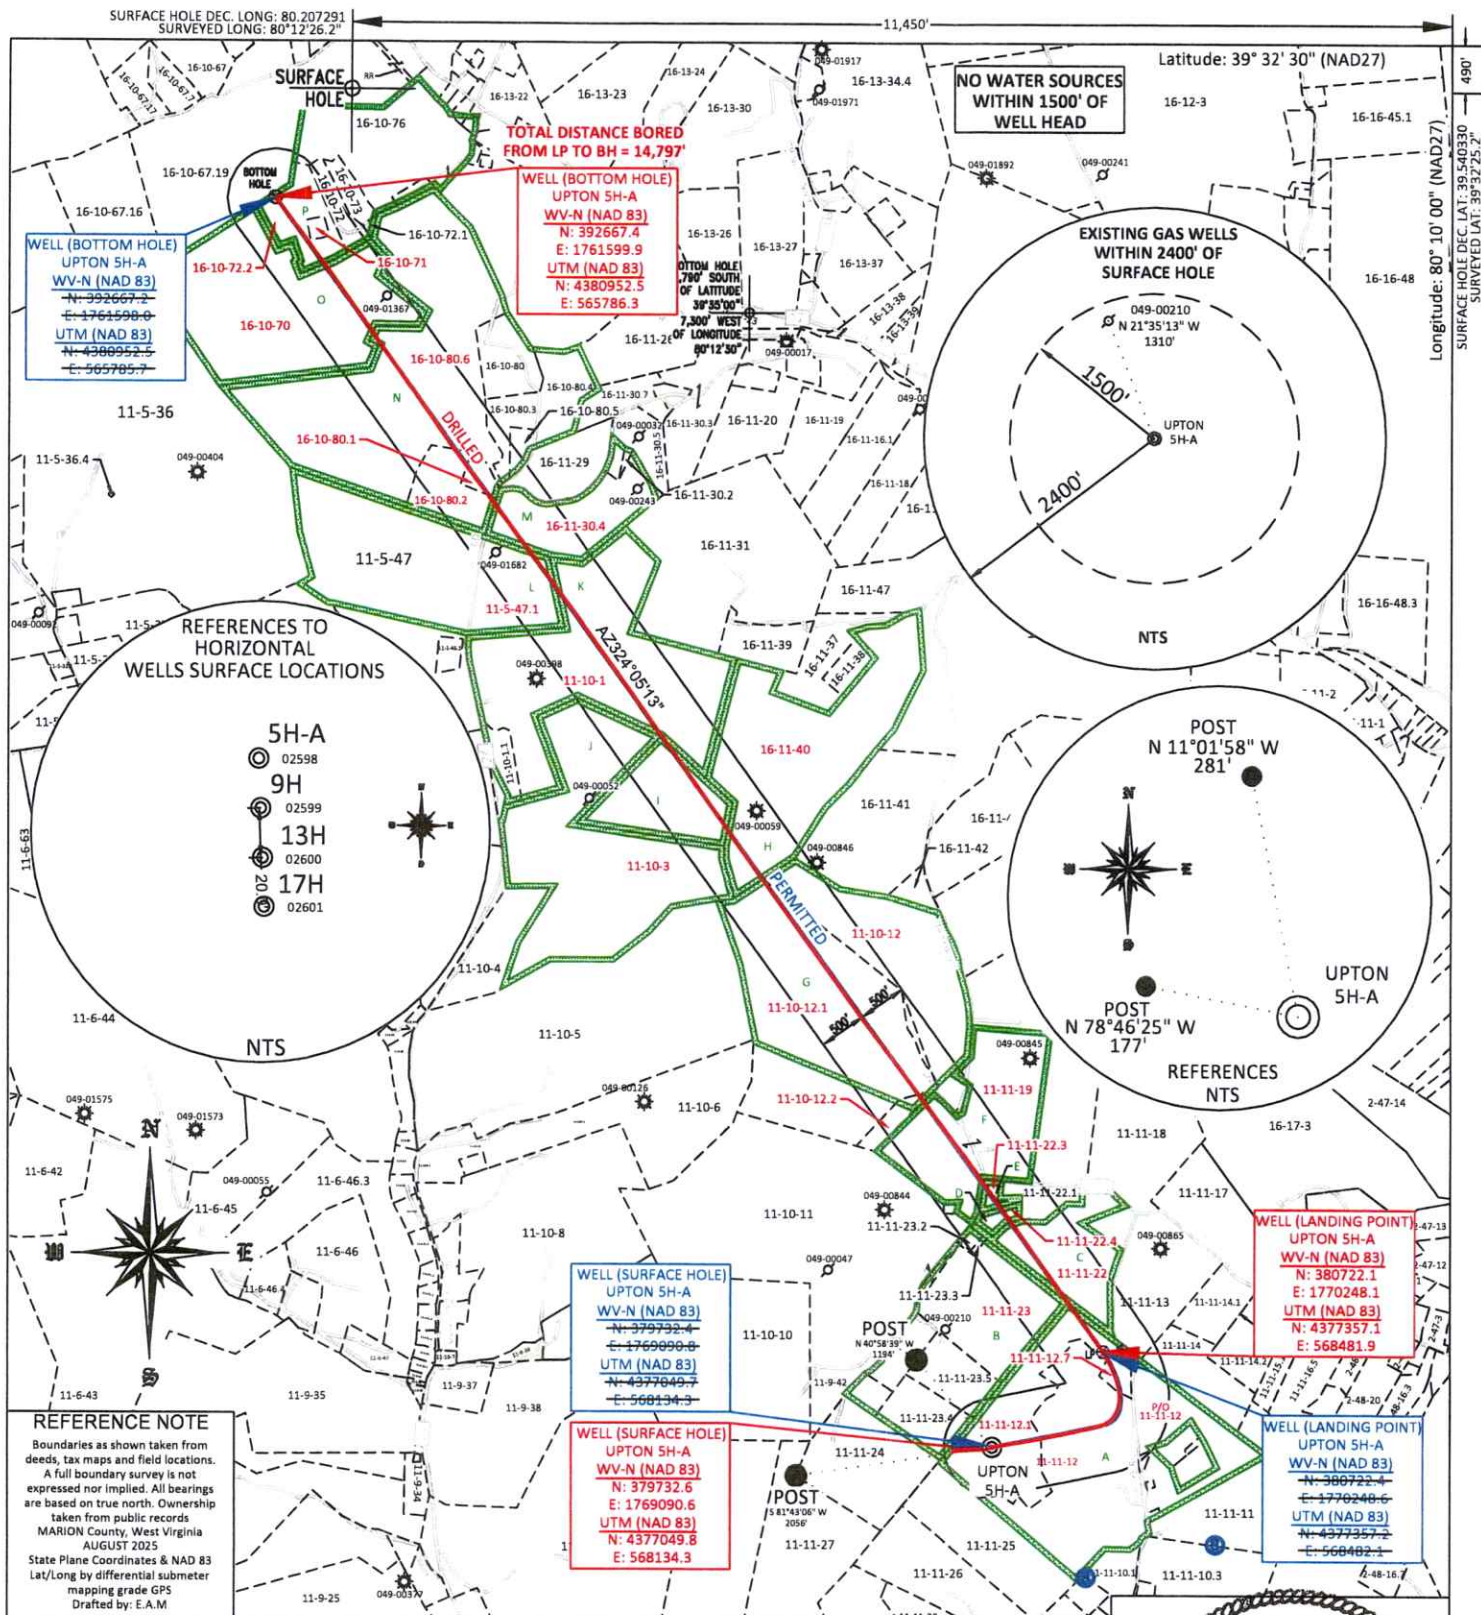

(+) DENOTES LOCATION OF WELL ON UNITED STATES TOPOGRAPHIC MAPS WVDEP

OFFICE OF OIL & GAS
601 57TH STREET
CHARLESTON, WV 25304

Well Type: ☐ Oil ☐ Waste Diposal ☐ Production ☐ Deep
☒ Gas ☐ Liquid Injection ☐ Storage ☒ Shallow

WATERSHED: BUFFALO CREEK

COUNTY/DISTRICT: MARION / LINCOLN

SURFACE OWNER: NORTHEAST NATURAL ENERGY LLC

OIL & GAS ROYALTY OWNER: Benjamin J. Johnson, et al.

LEASE NUMBERS:

DATE: MAY 29, 2026

OPERATOR'S WELL #: UPTON 5H-A (AS-DRILLED)

API WELL #: 47 49 02598
STATE COUNTY PERMIT

AS-BUILT ELEVATION: 1,372.5'

QUADRANGLE: GRANT TOWN

ACREAGE: 106.48 +/-

ACREAGE: 1003.80 +/-

08/28/2026

DRILL ☒ CONVERT ☐ DRILL DEEPER ☐ REDRILL ☐ FRACTURE OR STIMULATE ☒
PLUG OFF FORMATION ☐ PERFORATE NEW FORMATION ☐ PLUG & ABANDON ☐
CLEAN OUT & REPLUG ☐ OTHER CHANGE ☐ (SPECIFY):

TARGET FORMATION: MARCELLUS

WELL OPERATOR: NORTHEAST NATURAL ENERGY LLC

ADDRESS: 707 VIRGINIA STREET EAST, SUITE 1200

CITY: CHARLESTON STATE: WV ZIP CODE: 25301

DRILLED DEPTH: TVD: 7,761' TMD: 23,468' PILOT TVD: 8,005'

DESIGNATED AGENT: JOHN ADAMS

ADDRESS: 707 VIRGINIA STREET EAST, SUITE 1200

CITY: CHARLESTON STATE: WV ZIP CODE: 25301

	PROPERTY OWNER INDEX
11-11-12.1	NORTHEAST NATURAL ENERGY LLC
11-11-12	JERRY N & BARBARA J BLAND
11-11-12.7	DOUGLAS P TOOTHMAN
11-11-23	LEWIS E KINCAID (LIFE 957-206)
11-11-22	DAVID SCHOEWE
11-11-22.4	JASON T TENNANT
11-11-22.3	DAVID B & DELAINA KUCISH
11-11-19	DAVID B & DELAINA S KUCISH
11-10-12.2	KENNETH C & LINDA A HEBERT
11-10-12.1	GEORGE Q & DANA D MILLER
11-10-12	DAVID B & DELAINA S KUCISH
11-10-3	DEVORAH & JAY PITZER GRUNOW
16-11-40	DAVID B & DELAINA S KUCISH
11-10-1	RICHARD L & JEANETT V GARRISON
11-5-47.1	RICHARD L & JEANETT V GARRISON
16-11-30.4	CARLA W FORD (TOD 1202-69)
16-10-80.2	RICKY D & LULU MCKINNEY
16-10-80.1	RICKY D & LULU MCKINNEY
16-10-80.6	DONNA GLASPELL
16-10-70	KEITH ARTHUR (1/2 INT) & KRYSTAL D THARP & KELLY
16-10-71	LEWIS G ARTHUR
16-10-72.2	KEITH A & DIANA K ARTHUR

	LEASE INDEX		
A	WV-049-106694-002	I	WV-049-106378-002
B	WV-049-106387-002	J	WV-049-106378-002
C	WV-049-106402-001	K	WV-049-6045539-006
D	WV-049-106748-001	L	WV-049-106666-001
E	WV-049-106720-001	M	WV-049-106691-001
F	WV-049-106598-001	N	WV-049-104533-000
G	WV-049-106768-002	O	WV-049-604510-005
H	WV-049-106599-001	P	WV-049-106352-002

08/28/2026

FILE #: NEE14	DATE: MAY 29, 2026
DRAWING #: 4062	OPERATOR'S WELL #: UPTON 5H-A
SCALE: N/A	API WELL #: 47 49 02598 STATE COUNTY PERMIT

WELL NAME: UPTON 5H-A
GRANT TOWN

