
 
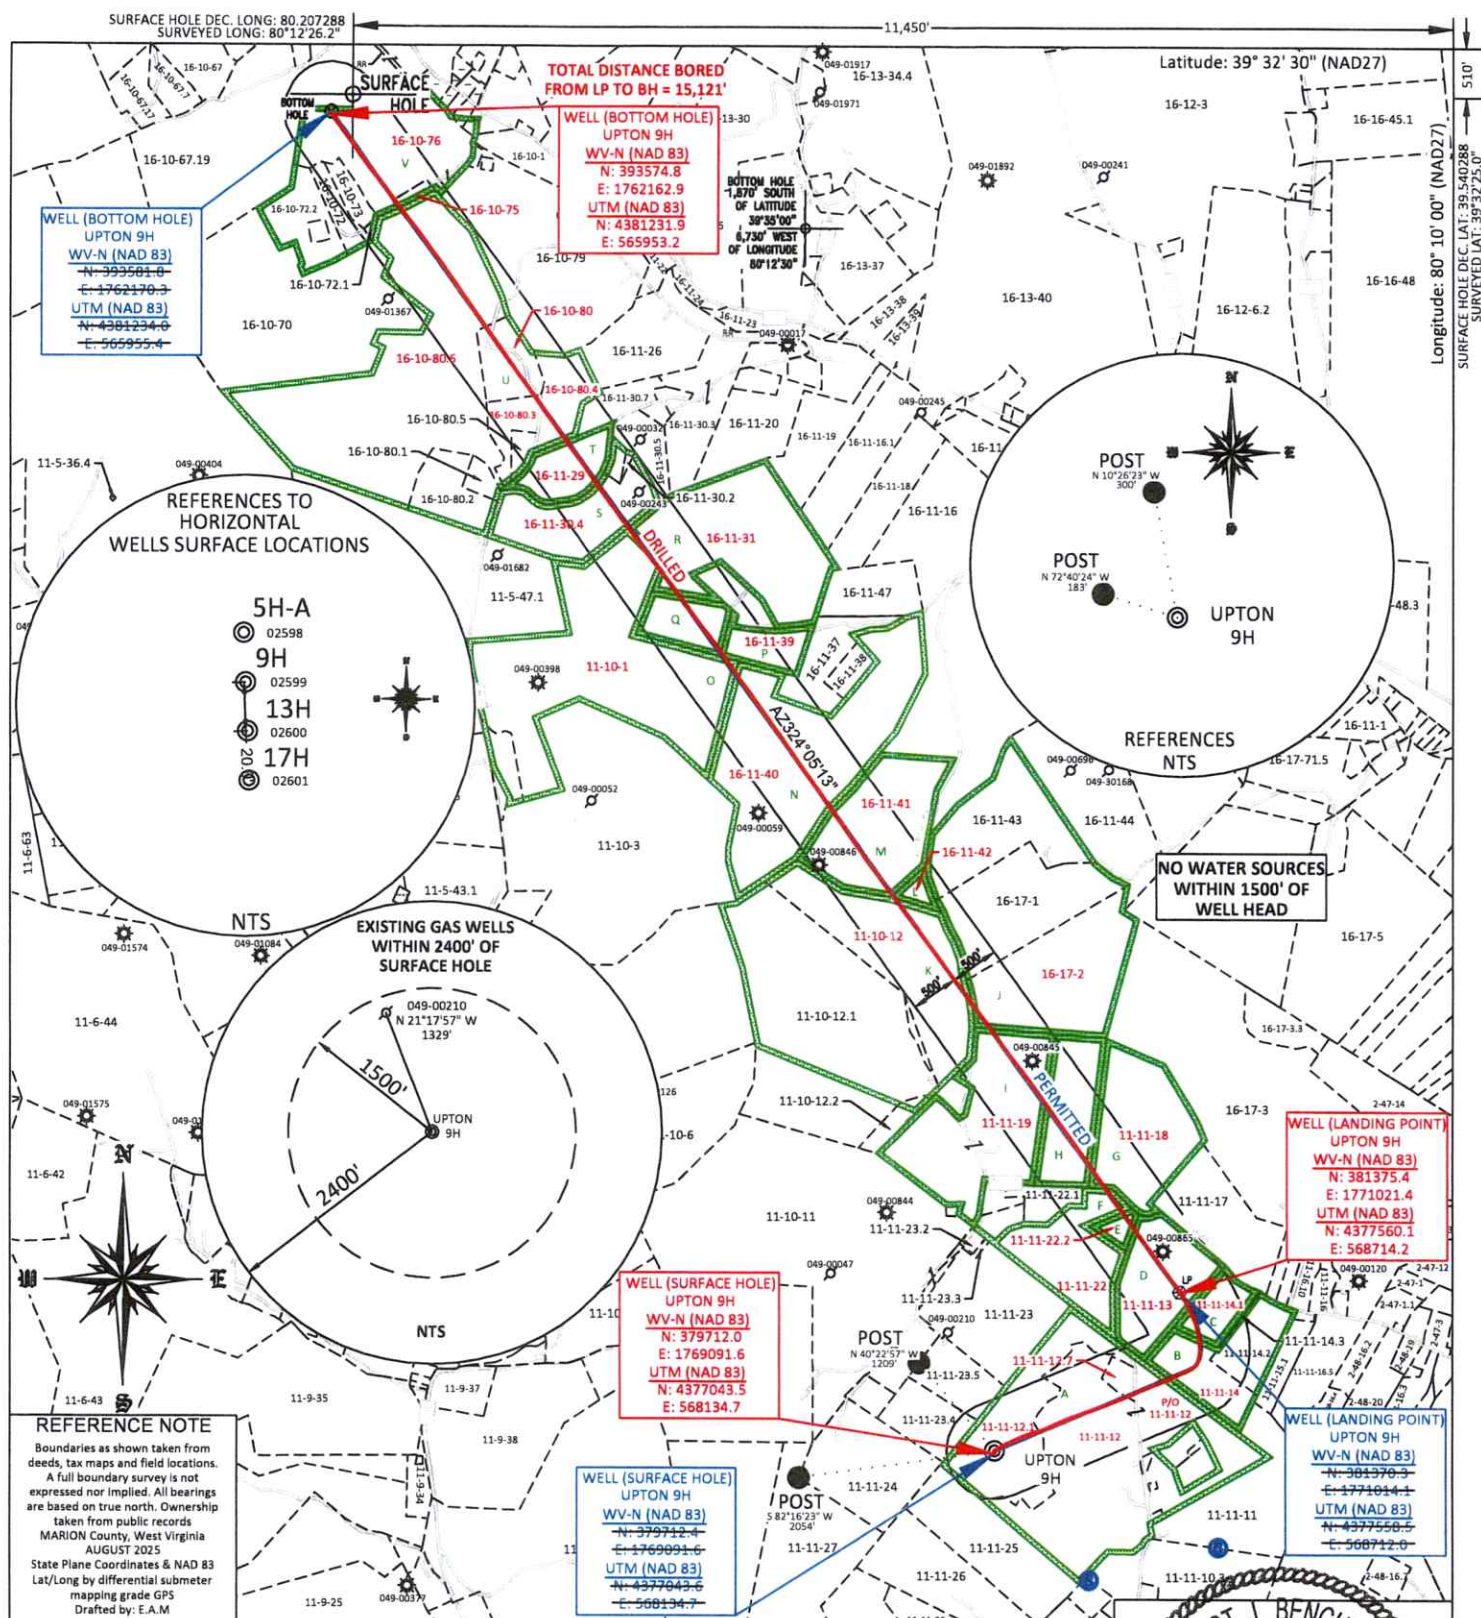




FILE #: NEE14
DRAWING #: 4063
SCALE: PLAT: 1" = 2000'
TICK MARK: 1" = 2000'
MINIMUM DEGREE
OF ACCURACY: 1/200
PROVEN SOURCE SUBMETER MAPPING
OF ELEVATION: GRADE GPS

I, THE UNDERSIGNED, HEREBY CERTIFY THAT THIS PLAT IS CORRECT TO THE BEST OF MY KNOWLEDGE AND BELIEF AND SHOWS ALL THE INFORMATION REQUIRED BY LAW AND THE REGULATIONS ISSUED AND PRESCRIBED BY THE DEPARTMENT OF ENVIRONMENTAL PROTECTION.

Signed: 
L.L.S. #2124 : Ernest J. Benckek III

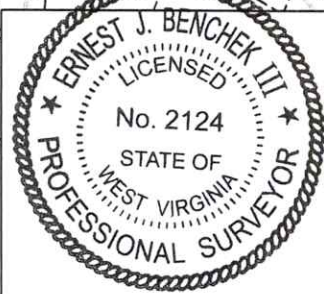

(+) DENOTES LOCATION OF WELL ON
UNITED STATES TOPOGRAPHIC MAPS
WVDEP

OFFICE OF OIL & GAS
601 57TH STREET
CHARLESTON, WV 25304

Well Type: ☐ Oil ☐ Waste Diposal ☐ Production ☐ Deep
☒ Gas ☐ Liquid Injection ☐ Storage ☒ Shallow

WATERSHED: BUFFALO CREEK

COUNTY/DISTRICT: MARION / LINCOLN

SURFACE OWNER: NORTHEAST NATURAL ENERGY LLC

OIL & GAS ROYALTY OWNER: Benjamin J. Johnson, et al.

LEASE NUMBERS:

DATE: MAY 29, 2026

OPERATOR'S WELL #: UPTON 9H (AS-DRILLED)

API WELL #: 47 49 02599
STATE COUNTY PERMIT

AS-BUILT
ELEVATION: 1,372.5'

QUADRANGLE: GRANT TOWN

ACREAGE: 106.48

ACREAGE: 1010.14 +/-

DRILL ☒ CONVERT ☐ DRILL DEEPER ☐ REDRILL ☐ FRACTURE OR STIMULATE ☒
 PLUG OFF FORMATION ☐ PERFORATE NEW FORMATION ☐ PLUG & ABANDON ☐
 CLEAN OUT & REPLUG ☐ OTHER CHANGE ☐ (SPECIFY): _____

TARGET FORMATION: MARCELLUS

WELL OPERATOR: NORTHEAST NATURAL ENERGY LLC

ADDRESS: 707 VIRGINIA STREET EAST, SUITE 1200

CITY: CHARLESTON STATE: WV ZIP CODE: 25301

DRILLED DEPTH: TVD: 7,759' TMD: 24,079'

DESIGNATED AGENT: JOHN ADAMS

ADDRESS: 707 VIRGINIA STREET EAST, SUITE 1200

CITY: CHARLESTON STATE: WV ZIP CODE: 25301


	PROPERTY OWNER INDEX
11-11-12.1	NORTHEAST NATURAL ENERGY LLC
11-11-12	JERRY N & BARBARA J BLAND
11-11-12.7	DOUGLAS P TOOTHMAN
11-11-14	DAVID L SCHOEWE
11-11-14.1	TRACY A COPPOLA
11-11-13	DAVID SCHOEWE
11-11-22.2	DAVID J & MELISSA M KUCISH
11-11-22	DAVID SCHOEWE
11-11-18	DAVID B & DELAINA S KUCISH
11-11-19	DAVID B & DELAINA S KUCISH
16-17-2	MARY JO MAHAFFEY (TOD 1226-491)
11-10-12	DAVID B & DELAINA S KUCISH
16-11-42	DANIEL J SHUMATE
16-11-41	DAVID B & DELAINA S KUCISH
16-11-40	DAVID B & DELAINA S KUCISH
11-10-1	RICHARD L & JEANETT V GARRISON
16-11-39	WILLIAM K BOYLEN JR (DBA BOYLEN TIMBER COMPANY)
16-11-31	DAVID J & MELISSA M KUCISH
16-11-30.4	CARLA W FORD (TOD 1202-69)
16-11-29	ROBERT L LEPLY
16-10-80.4	BARTLEY A & SUSAN C BLAND
16-10-80.3	JARED MCCULLOUGH
16-10-80	THOMAS M & MORGAN N MUSGROVE
16-10-80.6	DONNA GLASPELL
16-10-75	CLARENCE & PAULINE A KNOTTS ESTS
16-10-76	JAMES R OR JAMES R MOORE II

	LEASE INDEX		
A	WV-049-106694-002	L	WV-049-106768-002
B	WV-049-107016-001	M	WV-049-106600-001
C	WV-049-000212-001 – LA	N	WV-049-106599-001
D	WV-049-106597-001	O	WV-049-6045539-006
E	WV-049-106711-001	P	WV-049-106808-001
F	WV-049-106402-001	Q	WV-049-106622-003
G	WV-049-106720-001	R	WV-049-106720-001
H	WV-049-106360-003	S	WV-049-106691-001
I	WV-049-106598-001	T	WV-049-106691-001
J	WV-049-104627-000	U	WV-049-104533-000
K	WV-049-106768-002	V	WV-049-106352-002

08/28/2026

FILE #: NEE14	DATE: MAY 29, 2026
DRAWING #: 4063	OPERATOR'S WELL #: UPTON 9H
SCALE: N/A	API WELL #: 47 49 02599 STATE COUNTY PERMIT

WELL NAME: UPTON 9H
GRANT TOWN

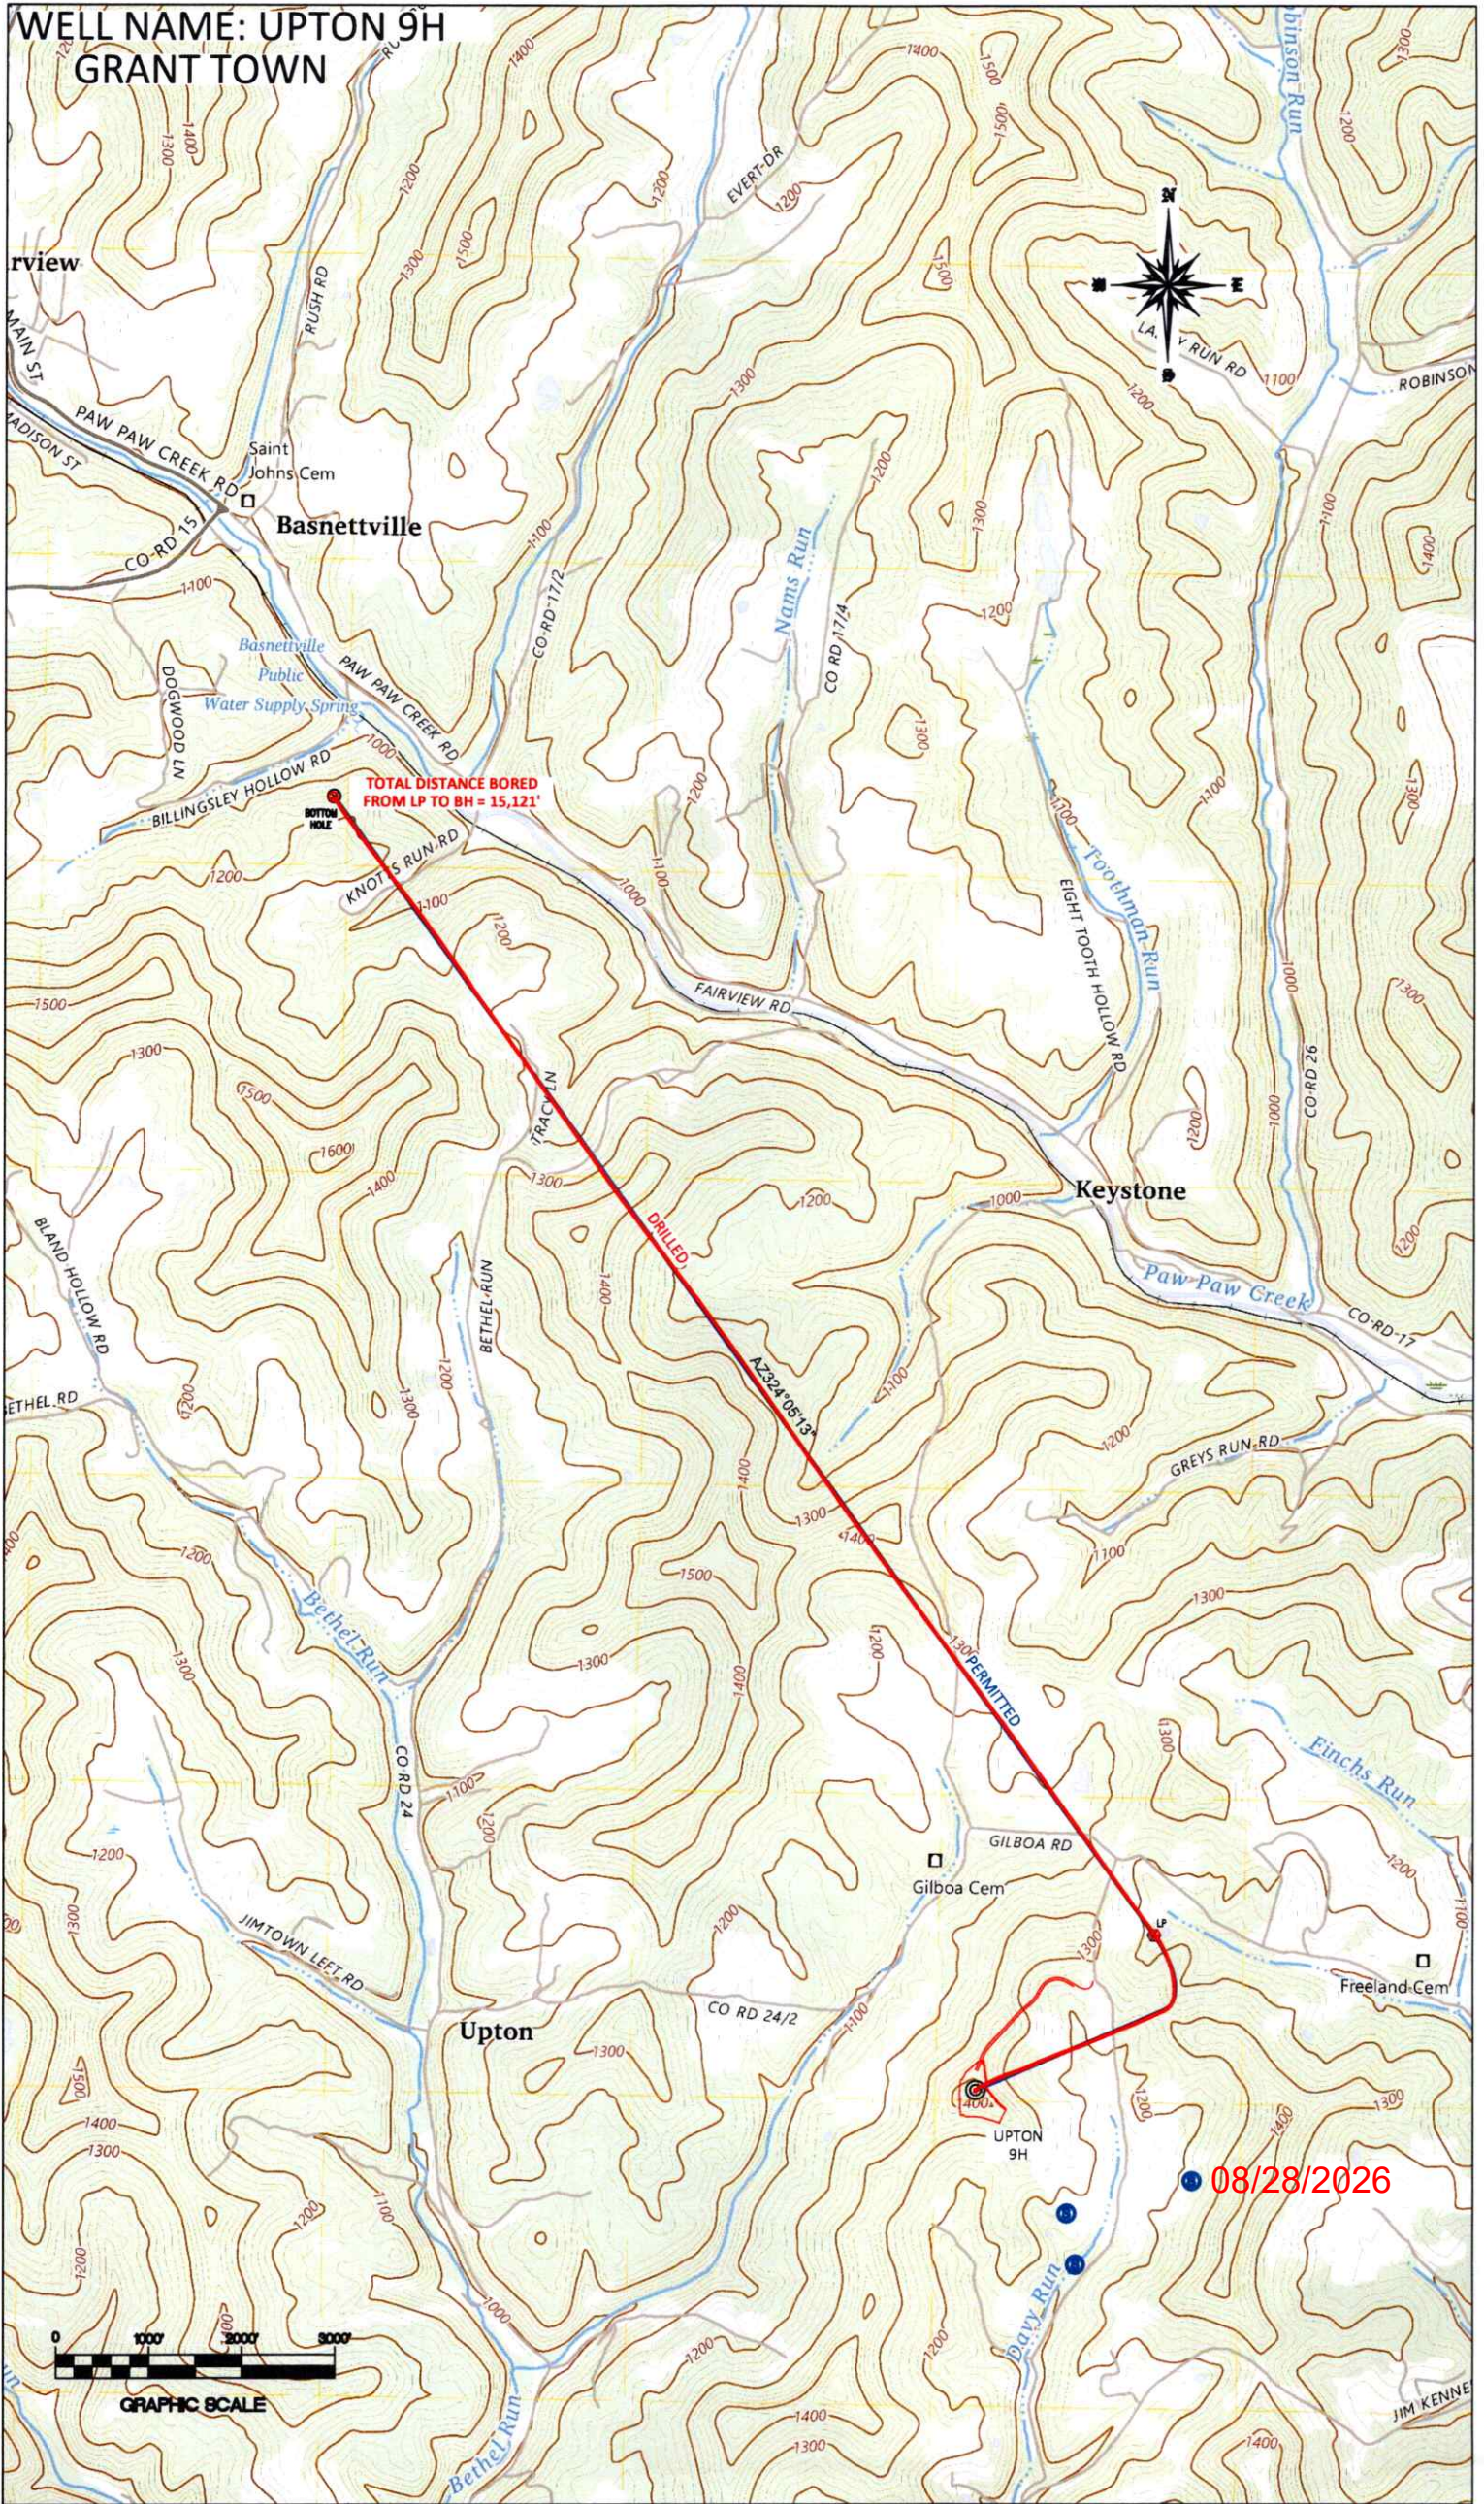

TOTAL DISTANCE BORED
FROM LP TO BH = 15,121'

BOTTOM HOLE

DRILLED

PERMITTED

08/28/2026



GRAPHIC SCALE