


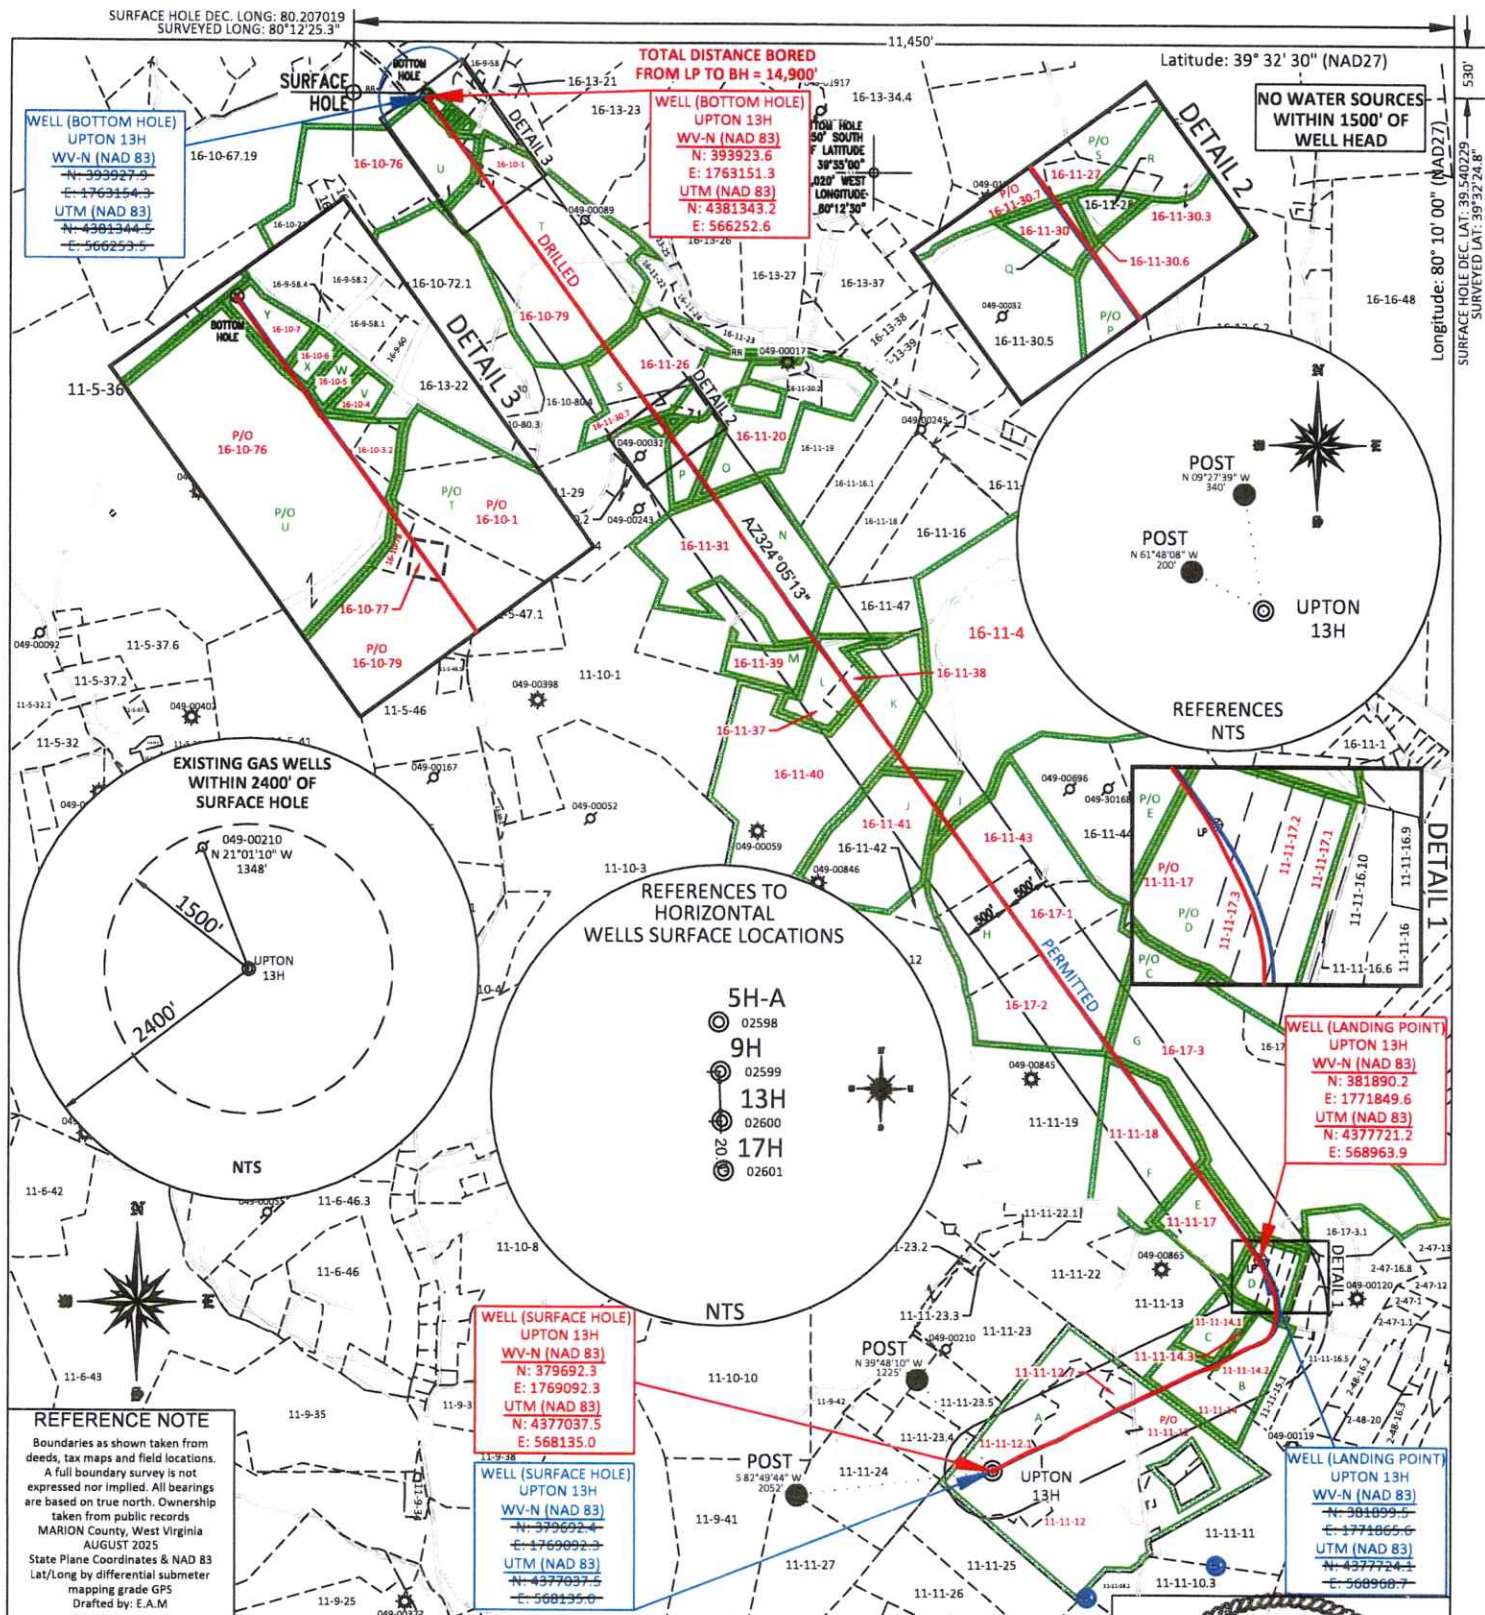

(+) DENOTES LOCATION OF WELL ON
UNITED STATES TOPOGRAPHIC MAPS
WVDEP
OFFICE OF OIL & GAS
601 57TH STREET
CHARLESTON, WV 25304
Well Type: ☐ Oil ☐ Waste Diposal ☐ Production ☐ Deep
☒ Gas ☐ Liquid Injection ☐ Storage ☒ Shallow
WATERSHED: BUFFALO CREEK
COUNTY/DISTRICT: MARION / LINCOLN
SURFACE OWNER: NORTHEAST NATURAL ENERGY LLC
OIL & GAS ROYALTY OWNER: Benjamin J. Johnson, et al.
LEASE NUMBERS:

DATE: MAY 29, 2026
OPERATOR'S WELL #: UPTON 13H (AS-DRILLED)
API WELL #: 47 49 02600
STATE COUNTY PERMIT
AS-BUILT
ELEVATION: 1,372.5'
QUADRANGLE: GRANT TOWN
ACREAGE: 106.48 +/-
ACREAGE: 1128.10 +/-

DRILL ☒ CONVERT ☐ DRILL DEEPER ☐ REDRILL ☐ FRACTURE OR STIMULATE ☒
PLUG OFF FORMATION ☐ PERFORATE NEW FORMATION ☐ PLUG & ABANDON ☐
CLEAN OUT & REPLUG ☐ OTHER CHANGE ☐ (SPECIFY):
TARGET FORMATION: MARCELLUS
WELL OPERATOR: NORTHEAST NATURAL ENERGY LLC
ADDRESS: 707 VIRGINIA STREET EAST, SUITE 1200
CITY: CHARLESTON STATE: WV ZIP CODE: 25301
DRILLED DEPTH: TVD: 7,788' TMD: 24,327'
DESIGNATED AGENT: JOHN ADAMS
ADDRESS: 707 VIRGINIA STREET EAST, SUITE 1200
CITY: CHARLESTON STATE: WV ZIP CODE: 25301

08/28/2026

	PROPERTY OWNER INDEX
11-11-12.1	NORTHEAST NATURAL ENERGY LLC
11-11-12	JERRY N & BARBARA J BLAND
11-11-12.7	DOUGLAS P TOOTHMAN
11-11-14	DAVID L SCHOEWE
11-11-14.1	TRACY A COPPOLA
11-11-14.2	HEATHER E & RYAN WARD
11-11-14.3	DAVID L SCHOEWE
11-11-17.1	BRANDON S & LISA M FLOWER
11-11-17.2	BRANDON S & LISA M FLOWER
11-11-17.3	BRANDON S & LISA M FLOWER
11-11-17	DAVID SCHOEWE
11-11-18	DAVID B & DELAINA S KUCISH
16-17-3	JUDITH L POE (LIFE 1232-733)
16-17-2	MARY JO MAHAFFEY (TOD 1226-491)
16-17-1	MARY JO MAHAFFEY (TOD 1226-491)
16-11-43	MARY JO MAHAFFEY (TOD 1226-491)
16-11-41	DAVID B & DELAINA S KUCISH
16-11-4	WILLIAM K BOYLEN JR (DBA BOYLEN TIMBER COMPANY)
16-11-40	DAVID B & DELAINA S KUCISH
16-11-38	DAVID & DELAINA KUCISH
16-11-37	DAVID & DELAINA KUCISH
16-11-39	WILLIAM K BOYLEN JR (DBA BOYLEN TIMBER COMPANY)
16-11-31	DAVID J & MELISSA M KUCISH
16-11-20	THEODORE M OPRON (1196-540)
16-11-30.3	CARL H WITT JR & GREGORY G CARRUBA
16-11-30.6	CARL WITT JR & GREGORY CARRUBA
16-11-30	DARLA J & RONNIE L RETTON JR (LIFE 1202-204)
16-11-30.7	RONNIE L RETTON JR & DARLA J RETTON
16-11-27	CARL H WITT JR & GREGORY G CARRUBA
16-11-26	RONALD D & SUE E WALLS
16-10-79	MAYNARD KNOTTS ETAL
16-10-77	ERP FEDERAL MINING COMPLEX LLC
16-10-78	JOSHUA E & ROBERT J KNOTTS
16-10-1	MAYNARD KNOTTS ETAL
16-10-76	JAMES R OR JAMES R MOORE II
16-10-3.2	JAMES & ELVA SWIGER
16-10-4	LENZA RINEHART JR (LIFE 971-1191)
16-10-5	MICHAEL J WEAVER
16-10-6	EMERY D & CATHERINE A KNOTTS (TOD 1269-594)
16-10-7	TY K & JESSICA B CASE

	LEASE INDEX		
A	WV-049-106694-002	N	WV-049-106720-001
B	WV-049-107016-001	O	WV-049-106828-001
C	WV-049-000212-001 – LA	P	WV-049-106691-001
D	WV-049-106804-005	Q	WV-049-106691-001
E	WV-049-106804-005	R	WV-049-106691-001
F	WV-049-106720-001	S	WV-049-106685-006
G	WV-049-106953-002	T	WV-049-204329-001
H	WV-049-104627-000	U	WV-049-106352-002
I	WV-049-106811-001	V	WV-049-106608-004
J	WV-049-106600-001	W	WV-049-086183-001
K	WV-049-106599-001	X	WV-049-106387-002
L	WV-049-106720-001	Y	WV-049-106479-001
M	WV-049-106808-001		

08/28/2026

FILE #: NEE14

DRAWING #: 4064


SCALE: N/A

DATE: MAY 29, 2026

OPERATOR'S WELL #: UPTON 13H

API WELL #: 47 49 02600
STATE COUNTY PERMIT

WELL NAME: UPTON 13H
GRANT TOWN

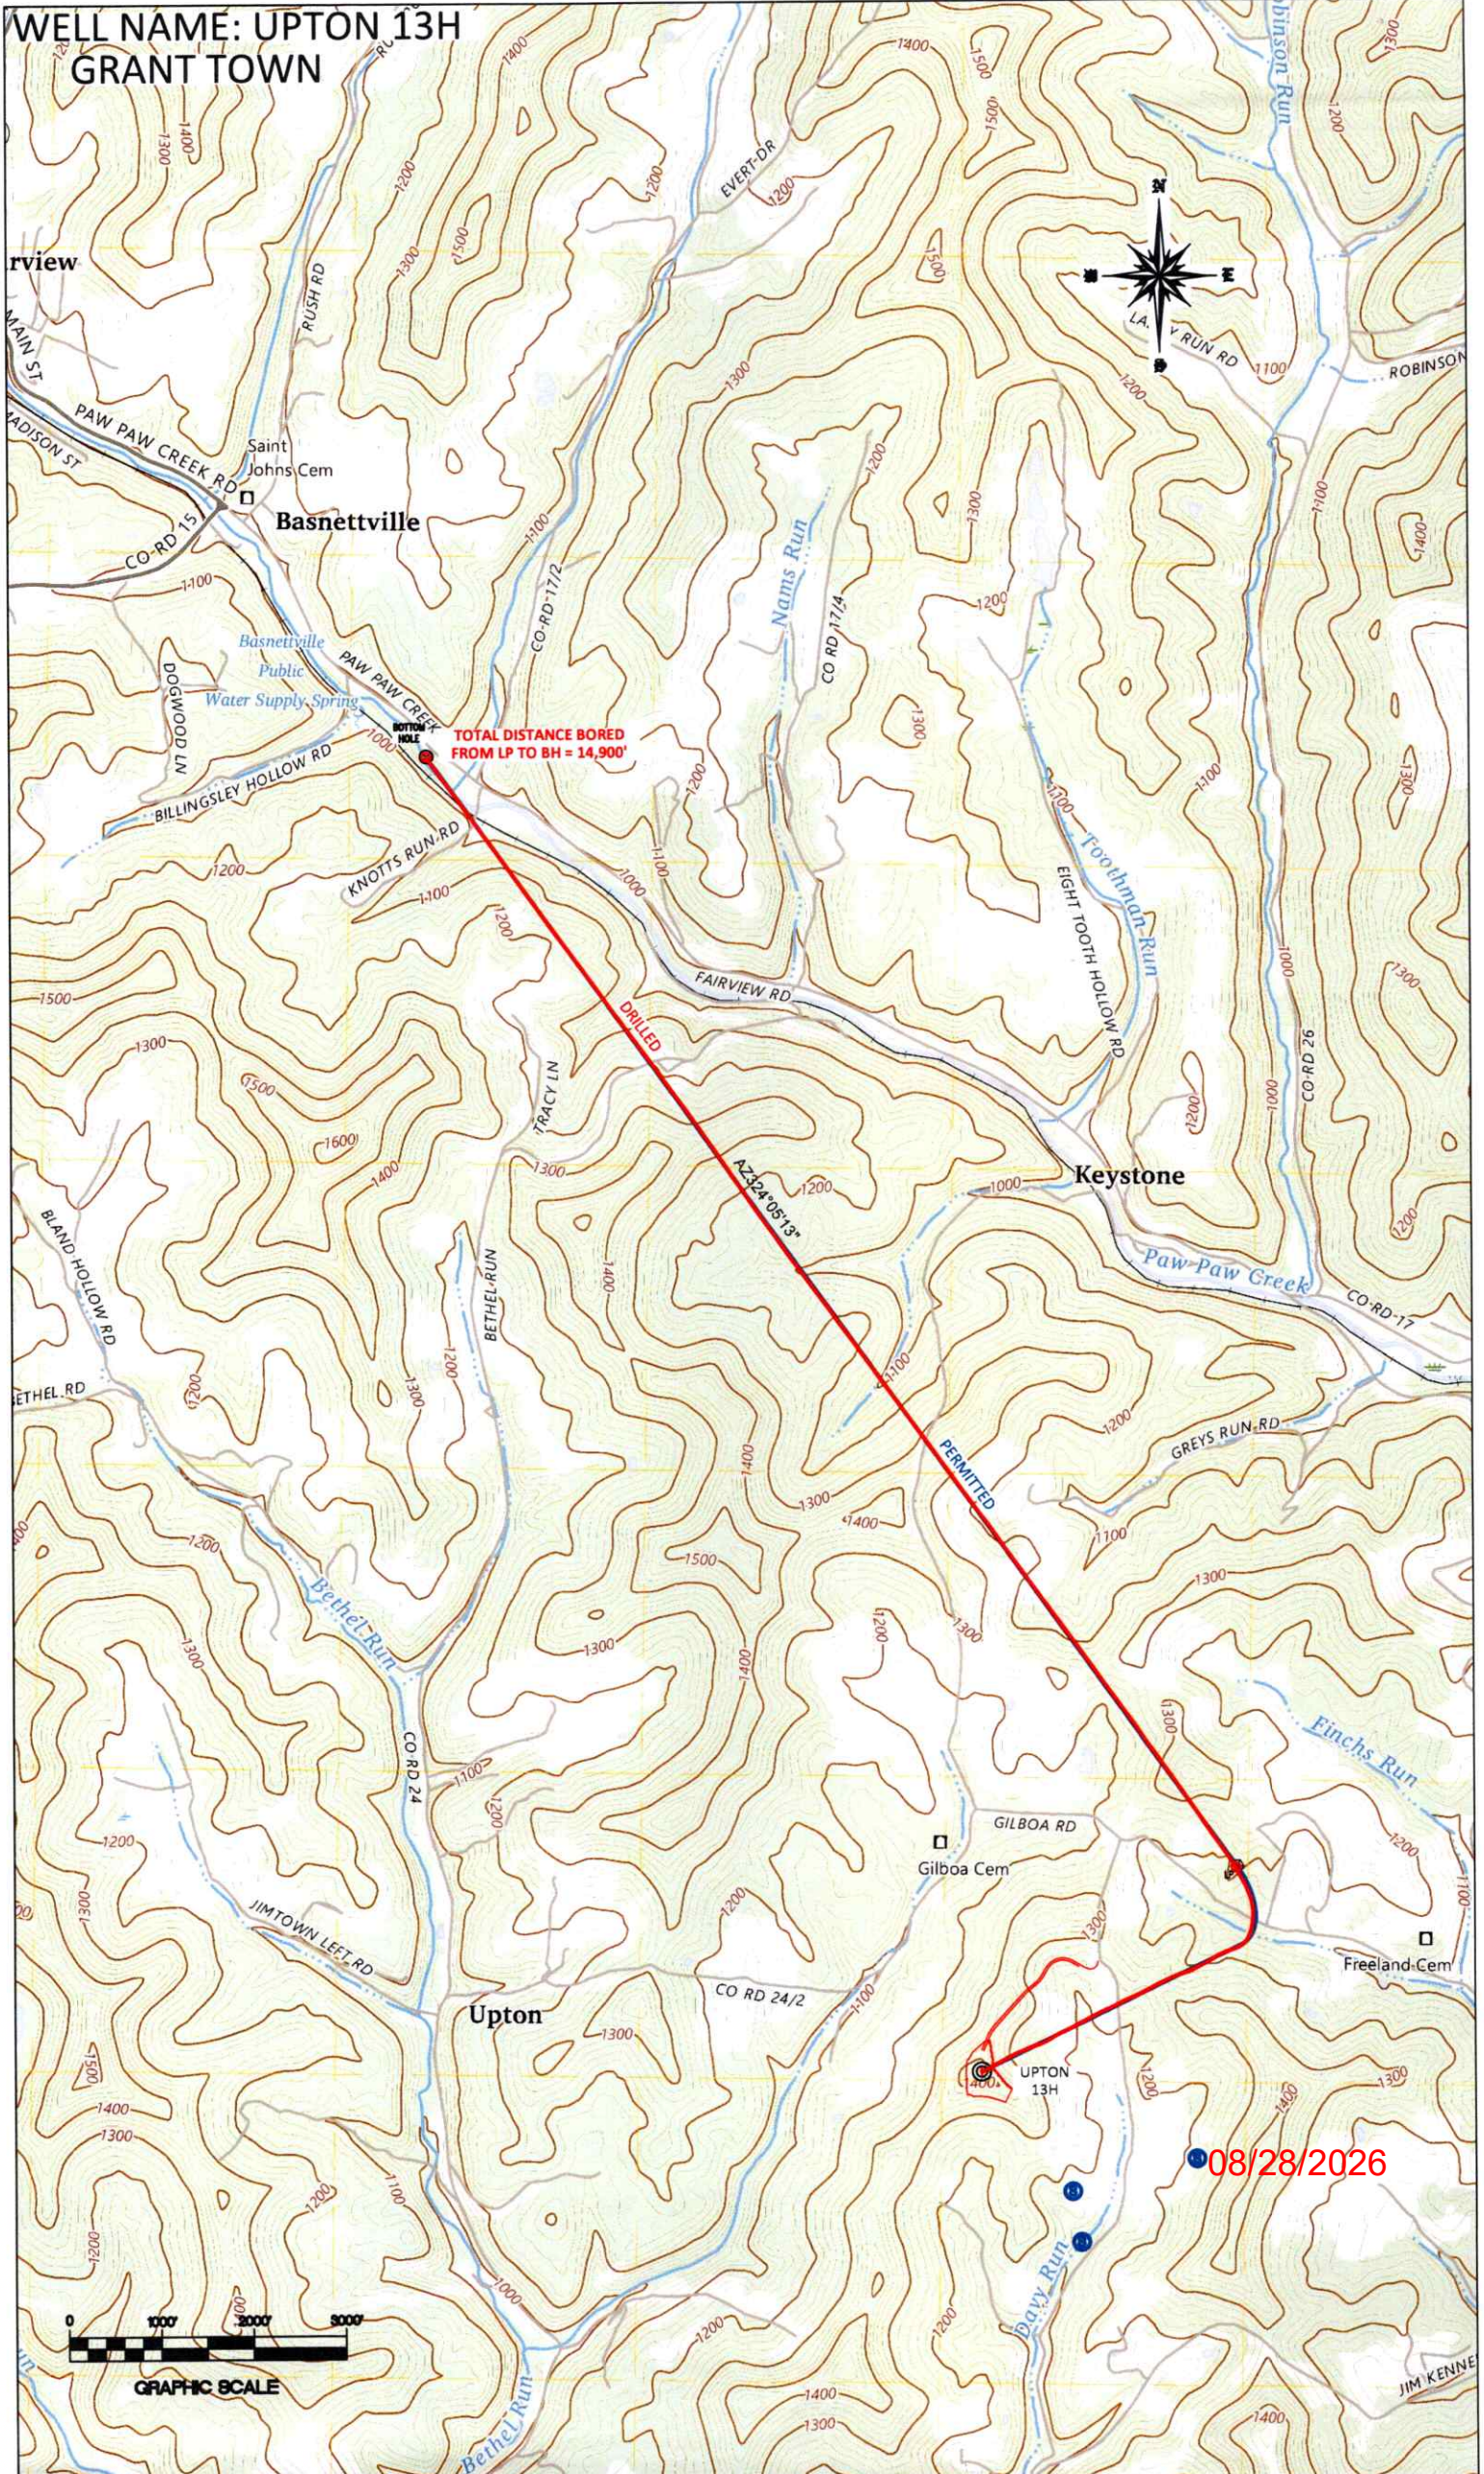

TOTAL DISTANCE BORED
FROM LP TO BH = 14,900'

AZ: 324°05'13"

08/28/2026



GRAPHIC SCALE