


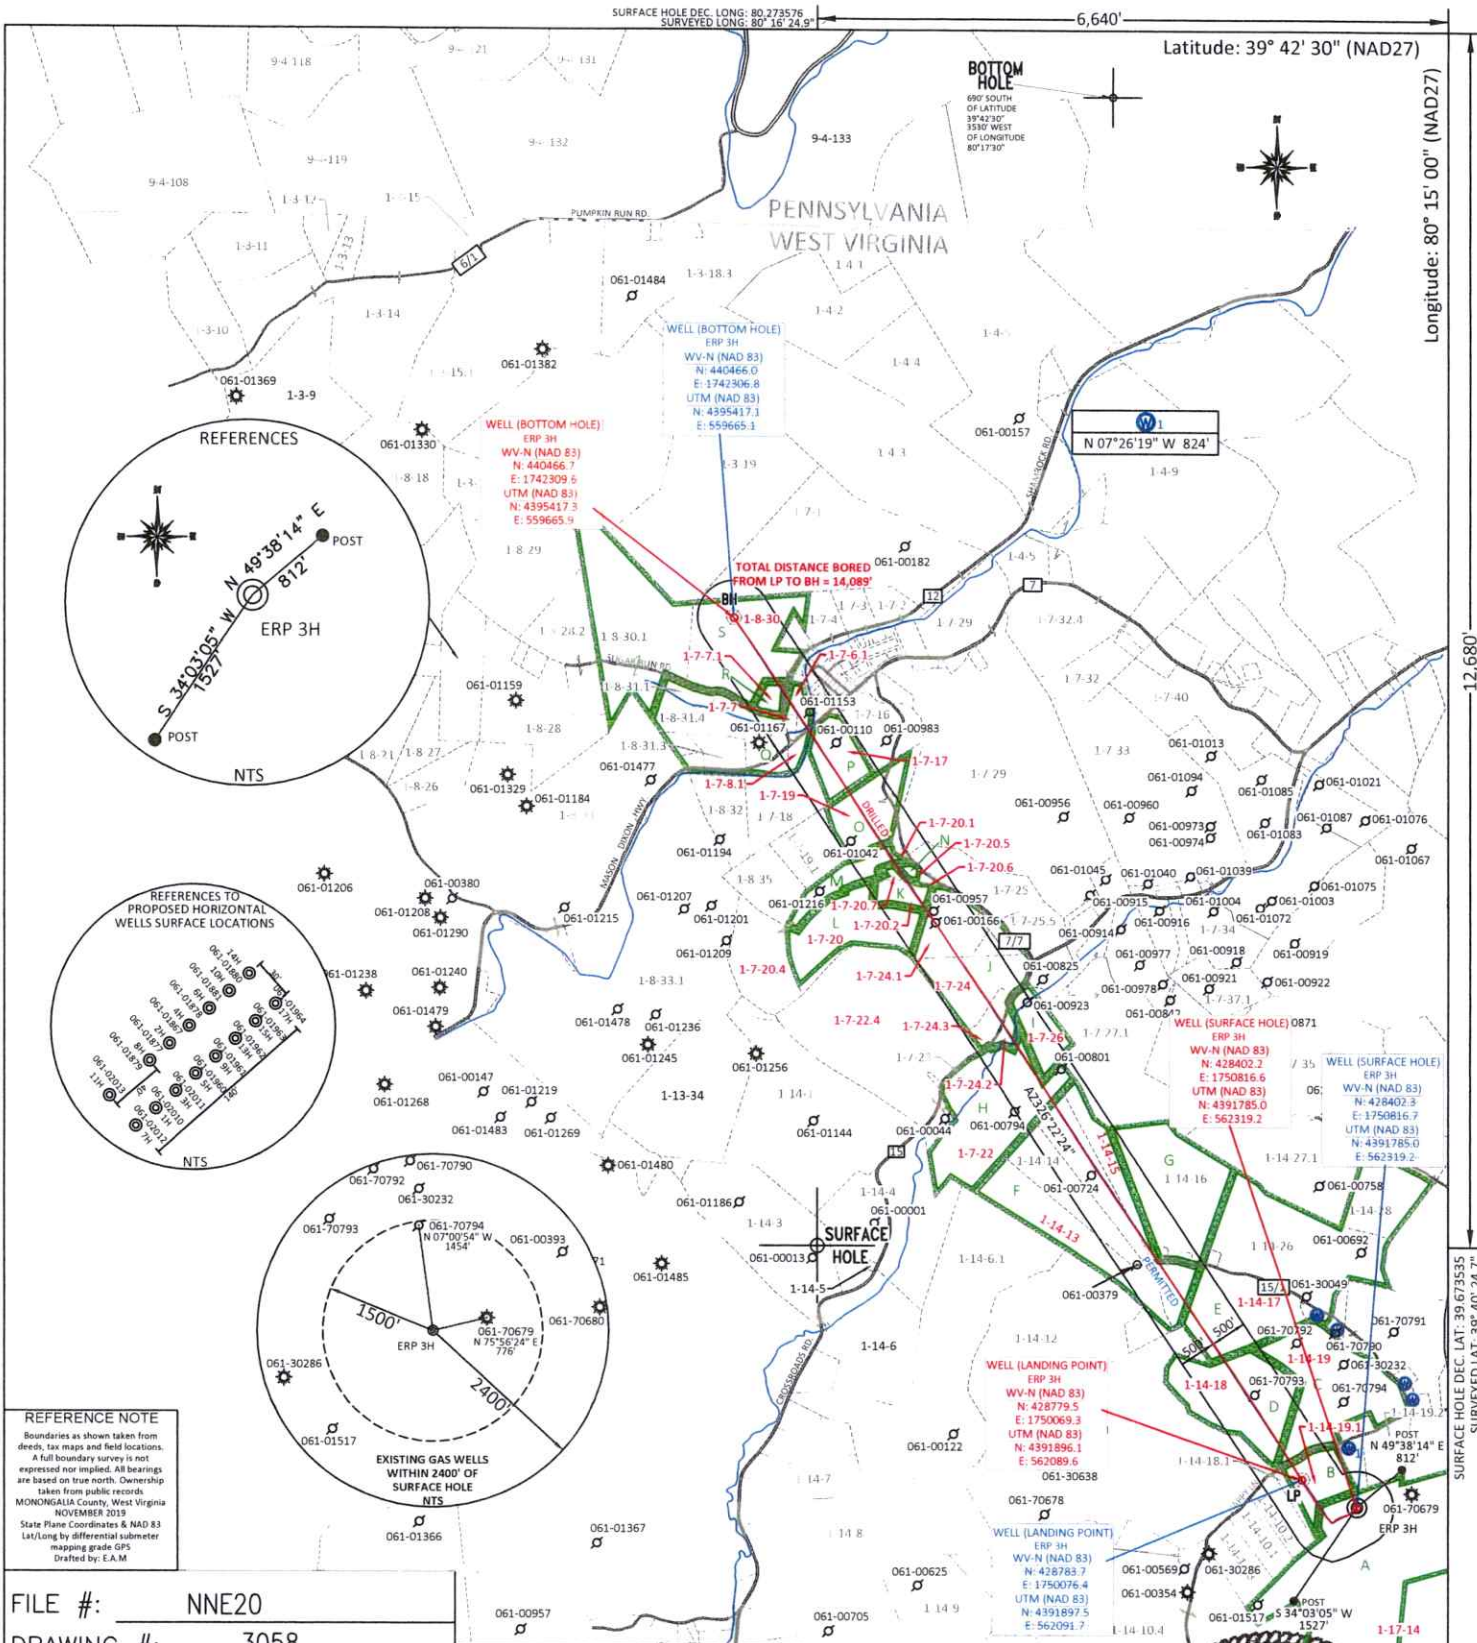

FILE #: NNE20

DRAWING #: 3058

SCALE: PLAT: 1" = 2600'

MINIMUM DEGREE OF ACCURACY: 1/200

PROVEN SOURCE SUBMETER MAPPING OF ELEVATION: GRADE GPS

(+) DENOTES LOCATION OF WELL ON UNITED STATES TOPOGRAPHIC MAPS WVDEP OFFICE OF OIL & GAS 601 57TH STREET CHARLESTON, WV 25304

Well Type: ☐ Oil ☐ Waste Diposal ☐ Production ☐ Deep ☒ Gas ☐ Liquid Injection ☐ Storage ☒ Shallow

WATERSHED: DUNKARD CREEK

COUNTY/DISTRICT: MONONGALIA / BATTELLE

SURFACE OWNER: Phoenix Energy Resources, LLC

OIL & GAS ROYALTY OWNER: Phoenix Energy Resources, LLC, et al.

LEASE NUMBERS:

DRILL ☒ CONVERT ☐ DRILL DEEPER ☐ REDRILL ☐ FRACTURE OR STIMULATE ☒
PLUG OFF FORMATION ☐ PERFORATE NEW FORMATION ☐ PLUG & ABANDON ☐
CLEAN OUT & REPLUG ☐ OTHER CHANGE ☐ (SPECIFY):

TARGET FORMATION: MARCELLUS

WELL OPERATOR: NORTHEAST NATURAL ENERGY LLC

ADDRESS: 707 VIRGINIA STREET EAST, SUITE 1200

CITY: CHARLESTON STATE: WV ZIP CODE: 25301

DRILLED DEPTH: TVD: 7,994' TMD: 22,548'

DESIGNATED AGENT: JOHN ADAMS

ADDRESS: 707 VIRGINIA STREET EAST, SUITE 1200

CITY: CHARLESTON STATE: WV ZIP CODE: 25301

I, THE UNDERSIGNED, HEREBY CERTIFY THAT THIS PLAT IS CORRECT TO THE BEST OF MY KNOWLEDGE AND BELIEF AND SHOWS ALL THE INFORMATION REQUIRED BY LAW AND THE REGULATIONS ISSUED AND PRESCRIBED BY THE DEPARTMENT OF ENVIRONMENTAL PROTECTION.

Signed:

L.L.S. #2124 : Ernest J. Benchek III

DATE: JULY 8, 2026

OPERATOR'S WELL #: ERP 3H AS-DRILLED

API WELL #: 47 61 02011
STATE COUNTY PERMIT

AS-BUILT ELEVATION: 1,338.6'

QUADRANGLE: WADSWORTH

ACREAGE: 946.937 +/-

ACREAGE: 157.502 +/-



	PROPERTY OWNER INDEX
1-7-6.1	GRACE FELLOWSHIP S B C
1-7-7	GRACE FELLOWSHIP S B C
1-7-7.1	EAKIN-WANA CEMETERY
1-7-8.1	RYAN & RACHEL LEMLEY
1-7-17	RICHARD A & LINDA S WADE
1-7-19	WILLIAM C, REBECCA L CROSS; FRODELIUS & TAMELA D CROSS
1-7-20	RICKY LEE & KATHRYN CROSS
1-7-20.1	DEBORAH L SIMPSON
1-7-20.2	DOUGLAS M CURRENCE
1-7-20.4	DEBORAH LYNN SIMPSON
1-7-20.5	KEITH A AMMONS
1-7-20.6	KEITH A AMMONS
1-7-20.7	KEITH A AMMONS
1-7-22	RANDY A HENNEN
1-7-24	RANDY STILES & KAREN CHURCH (LIFE RAYMOND O STILES)
1-7-24.1	RANDY STILES & KAREN CHURCH (LIFE RAYMOND O STILES)
1-7-24.2	JEFFREY W & AMBER J CROPPER
1-7-24.3	JON WILLIAM & SAVANNA FLEEMAN
1-7-26	RANDY A & BETH A STILES
1-8-30	CONSOL MINING COMPANY LLC
1-14-13	JOSEPH CARL & SUSAN E TOOTHMAN
1-14-15	EDWARD L TENNANT
1-14-17	RANDELL LEE LANTZ
1-14-18	NORMA J & FREDDIE WAYNE WILLIAMS
1-14-19	NORMA WILLIAMS
1-14-19.1	PHOENIX FEDERAL MINING COMPLEX LLC
1-17-14	PHOENIX FEDERAL MINING COMPLEX LLC

RECEIVED
Office of Oil and Gas

AUG 03 2026

WV Department of
Environmental Protection

	LEASE INDEX		
A	WV-061-005667-001	K	WV-061-005924-001
B	WV-061-005667-001	L	WV-061-005925-001
C	WV-061-005697-001	M	WV-061-005924-001
D	WV-061-006663-002	N	WV-061-006307-001
E	WV-061-005843-009	O	WV-061-006430-003
F	WV-061-005842-008	P	WV-061-000195-001-JOA
G	WV-061-005805-001	Q	WV-061-000195-001-JOA
H	WV-061-000195-001-JOA	R	WV-061-000195-001-JOA
I	WV-061-006789-001	S	WV-061-006689-001
J	WV-061-005947-001		

08/28/2026

FILE #: NEE20

DRAWING #: 3058

SCALE: N/A

DATE: JULY 8, 2026

OPERATOR'S WELL #: ERP 3H AS-DRILLED

API WELL #: 47 61 02011
STATE COUNTY PERMIT