


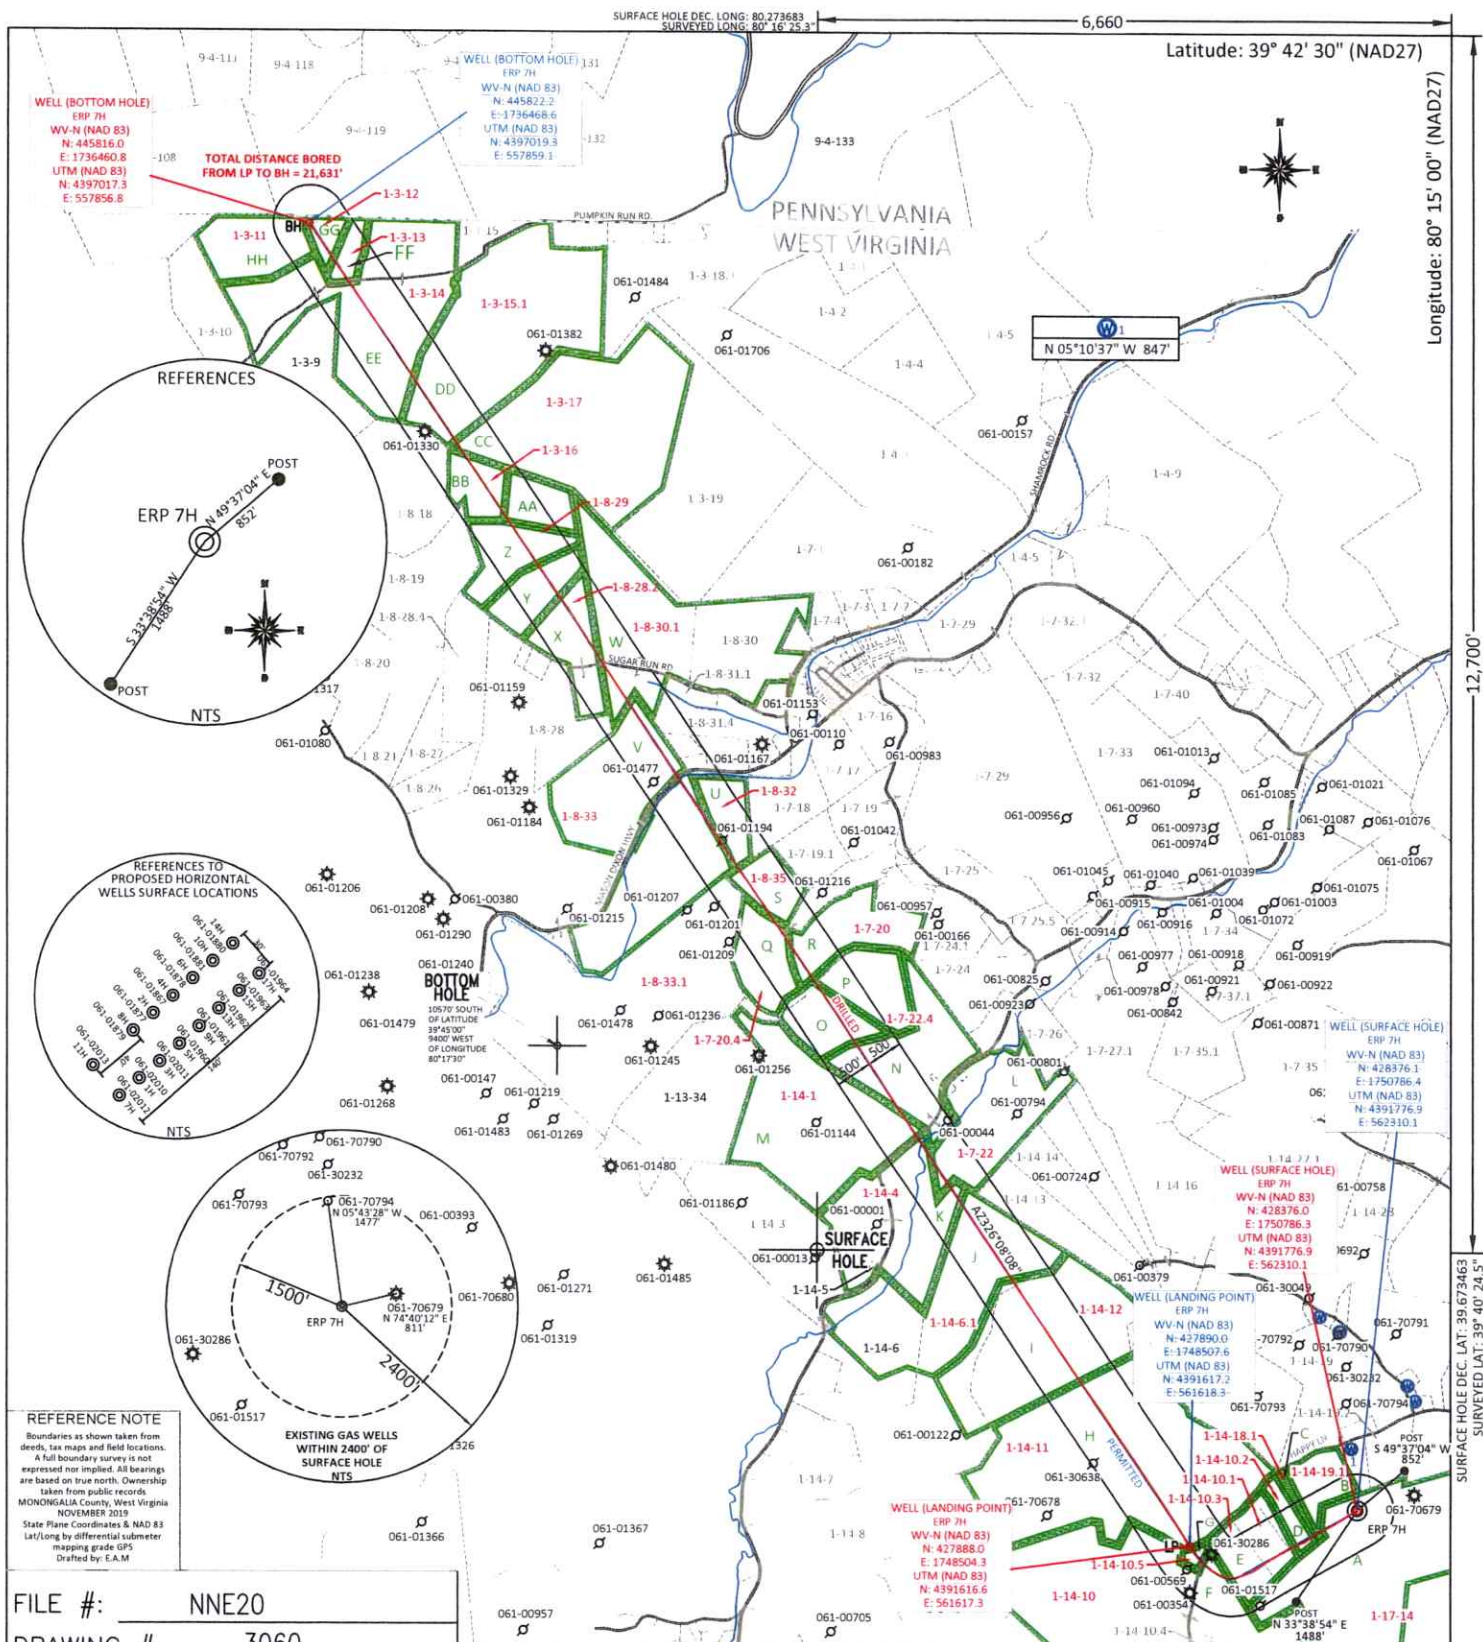

FILE #: NNE20

DRAWING #: 3060

SCALE: PLAT: 1" = 2600'
TICK: 1" = 2000'

MINIMUM DEGREE
OF ACCURACY: 1/200

PROVEN SOURCE SUBMETER MAPPING
OF ELEVATION: GRADE GPS

I, THE UNDERSIGNED, HEREBY CERTIFY THAT THIS
PLAT IS CORRECT TO THE BEST OF MY KNOWLEDGE AND
BELIEF AND SHOWS ALL THE INFORMATION REQUIRED BY
LAW AND THE REGULATIONS ISSUED AND PRESCRIBED BY
THE DEPARTMENT OF ENVIRONMENTAL PROTECTION.

Signed: 

L.L.S. #2124 : Ernest J. Benchek III



(+) DENOTES LOCATION OF WELL ON UNITED STATES TOPOGRAPHIC MAPS
WVDEP
OFFICE OF OIL & GAS
601 57TH STREET
CHARLESTON, WV 25304
Well Type: ☐ Oil ☐ Waste Disposal
☒ Gas ☐ Liquid Injection
WATERSHED: _____ DUNKARD CREEK
COUNTY/DISTRICT: _____ MONONGALIA /
SURFACE OWNER: _____
OIL & GAS ROYALTY OWNER: _____
LEASE NUMBERS: _____

DRILL ☒ CONVERT ☐ DRILL DEEPER ☐ REDRILL ☐ FRACTURE OR STIMULATE ☒
 PLUG OFF FORMATION ☐ PERFORATE NEW FORMATION ☐ PLUG & ABANDON ☐
 CLEAN OUT & REPLUG ☐ OTHER CHANGE ☐ (SPECIFY): _____
 TARGET FORMATION: MARCELLUS DRILLED DEPTH: TVD: 7,939' TMD: 30,471'
 WELL OPERATOR: NORTHEAST NATURAL ENERGY LLC DESIGNATED AGENT: JOHN ADAMS
 ADDRESS: 707 VIRGINIA STREET EAST, SUITE 1200 ADDRESS: 707 VIRGINIA STREET EAST, SUITE 1200
 CITY: CHARLESTON STATE: WV ZIP CODE: 25301 CITY: CHARLESTON STATE: WV ZIP CODE: 25301

DATE: JULY 8, 2026

OPERATOR'S WELL #: ERP 7H AS-DRILLED

API WELL #: 47 61 02012

STATE COUNTY PERMIT

AS-BUILT
ELEVATION: 1,338.6'

C QUADRANGLE: WADESTOWN

at al. ACREAGE: 1729.124 +/-

ACREAGE: 157.502 +/-

08/28/2026

08/28/2026

PROPERTY OWNER INDEX	
1-3-11	CONSOL MINING COMPANY LLC
1-3-12	JAMES EDWARD & EARL LYNN TAYLOR
1-3-13	JAMES EDWARD & EARL LYNN TAYLOR
1-3-14	JAMES EDWARD & EARL LYNN TAYLOR
1-3-15.1	JAMES EDWARD & EARL LYNN TAYLOR
1-3-16	CNX LAND LLC
1-3-17	CNX LAND LLC
1-8-28.2	ROBERT C MCCLURE; LIFE: HAROLD N. MCCLURE
1-8-29	CNX LAND LLC
1-8-30.1	CONSOL MINING COMPANY LLC
1-8-32	RIFF ALLEN HENNEN
1-8-33	CNX LAND LLC
1-8-33.1	MASON DIXON HWY
1-8-35	BROOKS FORD LLC
1-7-20	RICKY LEE & KATHRYN CROSS
1-7-20.4	DEBORAH LYNN SIMPSON
1-7-22	RANDY A HENNEN
1-7-22.4	ROBERT DARRYL HENNEN
1-14-1	DAVID NEIL, DONALD HOWARD; DONALD RALPH & SANDRA LYNN PORTER
1-14-4	SHERRY HARKER
1-14-6.1	4 BROTHERS LLC
1-14-10	MICHAEL A & ANITA K BRAGG (LIFE GEORGE H FOLEY)
1-14-10.1	MARK A & DEBRA WILLIAMS
1-14-10.2	DAVID W & CHERYL A WILLIAMS
1-14-10.3	ROGER E SWANSON
1-14-10.5	BRANDON BRAGG
1-14-11	RICHARD E SHRIVER
1-14-12	RUSSELL L & VIRGINIA M TOOTHMAN
1-14-18.1	NORMA WILLIAMS
1-14-19.1	PHOENIX FEDERAL MINING COMPLEX LLC
1-17-14	PHOENIX FEDERAL MINING COMPLEX LLC

LEASE INDEX			
A	WV-061-005667-001	R	WV-061-005925-001
B	WV-061-005667-001	S	WV-061-000195-001-JOA
C	WV-061-005696-001	T	WV-061-000195-001-JOA
D	WV-061-006394-001	U	WV-061-005855-001
E	WV-061-005329-015	V	WV-061-000195-001-JOA
F	WV-061-004505-012	W	WV-061-006689-001
G	WV-061-004505-012	X	WV-061-006296-001
H	WV-061-005836-005	Y	WV-061-000195-001-JOA
I	WV-061-000195-001-JOA	Z	WV-061-000195-001-JOA
J	WV-061-004334-002	AA	WV-061-000195-001-JOA
K	WV-061-005820-001	BB	WV-061-000195-001-JOA
L	WV-061-000195-001-JOA	CC	WV-061-005819-004
M	WV-061-004813-006	DD	WV-061-000195-001-JOA
	WV-061-004813-001	EE	WV-061-006965-001
N	WV-061-000195-001-JOA	FF	WV-061-006965-001
O	WV-061-005947-001	GG	WV-061-006965-001
P	WV-061-005947-001	HH	WV-061-000195-001-JOA
Q	WV-061-005924-001		

08/28/2026

FILE #: NEE20

DRAWING #: 3060

SCALE: N/A

DATE: JULY 8, 2026

OPERATOR’S WELL #: ERP 7H AS–DRILLED

API WELL #: 47 61 02012

STATE COUNTY PERMIT