

Antero Resources
Well No. Incline 2H
As-Drilled
Antero Resources Corporation

Page 1 of 2



Top Hole Coordinates, As-drilled data, and information was provided by Antero Resources Corporation. Allegheny Surveys Inc. (ASI) is not certifying the data and information provided. ASI is not responsible for any errors or inaccuracies with the data and information that has been provided.


I, the undersigned, hereby certify that this plat is correct to the best of my knowledge and belief and shows all the information required by law and the rules issued and prescribed by the Department of Environmental Protection.

Bradley D. Miller

Bradley D. Miller, P.S. 2167



SEAL

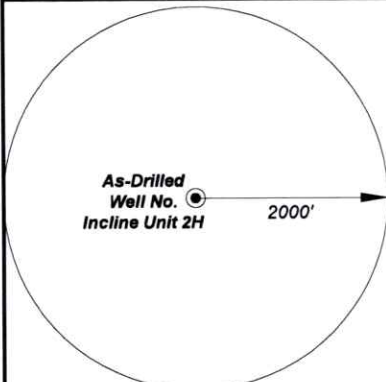


Note: No water wells were found within 2000' of proposed well. No occupied dwellings or buildings 2,500 square feet or larger used to house or shelter dairy cattle or poultry husbandry are located within 625' of the center of the well pad.

RECEIVED
Office of Oil and Gas


FEB 12 2026

WV Department of
Environmental Protection

Tag	Bearing	Dist.
L1	N 77°13' W	2,365.8'
L2	N 01°15' W	2,166.0'
L3	N 40°42' E	4,155.8'
L4	S 10°28' E	3,352.3'

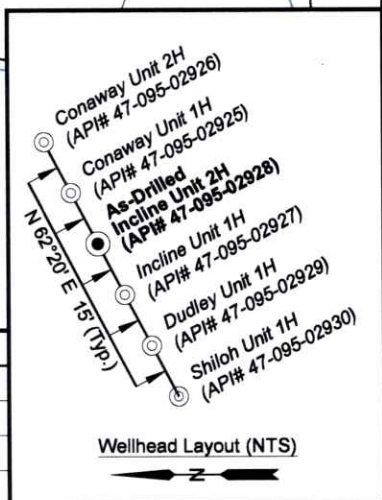

Wellhead Layout (NTS)

 

FILE NO: 170-54-U-23
DRAWING NO: Incline Unit 2H As-Drilled
SCALE: 1" = 2000'
MINIMUM DEGREE OF ACCURACY: Submeter
PROVEN SOURCE OF ELEVATION: WVDOT, Harrisville, WV

STATE OF WEST VIRGINIA
DEPARTMENT OF ENVIRONMENTAL PROTECTION
OIL AND GAS DIVISION

DATE: January 5 20 26
OPERATOR'S WELL NO. Incline Unit 2H
API WELL NO
47 - 095 - 02928
STATE COUNTY PERMIT

WELL TYPE: ☐ OIL ☒ GAS ☐ LIQUID INJECTION ☐ WASTE DISPOSAL
(IF GAS) PRODUCTION: ☐ STORAGE ☐ DEEP ☒ SHALLOW

LOCATION: ELEVATION: As-Built 694.76' WATERSHED: Outlet Middle Island Creek QUADRANGLE: Middlebourne

DISTRICT: Union

COUNTY: Tyler 05/01/2026

SURFACE OWNER: Jimmy E. & Earl P. Patterson & Linda Lou Dennis

ACREAGE: 68.22

ROYALTY OWNER: Linda Lou Dennis

LEASE NO: ACREAGE: 98.225

PROPOSED WORK: ☐ DRILL ☐ CONVERT ☐ DRILL DEEPER ☐ FRACTURE OR STIMULATE ☐ PLUG OFF OLD FORMATION
☐ PERFORATE NEW FORMATION ☒ OTHER PHYSICAL CHANGE IN WELL (SPECIFY) As-Drilled 5,904' TVD

☐ PLUG AND ABANDON ☐ CLEAN OUT AND REPLUG TARGET FORMATION: Marcellus Shale ESTIMATED DEPTH: 16,178' MD

WELL OPERATOR: Antero Resources Corporation

DESIGNATED AGENT: Conrad Baston

ADDRESS: 1615 Wynkoop Street
Denver, CO 80202

ADDRESS: 535 White Oaks Blvd.
Bridgeport, WV 26330

Antero Resources
Well No. Incline 2H
As-Drilled
Antero Resources Corporation

Page 2 of 2

Legend

- Proposed gas well
- Monument, as noted
- Existing Well, as noted
- Digitized Well, as noted
- Creek or Drain
- Road
- Surface boundary (approx.)
- Interior surface tracts (approx.)

Notes

West Virginia Coordinate System
of 1927, North Zone
based upon Differential GPS Measurements.
Well No. Incline Unit 2H Top Hole coordinates are
N: 361,919.32' Latitude: 39°29'02.62"
E: 1,578,497.62' Longitude: 80°59'36.33"
Bottom Hole coordinates are
N: 352,910.28' Latitude: 39°27'34.15"
E: 1,581,921.85' Longitude: 80°58'50.77"
UTM Zone 17, NAD 1983
Top Hole Coordinates Bottom Hole Coordinates
N: 4,370,504.208m N: 4,367,777.017m
E: 500,579.872m E: 501,668.903m
Plat orientation and corner and well references
are based upon the grid north meridian.
Well location references are based upon the magnetic
meridian.

Notes:

Well No. Incline Unit 2H
As-Drilled POE Coordinates
WV Coordinate System
of 1927, North Zone
N: 362,461.96'
E: 1,578,745.84'
Lat: 39°29'08.03"
Lon: 80°59'33.28"
UTM Zone 17, NAD 1983
N: 4,370,670.791m
E: 500,652.732m

RECEIVED
Office of Oil and Gas

FEB 12 2026

WV Department of
Environmental Protection

Detail 1 (1"=500')



ID	Lease
A	Linda Lou Dennis
B	Ted A. & Darlene K. Koerber
C	George Alan Starkey, et ux
E	Antero Minerals, LLC
F	Anthony D. Furbee
G	Antero Minerals, LLC
H	Barbara A. Fowler
I	Tyler Rod & Gun Club, Inc.
J	Herbert A. & Sandra K. McEowen, JTWROS
K	Kevin R. Roberts
L	FG, LLC
M	Five Star Resources
P	Paul E. Snider
R	BC Farms Investments, LLC
S	Jane Doan Schwab
Z	WV Dept. of Commerce, Division of Natural Resources

Tyler County				
No.	TM / Par	Owner	Bk/Pg	Ac.
1	9 / 8	Jimmy E. Patterson, et al	OR49 / 645	68.22
2	9 / 3	Gregory L. & Shirley F. Michael	357 / 131	293.00
3	9 / 7.2	Ted A. & Darlene K. Koerber	301 / 157	112.09
4	9 / 14	George A. & Yvonne Starkey	184 / 21	65.51
5	9 / 40	Gary & Joyce Hagerty	243 / 261	2.35
6	9 / 40.1	Patricia D. & Kenneth O. Thomas, Jr.	OR18 / 401	2.37
7	9 / 41	Harold D. Furbee Estate	OR80 / 332	7.97
8	9 / 41.1	Jason W. Roberts	OR63 / 783	1.00
9	9 / 42.1	Charles E. & Patsy J. Eddy	658 / 702	0.94
10	9 / 42.2	Alan D. Johnson	555 / 787	2.00
11	9 / 42	Donna L. Johnson	199 / 145	16.20
12	9 / 46	Tyler Rod & Gun Club	159 / 229	33.83
13	9 / 47	Coastal Forest Resources Co.	301 / 131	67.24
14	13 / 25.2	Herbert A. & Sandra K. McEowen	354 / 457	25.05
15	13 / 22	James E. & J. Thomas Keeder	399 / 343	35.00
16	13 / 24.1	James E. & Marsha Delancey	344 / 145	30.69
17	13 / 24.2	Marilyn & Mark Spiker, et al	569 / 276	31.13
18	13 / 25	Paul E. Snider	338 / 205	26.01
19	13 / 26	Paul E. Snider	189 / 412	83.62
20	13 / 27	George A. & Catherine E. Eddy	169 / 756	39.15
21	1 / 8	James P. Flishers	576 / 260	37.82
22	2 / 7	Fred Davis	341 / 606	58.41
23	1 / 3	Julie A. Taylor	OR7 / 737	110.00
24	1 / 2	Howard O. & Dawn C. Flishers	334 / 281	91.00

FILE NO: 170-54-U-23

DRAWING NO: Incline Unit 2H As-Drilled

SCALE: 1" = 2000'

MINIMUM DEGREE OF ACCURACY:
Submeter

PROVEN SOURCE OF ELEVATION:
WVDOT, Harrisville, WV

STATE OF WEST VIRGINIA
DEPARTMENT OF ENVIRONMENTAL PROTECTION
OIL AND GAS DIVISION

DATE: January 5 20 26

OPERATOR'S WELL NO. Incline Unit 2H

API WELL NO

47 - 095 - 02928
STATE COUNTY PERMIT

WELL TYPE: ☐ OIL ☒ GAS ☐ LIQUID INJECTION ☐ WASTE DISPOSAL
(IF GAS) PRODUCTION: ☐ STORAGE ☐ DEEP ☒ SHALLOW

LOCATION: ELEVATION: As-Built 694.76' WATERSHED: Outlet Middle Island Creek QUADRANGLE: Middlebourne

DISTRICT: Union

COUNTY: Tyler 05/01/2026

SURFACE OWNER: Jimmy E. & Earl P. Patterson & Linda Lou Dennis

ACREAGE: 68.22

ROYALTY OWNER: Linda Lou Dennis

LEASE NO: ACREAGE: 98.225

PROPOSED WORK: ☐ DRILL ☐ CONVERT ☐ DRILL DEEPER ☐ FRACTURE OR STIMULATE ☐ PLUG OFF OLD FORMATION
☐ PERFORATE NEW FORMATION ☒ OTHER PHYSICAL CHANGE IN WELL (SPECIFY) As-Drilled 5,904' TVD

☐ PLUG AND ABANDON ☐ CLEAN OUT AND REPLUG TARGET FORMATION: Marcellus Shale ESTIMATED DEPTH: 16,178' MD

WELL OPERATOR: Antero Resources Corporation

DESIGNATED AGENT: Conrad Baston

ADDRESS: 1615 Wynkoop Street
Denver, CO 80202

ADDRESS: 535 White Oaks Blvd.
Bridgeport, WV 26330