

Antero Resources
Well No. Dudley 1H
As-Drilled
Antero Resources Corporation

Page 1 of 3




Top Hole Coordinates, As-drilled data, and information was provided by Antero Resources Corporation. Allegany Surveys Inc. (ASI) is not certifying the data and information provided. ASI is not responsible for any errors or inaccuracies with the data and information that has been provided.

I, the undersigned, hereby certify that this plat is correct to the best of my knowledge and belief and shows all the information required by law and the rules issued and prescribed by the Department of Environmental Protection.

Bradley D. Miller
Bradley D. Miller, P.S. 2167



SEAL

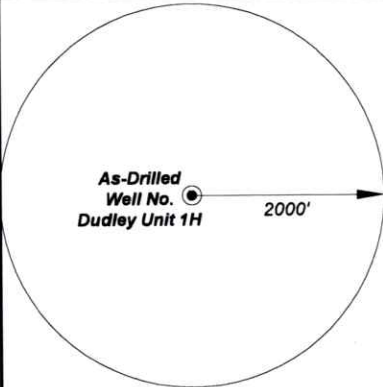

Note: No water wells were found within 2000' of proposed well. No occupied dwellings or buildings 2,500 square feet or larger used to house or shelter dairy cattle or poultry husbandry are located within 625' of the center of the well pad.

FILE NO: 171-54-U-23

DRAWING NO: Dudley Unit 1H As-drilled

SCALE: 1" = 2000'

MINIMUM DEGREE OF ACCURACY:
Submeter

PROVEN SOURCE OF ELEVATION:
WVDOT, Harrisville, WV

STATE OF WEST VIRGINIA
DEPARTMENT OF ENVIRONMENTAL PROTECTION
OIL AND GAS DIVISION

DATE: January 5 20 26

OPERATOR'S WELL NO: Dudley Unit 1H

API WELL NO

47 - 095 - 02929
STATE COUNTY PERMIT

WELL TYPE: ☐ OIL ☒ GAS ☐ LIQUID INJECTION ☐ WASTE DISPOSAL
(IF GAS) PRODUCTION: ☐ STORAGE ☐ DEEP ☒ SHALLOW

LOCATION: ELEVATION: As-Built 694.76' WATERSHED: Outlet Middle Island Creek QUADRANGLE: Middlebourne

DISTRICT: Union

COUNTY: Tyler 05/01/2026

SURFACE OWNER: Jimmy E. & Earl P. Patterson & Linda Lou Dennis

ACREAGE: 68.22

ROYALTY OWNER: Linda Lou Dennis

LEASE NO: ACREAGE: 98.225

PROPOSED WORK: ☐ DRILL ☐ CONVERT ☐ DRILL DEEPER ☐ FRACTURE OR STIMULATE ☐ PLUG OFF OLD FORMATION
☐ PERFORATE NEW FORMATION ☒ OTHER PHYSICAL CHANGE IN WELL (SPECIFY) As-Drilled 5,881' TVD


☐ PLUG AND ABANDON ☐ CLEAN OUT AND REPLUG TARGET FORMATION: Marcellus Shale ESTIMATED DEPTH: 15,500' MD

WELL OPERATOR: Antero Resources Corporation


DESIGNATED AGENT: Conrad Baston

ADDRESS: 1615 Wynkoop Street
Denver, CO 80202

ADDRESS: 535 White Oaks Blvd.
Bridgeport, WV 26330

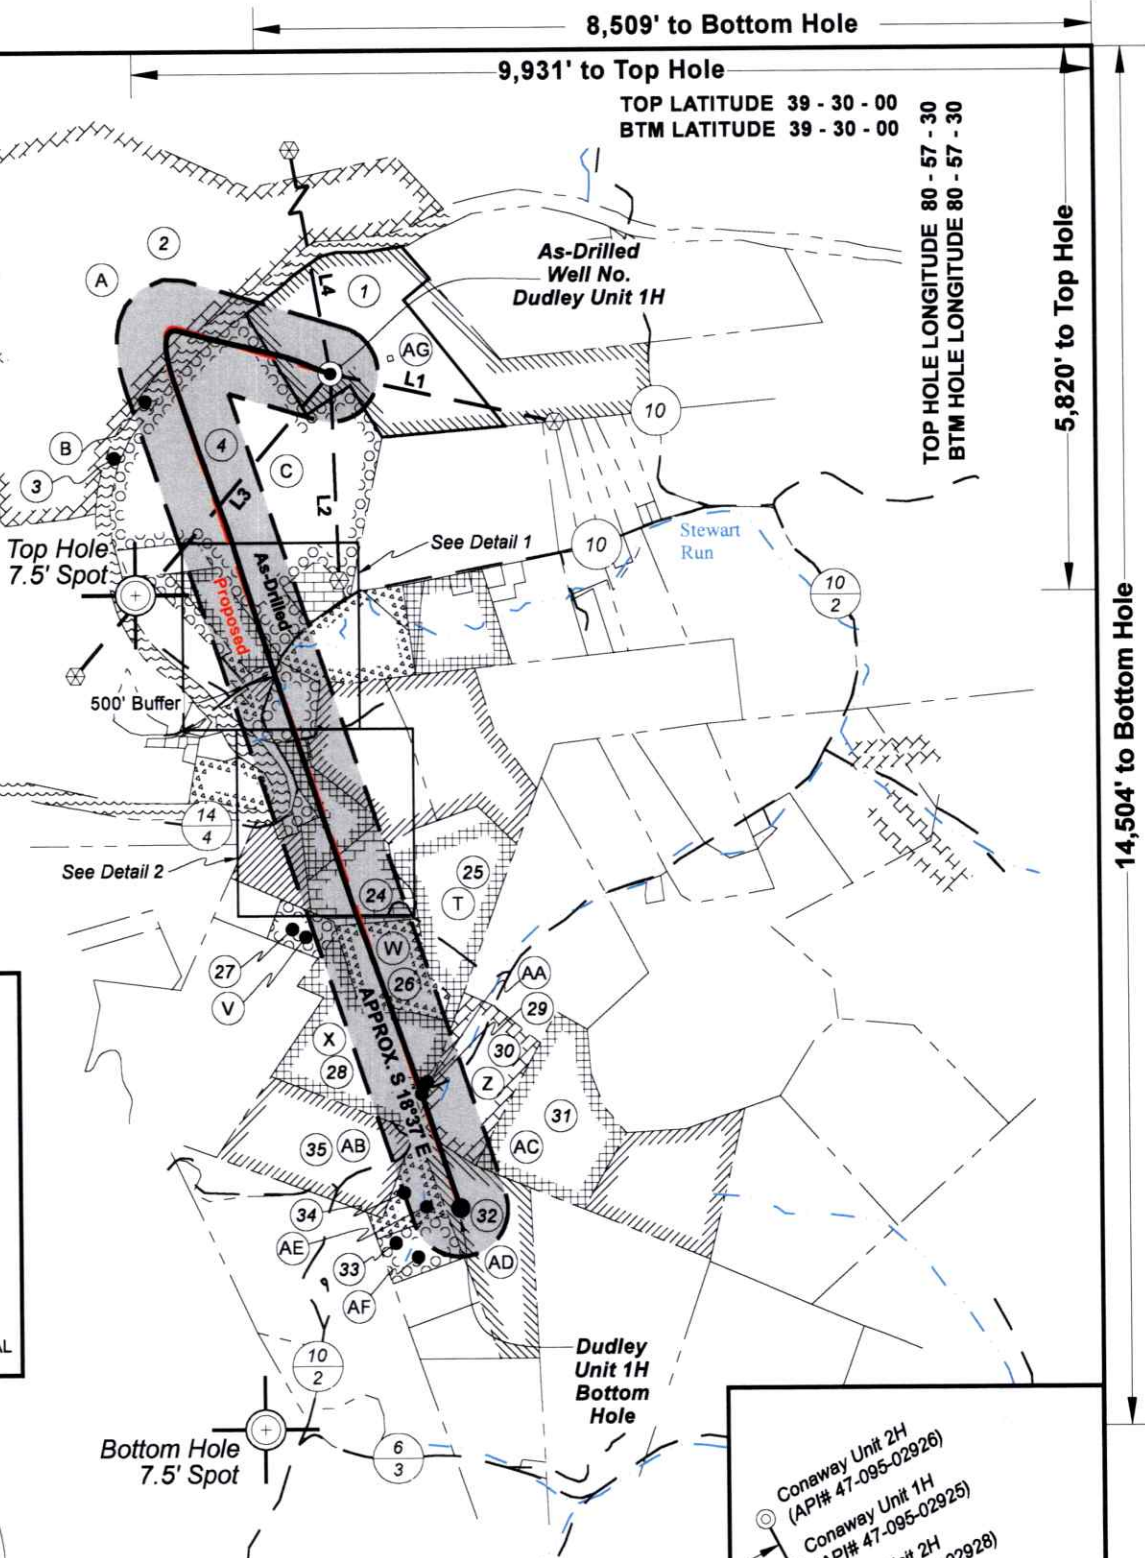

Tag	Bearing	Dist.
L1	N 77°41' W	2,388.6'
L2	N 01°58' W	2,152.6'
L3	N 40°33' E	4,127.7'
L4	S 09°59' E	3,361.6'

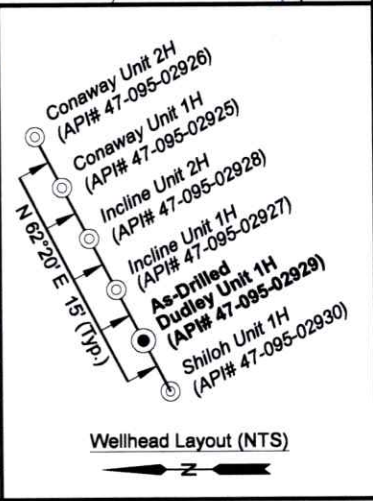

Antero Resources
Well No. Dudley 1H
As-Drilled
Antero Resources Corporation

Page 2 of 3

Legend

- Proposed gas well
- Monument, as noted
- Existing Well, as noted
- Digitized Well, as noted
- Creek or Drain
- Road
- Surface boundary (approx.)
- Interior surface tracts (approx.)


Notes

West Virginia Coordinate System
of 1927, North Zone
based upon Differential GPS Measurements.
Well No. Dudley Unit 1H Top Hole coordinates are
N: 361,905.09' Latitude: 39°29'02.48"
E: 1,578,471.08' Longitude: 80°59'36.67"
Bottom Hole coordinates are
N: 353,199.24' Latitude: 39°27'36.65"
E: 1,579,751.67' Longitude: 80°59'18.50"
UTM Zone 17, NAD 1983
Top Hole Coordinates Bottom Hole Coordinates
N: 4,370,499.737m N: 4,367,853.992m
E: 500,571.859m E: 501,006.283m
Plat orientation and corner and well references
are based upon the grid north meridian.
Well location references are based upon the magnetic
meridian.

Notes:

Well No. Dudley Unit 1H
As-Drilled POE Coordinates
WV Coordinate System
of 1927, North Zone
N: 361,887.22'
E: 1,576,824.51'
Lat: 39°29'02.03"
Lon: 80°59'57.66"
UTM Zone 17, NAD 1983
N: 4,370,485.903m
E: 500,070.317m

Detail 1 (1"=500')

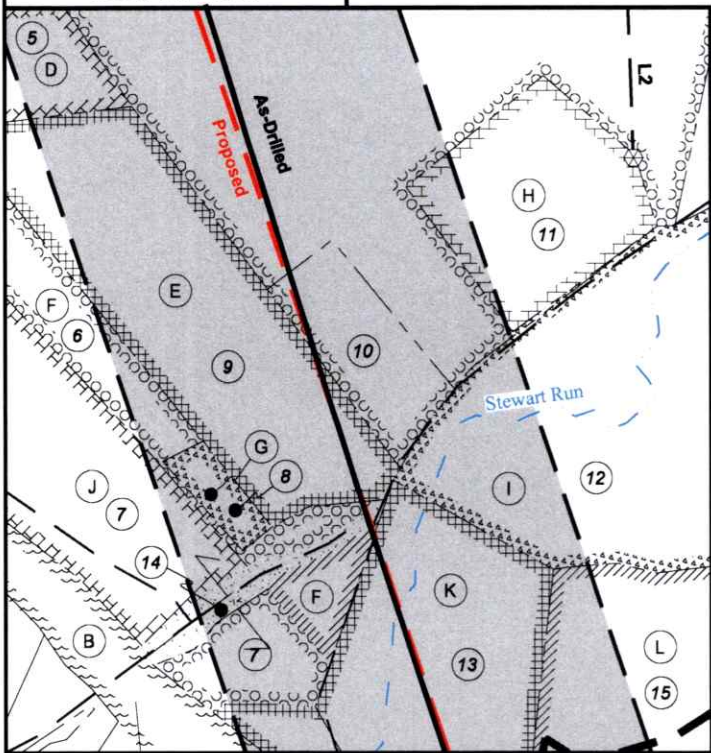

Detail 2 (1"=500')



FILE NO: 171-54-U-23

DRAWING NO: Dudley Unit 1H As-drilled

SCALE: 1" = 2000'

MINIMUM DEGREE OF ACCURACY:
Submeter

PROVEN SOURCE OF ELEVATION:
WVDOT, Harrisville, WV

STATE OF WEST VIRGINIA
DEPARTMENT OF ENVIRONMENTAL PROTECTION
OIL AND GAS DIVISION

DATE: January 5 20 26

OPERATOR'S WELL NO. Dudley Unit 1H

API WELL NO

47 - 095 - 02929

STATE COUNTY PERMIT

WELL TYPE: ☐ OIL ☒ GAS ☐ LIQUID INJECTION ☐ WASTE DISPOSAL
(IF GAS) PRODUCTION: ☐ STORAGE ☐ DEEP ☒ SHALLOW

LOCATION: ELEVATION: As-Built 694.76' WATERSHED: Outlet Middle Island Creek QUADRANGLE: Middlebourne

DISTRICT: Union

COUNTY: Tyler 05/01/2026

SURFACE OWNER: Jimmy E. & Earl P. Patterson & Linda Lou Dennis

ACREAGE: 68.22

ROYALTY OWNER: Linda Lou Dennis LEASE NO: ACREAGE: 98.225

PROPOSED WORK: ☐ DRILL ☐ CONVERT ☐ DRILL DEEPER ☐ FRACTURE OR STIMULATE ☐ PLUG OFF OLD FORMATION
☐ PERFORATE NEW FORMATION ☒ OTHER PHYSICAL CHANGE IN WELL (SPECIFY) As-Drilled 5,881' TVD

☐ PLUG AND ABANDON ☐ CLEAN OUT AND REPLUG TARGET FORMATION: Marcellus Shale ESTIMATED DEPTH: 15,500' MD

WELL OPERATOR: Antero Resources Corporation

DESIGNATED AGENT: Conrad Baston

ADDRESS: 1615 Wynkoop Street
Denver, CO 80202

ADDRESS: 535 White Oaks Blvd.
Bridgeport, WV 26330

ID	Lease
A	Gregory & Shirley Michael
B	WVDNR
C	Ted A. & Darlene K. Koerber, JTWROS
D	Arlington Cabins, Inc.
E	Paul Thomas Gist, Jr. & Patricia Jo Gist, JTWROS
F	Linda Sue Hayes
G	Christopher B. Kemp
H	Kathy Sue Herron
I	Antero Minerals, LLC
J	Arlington Cabins, Inc.
K	Donna L. Johnson
L	Tyler Rod & Gun Club, Inc.
N	Trustees of the Little United Methodist Church
O	Delbert E. Taylor
P	Allen R. Ladie
Q	Paul E. Snider
R	Daniel A. Maxwell
S	David O. Morris
T	Five Star Resources
V	BC Farms Investments, LLC
W	Linda L. Melvin & Richard Melvin
X	James Arthur Watson & Angel C. Watson
Z	Catherine E. Eddy
AA	Richard W. Parker
AB	Martha Warner, AIF for Anna M. Brown
AC	BC Farms Investments, LLC
AD	Catherine E. Eddy
AE	Catherine E. Eddy
AF	Kevin Ray Roberts
AG	Linda Lou Dennis

Tyler County				
No.	TM / Per	Owner	BK / Pg	Ac.
1	9 / 8	Jimmy E. Patterson, et al	OR49 / 645	68.22
2	9 / 3	Gregory L. & Shirley F. Michael	357 / 131	293.00
3		Middle Island Creek		
4	9 / 7.2	Ted A. & Darlene K. Koerber	301 / 157	112.09
5	9 / 7.4	Arlington Cabins	333 / 200	5.66
6	9 / 39	Teddy A. Kemp	OR183 / 560	5.59
7	9 / 38	Arlington Cabins	296 / 16	13.80
8	9 / 39.1	Christopher B. Kemp	359 / 99	0.74
9	9 / 7.1	Paul Thomas Gist, Jr. & Patricia Jo Gist	349 / 197	11.03
10	9 / 7.3	Ted A. Koerber	301 / 582	2.75
11	9 / 7	Kathy S. Herron	351 / 545	5.47
12	9 / 40.2	Richard Danser	626 / 19	20.00
13	9 / 44	Larry A. & Linda S. Hayes	290 / 482	7.50
14	9 / 38	WV DOT	332 / 10	0.49
15	9 / 45	Tyler Rod & Gun Club	167 / 143	33.77
16	9 / 45.1	The Little Cemetery Association	297 / 391	0.11
17	9 / 50	Laymen Reed, et al, Trustees of the United Methodist Church of Little WV	196 / 357	14.48
18	13 / 79	Delbert E. Alta Mee Taylor	336 / 478	2.60
19	9 / 37	Allen R. & David R. Ladie	317 / 289	9.15
20	9 / 49	Paul E. Snider	175 / 343	1.65
21	13 / 20	Paul E. Snider	316 / 316	0.68
22	13 / 18	Robert W. & Kimberly D. Maxwell	652 / 319	0.43
23	13 / 19	Kimberly Dawn & Robert Wayne Maxwell	334 / 17	11.16
24	13 / 21	Melissa Gail Mullenix & Jessica Gail Brown	355 / 679	17.15
25	13 / 22	James E. & J. Thomas Keeder	399 / 343	35.00
26	13 / 23	Linda L. Melvin et al	WB50 / 108	18.04
27	13 / 17	Laura Elsie Wilcox	207 / 249	6.50
28	13 / 28	James A. Watson	338 / 132	41.90
29	13 / 28.1	Richard W. Parker	347 / 201	1.10
30	13 / 24	Larry Moore	593 / 324	28.56
31	13 / 27	George A. & Catherine E. Eddy	169 / 756	39.15
32	1 / 7.1	George A. & Catherine E. Eddy	OR16 / 756	34.36
33	1 / 7.3	Kevin Ray Roberts	327 / 606	8.82
34	1 / 7.2	Carolyn G. Flannery	OR169 / 756	8.83
35	13 / 29	Aaron C. & Kelly J. Cecil	345 / 569	40.00

FILE NO: 171-54-U-23

DRAWING NO: Dudley Unit 1H As-drilled

SCALE: 1" = 2000'

MINIMUM DEGREE OF ACCURACY:
Submeter

PROVEN SOURCE OF ELEVATION:
WVDOT, Harrisville, WV

STATE OF WEST VIRGINIA
DEPARTMENT OF ENVIRONMENTAL PROTECTION
OIL AND GAS DIVISION

DATE: January 5 20 26

OPERATOR'S WELL NO. Dudley Unit 1H

API WELL NO

47 - 095 - 02929

STATE COUNTY PERMIT

WELL TYPE: ☐ OIL ☒ GAS ☐ LIQUID INJECTION ☐ WASTE DISPOSAL
(IF GAS) PRODUCTION: ☐ STORAGE ☐ DEEP ☒ SHALLOW

LOCATION: ELEVATION: As-Built 694.76' WATERSHED: Outlet Middle Island Creek QUADRANGLE: Middlebourne

DISTRICT: Union

COUNTY: Tyler 05/01/2026

SURFACE OWNER: Jimmy E. & Earl P. Patterson & Linda Lou Dennis

ACREAGE: 68.22

ROYALTY OWNER: Linda Lou Dennis

LEASE NO: ACREAGE: 98.225

PROPOSED WORK: ☐ DRILL ☐ CONVERT ☐ DRILL DEEPER ☐ FRACTURE OR STIMULATE ☐ PLUG OFF OLD FORMATION
☐ PERFORATE NEW FORMATION ☒ OTHER PHYSICAL CHANGE IN WELL (SPECIFY) As-Drilled 5,881' TVD

☐ PLUG AND ABANDON ☐ CLEAN OUT AND REPLUG TARGET FORMATION: Marcellus Shale ESTIMATED DEPTH: 15,500' MD

WELL OPERATOR: Antero Resources Corporation

DESIGNATED AGENT: Conrad Baston

ADDRESS: 1615 Wynkoop Street
Denver, CO 80202

ADDRESS: 535 White Oaks Blvd.
Bridgeport, WV 26330