

Antero Resources  
Well No. Eleanor 1H  
As Drilled  
Antero Resources Corporation

Page  
1 of 2



Legend


- Proposed gas well
- Monument, as noted
- Existing Well, as noted
- Digitized Well, as noted
- Creek or Drain
- Road
- Surface boundary (approx.)
- Interior surface tracts (approx.)

I, the undersigned, hereby certify that this plat is correct to the best of my knowledge and belief and shows all the information required by law and the rules issued and prescribed by the Department of Environmental Protection.

*Bradley D. Miller*  
Bradley D. Miller, P.S. 2167



SEAL

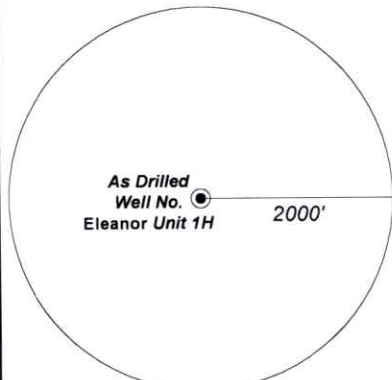

Note: No water wells were found within 2000' of proposed well. No occupied dwellings or buildings 2,500 square feet or larger used to house or shelter dairy cattle or poultry husbandry are located within 625' of the center of the well pad.

FILE NO: 157-54-L-23

DRAWING NO: Eleanor Unit 1H As Drilled

SCALE: 1" = 2000'

MINIMUM DEGREE OF ACCURACY:  
Submeter

PROVEN SOURCE OF ELEVATION:  
WVDOT, Harrisville, WV

STATE OF WEST VIRGINIA  
DEPARTMENT OF ENVIRONMENTAL PROTECTION  
OIL AND GAS DIVISION

DATE: March 9 2026

OPERATOR'S WELL NO. Eleanor Unit 1H

API WELL NO

47 - 095 - 02932  
STATE COUNTY PERMIT

WELL TYPE: ☐ OIL ☒ GAS ☐ LIQUID INJECTION ☐ WASTE DISPOSAL  
(IF GAS) PRODUCTION: ☐ STORAGE ☐ DEEP ☒ SHALLOW

LOCATION: ELEVATION: As-Built 1,092' WATERSHED: Outlet Middle Island Creek QUADRANGLE: Paden City

DISTRICT: Lincon

COUNTY: Tyler

SURFACE OWNER: Robert F. Scardina & Rita K. Scardina

ACREAGE: 25.00

ROYALTY OWNER: Robert F. Scardina & Rita K. Scardina

LEASE NO: ACREAGE: 25

PROPOSED WORK: ☐ DRILL ☐ CONVERT ☐ DRILL DEEPER ☐ FRACTURE OR STIMULATE ☐ PLUG OFF OLD FORMATION  
☐ PERFORATE NEW FORMATION ☒ OTHER PHYSICAL CHANGE IN WELL (SPECIFY) As Drilled

☐ PLUG AND ABANDON ☐ CLEAN OUT AND REPLUG TARGET FORMATION: Marcellus Shale ESTIMATED DEPTH: 17,684' MD 6,204' TVD

WELL OPERATOR: Antero Resources Corporation

DESIGNATED AGENT: Conrad Baston

ADDRESS: 1615 Wynkoop Street

ADDRESS: 535 White Oaks Blvd.

Denver, CO 80202

Bridgeport, WV 26330

|    | Bearing    | Dist.    |
|----|------------|----------|
| L1 | S 35°01' W | 1,146.3' |
| L2 | S 04°26' E | 1,290.3' |
| L3 | S 87°56' E | 1,555.2' |
| L4 | N 63°36' E | 1,193.1' |

Top Hole Coordinates, As-drilled data, and information was provided by Antero Resources Corporation. Allegheny Surveys Inc. (ASI) is not certifying the data and information provided. ASI is not responsible for any errors or inaccuracies with the data and information that has been provided.

BHL LATITUDE 39 - 37 - 30  
THL LATITUDE 39 - 35 - 00

LONGITUDE 80 - 55 - 00

11,585' to Bottom Hole

5,712' to Top Hole

10,115' to Bottom Hole

3,728' to Top Hole

Eleanor Unit 1H  
Bottom Hole

See Detail "A"

See Detail "B"

BTM Hole  
7.5' Spot

Top Hole  
7.5' Spot

Notes

West Virginia Coordinate System of 1927, North Zone based upon Differential GPS Measurements.  
Well No. Eleanor Unit 1H Top Hole coordinates are  
N: 392,066.46' Latitude: 39°34'03.52"  
E: 1,596,918.28' Longitude: 80°55'47.53"  
Bottom Hole coordinates are  
N: 401,469.33' Latitude: 39°35'35.45"  
E: 1,590,671.22' Longitude: 80°57'09.24"  
UTM Zone 17, NAD 1983  
Top Hole Coordinates Bottom Hole Coordinates  
N: 4,379,782.574m N: 4,382,615.397m  
E: 506,038.636m E: 504,087.679m  
Plat orientation and corner and well references are based upon the grid north meridian.  
Well location references are based upon the magnetic meridian.

Notes:

Well No. Eleanor Unit 1H As-Drilled POE Coordinates WV Coordinate System of 1927, North Zone  
N: 391,466.72'  
E: 1,594,054.72'  
Latitude: 39°33'57.14"  
Longitude: 80°56'23.97"  
UTM Zone 17, NAD 1983  
N: 4,379,585.270m  
E: 505,169.283m



Wellhead Layout (NTS)

- Grey Unit 2H (API# 47-095-02935)
- Grey Unit 1H (API# 47-095-02934)
- Izabela Unit 2H (API# 47-095-02937)
- Izabela Unit 1H (API# 47-095-02936)
- Eleanor Unit 2H (API# 47-095-02933)
- As Drilled Eleanor Unit 1H (API# 47-095-02932)



| Leases |                                          |
|--------|------------------------------------------|
| A      | Paul Wissmach Glass Company              |
| C      | Albert Merton & Barbara Jo Mohrman       |
| D      | Golden Eagle Resources II, LLC           |
| F      | Henry P. Snyder, et al                   |
| G      | Stanley E. Dennis & Edith L. Dennis, h/w |
| H      | Michael J. Hough                         |
| I      | John Stanley Starkey                     |
| J      | Antero Minerals, LLC                     |
| K      | OCTO Energy                              |
| L      | Eagle Investments, LLC                   |
| N      | Ralph Mikes or Dora Mikes, h/w           |
| O      | Virgil L. Cooper & Tracie J. Cooper      |
| P      | Virgil E. Cooper, et al                  |
| Q      | Greenbrier Royalty Fund II, LLC          |
| R      | Karen Lynn Shreves                       |
| S      | John L. Renner, II                       |
| T      | William J. Patterson, Life Tenant, et al |
| U      | Maxine Ankrom                            |
| W      | Janice Eddy                              |
| X      | Shirley Myers                            |
| Y      | Moore Self Storage, North Carolina, LLC  |
| AA     | Robert F. & Rita K. Scardina             |
| AB     | BRC Appalachian Minerals I, LLC          |
| AC     | Robert F. & Rita K. Scardina, et ux      |
| AD     | Robert F. & Rita K. Scardina, et ux      |
| AE     | Robert F. & Rita K. Scardina, et ux      |
| AF     | Robert F. & Rita K. Scardina, et ux      |
| AG     | AMP IV, LP                               |

| ID | TM-Par | Owner                                   | Bk/Pg     | Acres  |
|----|--------|-----------------------------------------|-----------|--------|
| 1  | xx-xx  | Owner                                   | xx/xx     | x.xx   |
| 2  | 3-157  | Paul Wissmach Glass Co.                 | 224/252   | 7.00   |
| 3  | 1-2    | Albert Merton & Barbara Jo Mohrman      | 399/329   | 5.18   |
| 4  | 1-3    | Albert Merton & Barbara Jo Mohrman      | 399/329   | 17.50  |
| 5  | 1-4    | Haessly Hardwood Lumber Co.             | 290/457   | 166.20 |
| 6  | 1-21   | Stanley E. & Edith L. Dennis            | 350/414   | 77.71  |
| 7  | 4-56   | Stanley E. & Edith L. Dennis            | 394/61    | 11.75  |
| 8  | 4-57   | Delmer D. & Louanna G. Hough            | 306/520   | 11.64  |
| 9  | 4-59   | Jason & Lindsey Snider                  | 395/344   | 7.00   |
| 10 | 4-60   | Sharon Lee Ellison                      | WB44/190  | 7.00   |
| 11 | 4-61   | Carl D. O'Neil                          | 133/175   | 18.81  |
| 12 | 4-63   | Eagle Hardwood Inc.                     | 345/195   | 16.79  |
| 13 | 4-65.1 | Carl D. O'Neil                          | WB36/381  | 13.26  |
| 14 | 4-82.2 | Virgil L. & Tracie J. Cooper            | 333/220   | 4.46   |
| 15 | 4-82.4 | Virgil L. & Tracie J. Cooper            | 444/521   | 13.00  |
| 16 | 4-58   | Patrick & Shirley A. Lancaster          | 270/272   | 108.00 |
| 17 | 4-83   | Karen Lynn Wright                       | 358/404   | 1.00   |
| 18 | 4-85.1 | Karen L. Cooper                         | 262/48    | 0.75   |
| 19 | 4-85   | Patrick & Shirley A. Lancaster          | 212/376   | 86.22  |
| 20 | 4-82   | Virgil E. Cooper                        | 199/41    | 10.90  |
| 21 | 4-82.1 | Ricky & Barbra Keys                     | 416/328   | 5.80   |
| 22 | 4-84   | Virgil E. Cooper Jr. & Barbra J. Cooper | 264/182   | 19.98  |
| 23 | 4-85.2 | Samuel R. Gieseke & Erin N. Eakin       | 375/416   | 4.67   |
| 24 | 4-78.1 | Earl Snider                             | 220/11    | 6.63   |
| 25 | 4-78   | Lesley J. Snider                        | 220/13    | 6.83   |
| 26 | 4-76   | Scott & Jeffery Grim                    | 387/119   | 90.00  |
| 27 | 4-87   | Janice M. Eddy & Michael D. Eddy        | OR188/546 | 30.1   |
| 28 | 4-88   | Janice M. Eddy & Michael D. Eddy        | OR188/546 | 30.1   |
| 29 | 4-90.1 | Gary B. & Melinda J. Lewis              | 473/1     | 47.33  |
| 30 | 4-91   | Donna K. Johnston                       | 184/133   | 54.06  |
| 31 | 8-12   | Donna Kathy Johnston                    | 184/133   | 86.89  |
| 32 | 8-14   | Robert F. Scardina, et ux               | 320/646   | 72.79  |
| 33 | 5-9.4  | Neil R. Stebbins                        | 366/436   | 51.48  |
| 34 | 5-11   | Robert F. Scardina, et ux               | 320/646   | 25.00  |
| 35 | 5-10   | Robert F. Scardina, et ux               | 320/646   | 25.00  |
| 36 | 5-12   | Robert F. Scardina, et ux               | 320/646   | 25.00  |

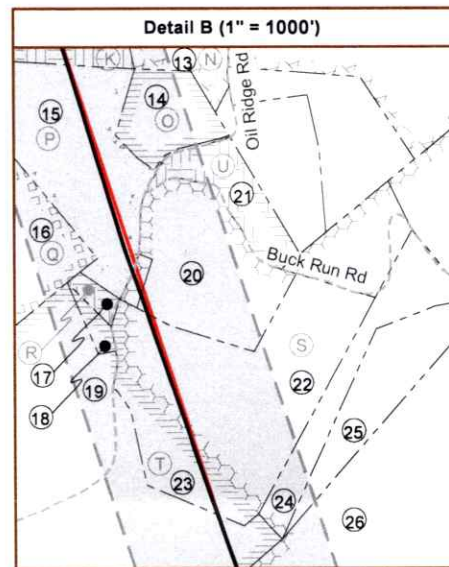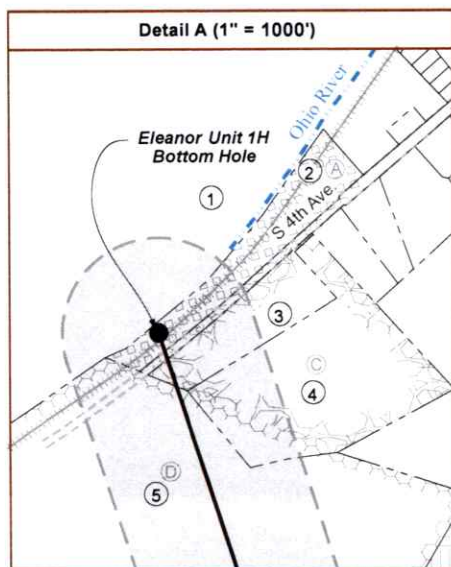

FILE NO: 157-54-L-23

DRAWING NO: Eleanor Unit 1H As Drilled

SCALE: 1" = 2000'

MINIMUM DEGREE OF ACCURACY:  
Submeter

PROVEN SOURCE OF ELEVATION:  
WVDOT, Harrisville, WV

STATE OF WEST VIRGINIA  
DEPARTMENT OF ENVIRONMENTAL PROTECTION  
OIL AND GAS DIVISION

DATE: March 9 2026

OPERATOR'S WELL NO. Eleanor Unit 1H

API WELL NO

47 - 095 - 02932  
STATE COUNTY PERMIT

WELL TYPE: ☐ OIL ☒ GAS ☐ LIQUID INJECTION ☐ WASTE DISPOSAL  
(IF GAS) PRODUCTION: ☐ STORAGE ☐ DEEP ☒ SHALLOW

LOCATION: ELEVATION: As-Built 1,092' WATERSHED: Outlet Middle Island Creek QUADRANGLE: Paden City

DISTRICT: Lincon

COUNTY: Tyler 05/01/2026

SURFACE OWNER: Robert F. Scardina & Rita K. Scardina

ACREAGE: 25.00

ROYALTY OWNER: Robert F. Scardina & Rita K. Scardina

LEASE NO: ACREAGE: 25

PROPOSED WORK: ☐ DRILL ☐ CONVERT ☐ DRILL DEEPER ☐ FRACTURE OR STIMULATE ☐ PLUG OFF OLD FORMATION  
☐ PERFORATE NEW FORMATION ☒ OTHER PHYSICAL CHANGE IN WELL (SPECIFY) As Drilled

☐ PLUG AND ABANDON ☐ CLEAN OUT AND REPLUG TARGET FORMATION: Marcellus Shale ESTIMATED DEPTH: 6,204' TVD 17,684' MD

WELL OPERATOR: Antero Resources Corporation

DESIGNATED AGENT: Conrad Baston

ADDRESS: 1615 Wynkoop Street  
Denver, CO 80202

ADDRESS: 535 White Oaks Blvd.  
Bridgeport, WV 26330