



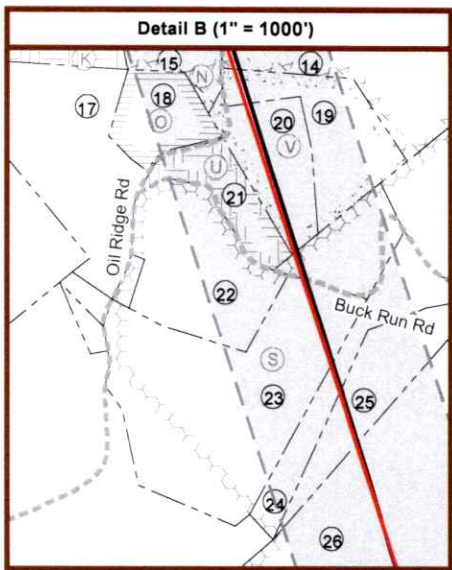

Leases	
A	Paul Wissmach Glass Company
B	T&D Corporation, et al
C	Albert Merton & Barbara Jo Mohrman
D	Golden Eagle Resources II, LLC
E	Stanley E. Dennis & Edith L. Dennis, JTWROS
F	Henry P. Snyder, et al
G	Stanley E. Dennis & Edith L. Dennis, h/w
K	OCTO Energy
L	Eagle Investments, LLC
N	Ralph Mikes or Dora Mikes, h/w
O	Virgil L. Cooper & Tracie J. Cooper
S	John L. Renner, II
U	Maxine Ankrom
V	Alice M. Bungard
X	Shirley Myers
Y	Moore Self Storage, North Carolina, LLC
AA	Robert F. & Rita K. Scardina
AB	Robert F. Scardina, et ux
AC	Robert F. Scardina, et ux
AD	Robert F. Scardina, et ux
AE	Robert F. Scardina, et ux
AF	AMP IV, LP
AG	Ralph David & Sophia Judge
AH	Robert W. Cross & Jean A. Cross, JTWROS
AI	Joseph D. Giovinazzo

ID	TM-Par	Owner	Bk/Pg	Acres
1	xx-xx	Owner	xx/xx	x.xx
2	3-157	Paul Wissmach Glass Co.	224/252	7.00
3	3-155	Joseph Glovinazzo, et al	WB87/748	6.07
4	1-20.4	Timothy B. & Carolyn R. Hizer	311/682	2.03
5	1-20.5	John T. Daugherty	330/854	1.91
6	1-2	Albert Merton & Barbara Jo Mohrman	399/329	5.18
7	1-3	Albert Merton & Barbara Jo Mohrman	399/329	17.50
8	1-20.1	Stanley E. & Edith L. Dennis	350/414	49.97
9	1-4	Haessly Hardwood Lumber Co.	290/457	166.20
10	1-21	Stanley E. & Edith L. Dennis	350/414	77.71
11	4-56	Stanley E. & Edith L. Dennis	394/61	11.75
12	4-63	Eagle Hardwood Inc.	345/195	16.79
13	4-62	Stephanie D. & Terrance D. Francis	537/521	3.75
14	4-65	Carl D. O'Neil	248/117	45.90
15	4-65.1	Carl D. O'Neil	WB36/381	13.26
16	4-61	Carl D. O'Neil	133/175	18.81
17	4-82.4	Virgil L. & Tracie J. Cooper	444/521	13.00
18	4-82.2	Virgil L. & Tracie J. Cooper	333/220	4.46
19	4-80	Alice M., Harley R. & Judy Bungard	352/104	8.34
20	4-81	Alice M., Harley R. & Judy Bungard	352/104	7.00
21	4-82.1	Ricky & Barbra Keys	416/328	5.80
22	4-82	Virgil E. Cooper	199/41	10.90
23	4-84	Virgil E. Cooper Jr. & Barbra J. Cooper	264/182	19.98
24	4-78.1	Earl Snider	220/11	6.63
25	4-78	Lesley J. Snider	220/13	6.83
26	4-76	Scott & Jeffery Grim	387/119	90.00
27	4-92	Robert W. & Jean A. Cross	342/751	53.00
28	4-90.1	Gary B. & Melinda J. Lewis	473/1	47.33
29	4-91	Donna K. Johnston	184/133	54.06
30	5-4	Ralph D. & Sophia Judge	306/681	60.77
31	8-12	Donna Kathy Johnston	184/133	86.89
32	8-14	Robert F. Scardina, et ux	320/646	72.79
33	5-11	Robert F. Scardina, et ux	320/646	25.00
34	5-10	Robert F. Scardina, et ux	320/646	25.00
35	5-12	Robert F. Scardina, et ux	320/646	25.00
36	5-9.4	Neil R. Stebbins	366/436	51.48

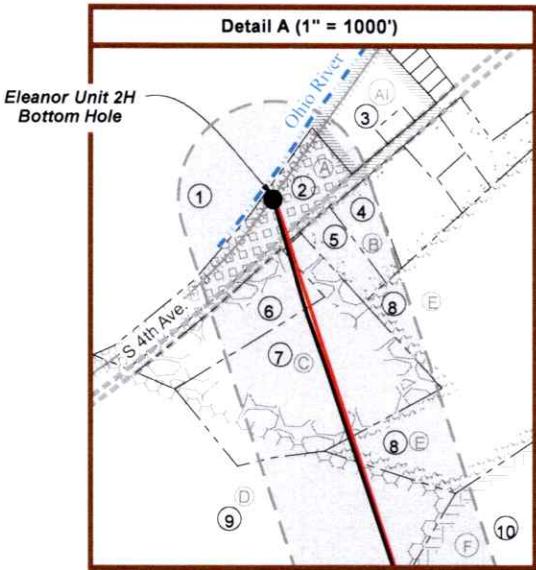

FILE NO: 157-54-L-23
DRAWING NO: Eleanor Unit 2H As Drilled
SCALE: 1" = 2000'
MINIMUM DEGREE OF ACCURACY:
Submeter
PROVEN SOURCE OF ELEVATION:
WVDOT, Harrisville, WV

STATE OF WEST VIRGINIA
DEPARTMENT OF ENVIRONMENTAL PROTECTION
OIL AND GAS DIVISION

DATE: March 9 2026
OPERATOR'S WELL NO. Eleanor Unit 2H
API WELL NO
47 - 095 - 02933
STATE COUNTY PERMIT

WELL TYPE: ☐ OIL ☒ GAS ☐ LIQUID INJECTION ☐ WASTE DISPOSAL
(IF GAS) PRODUCTION: ☐ STORAGE ☐ DEEP ☒ SHALLOW
LOCATION: ELEVATION: As-Built 1,092' WATERSHED: Outlet Middle Island Creek QUADRANGLE: Paden City
DISTRICT: Lincon COUNTY: Tyler 05/01/2026
SURFACE OWNER: Robert F. Scardina & Rita K. Scardina ACREAGE: 25.00
ROYALTY OWNER: Robert F. Scardina & Rita K. Scardina LEASE NO: ACREAGE: 25
PROPOSED WORK: ☐ DRILL ☐ CONVERT ☐ DRILL DEEPER ☐ FRACTURE OR STIMULATE ☐ PLUG OFF OLD FORMATION
☐ PERFORATE NEW FORMATION ☒ OTHER PHYSICAL CHANGE IN WELL (SPECIFY) As Drilled
☐ PLUG AND ABANDON ☐ CLEAN OUT AND REPLUG TARGET FORMATION: Marcellus Shale ESTIMATED DEPTH: 6,235' TVD 17,785' MD

WELL OPERATOR: Antero Resources Corporation DESIGNATED AGENT: Conrad Baston
ADDRESS: 1615 Wynkoop Street ADDRESS: 535 White Oaks Blvd.
Denver, CO 80202 Bridgeport, WV 26330