

	Bearing	Dist.
L1	S 34°03' W	1,089.9'
L2	S 06°43' E	1,259.1'
L3	S 89°17' E	1,601.7'
L4	N 63°06' E	1,251.5'

Top Hole Coordinates, As-drilled data, and information was provided by Antero Resources Corporation. Allegheny Surveys Inc. (ASI) is not certifying the data and information provided. ASI is not responsible for any errors or inaccuracies with the data and information that has been provided.

I, the undersigned, hereby certify that this plat is correct to the best of my knowledge and belief and shows all the information required by law and the rules issued and prescribed by the Department of Environmental Protection.

Bradley D. Miller, P.S. 2167


A circular professional seal for a surveyor. The outer ring contains the text "BRADLEY D. MILLER" at the top and "PROFESSIONAL SURVEYOR" at the bottom, separated by two stars. Inside this ring is a smaller circle with the word "LICENSED" at the top and "STATE OF WEST VIRGINIA" at the bottom, also separated by two stars. In the center of the seal, the text "No. 2167" is written above "STATE OF". The seal is blue and white.

SEA

ADDRESS: 535 White Oaks Blvd.
Bridgeport, WV 26330



Detail 1 (1"=500')

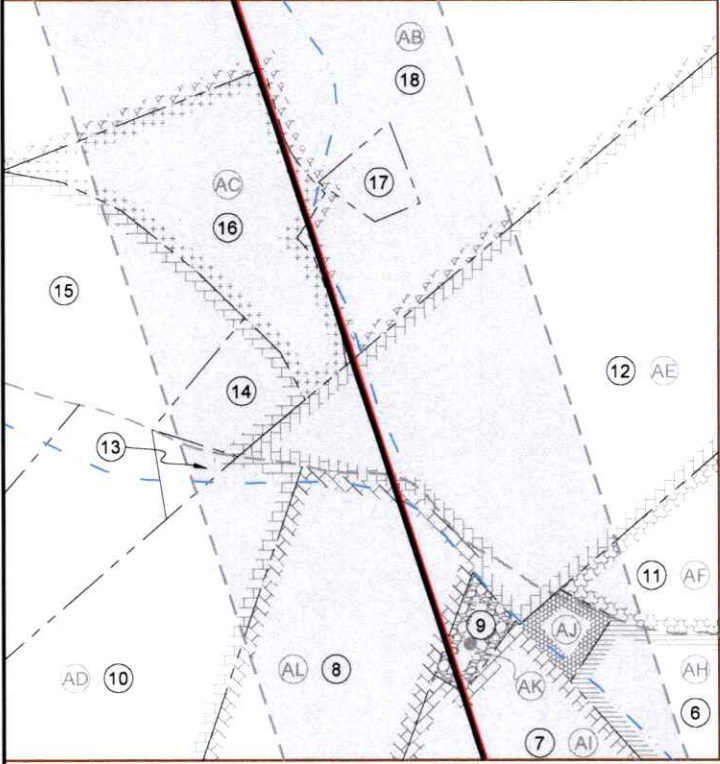

Detail 2 (1"=500')



FILE NO: 156-54-L-23

DRAWING NO: Grey Unit 1H As Drilled

SCALE: 1" = 2000'

MINIMUM DEGREE OF ACCURACY:
Submeter

PROVEN SOURCE OF ELEVATION:
WVDOT, Harrisville, WV

STATE OF WEST VIRGINIA
DEPARTMENT OF ENVIRONMENTAL PROTECTION
OIL AND GAS DIVISION

DATE: March 9 2026

OPERATOR'S WELL NO. Grey Unit 1H

API WELL NO

47 - 095 - 02934

STATE COUNTY PERMIT

WELL TYPE: ☐ OIL ☒ GAS ☐ LIQUID INJECTION ☐ WASTE DISPOSAL
(IF GAS) PRODUCTION: ☐ STORAGE ☐ DEEP ☒ SHALLOW

LOCATION: ELEVATION: As-Built: 1,092' WATERSHED: Outlet Middle Island Creek QUADRANGLE: Paden City

DISTRICT: Lincoln

COUNTY: Tyler

ACREAGE: 25.00

SURFACE OWNER: Robert F. Scardina & Rita K. Scardina

ROYALTY OWNER: Robert F. Scardina & Rita K. Scardina

LEASE NO: ACREAGE: 25.00

PROPOSED WORK: ☐ DRILL ☐ CONVERT ☐ DRILL DEEPER ☐ FRACTURE OR STIMULATE ☐ PLUG OFF OLD FORMATION
☐ PERFORATE NEW FORMATION ☒ OTHER PHYSICAL CHANGE IN WELL (SPECIFY) As Drilled 6,288' TVD

☐ PLUG AND ABANDON ☐ CLEAN OUT AND REPLUG TARGET FORMATION: Marcellus Shale ESTIMATED DEPTH: 17,308' MD

WELL OPERATOR: Antero Resources Corporation

DESIGNATED AGENT: Conrad Baston

ADDRESS: 1615 Wynkoop Street

ADDRESS: 535 White Oaks Blvd.

Denver, CO 80202

Bridgeport, WV 26330

Antero Resources
Well No. Grey 1H
As Drilled
Antero Resources Corporation

Page 3 of 3



Lease	
Tract F	Timothy O. Brown
Tract G	Sandra Casteel
Tract I	Dyeann Lemley, Life Estate & Dail Monica Sorsby, as Remainderman
Tract J	Richard L. Armstrong
Tract K	Eric Scott Hayes & Tiffany Hayes, hw
Tract L	Harold M. Harter & Donna J. Harter, JTWROS
Tract M	Travis D. Blake & Amy A. Geho-Blake, h/w, JTWROS
Tract N	Stanley E. & Edith L. Dennis, JTWROS
Tract O	Charles M. Hayes & Rebecca S. Hayes, JTWROS
Tract P	Charles M. Hayes & Rebecca S. Hayes, JTWROS
Tract Q	Charles M. Hayes & Rebecca S. Hayes, JTWROS
Tract R	Jason Welby Snider & Lindsay Shay Snider, hw
Tract V	Henry P. Snyder, et al
Tract Z	Aunix Energy, LLC
Tract AB	Richard & Linda Tuttle, h/w JTWROS
Tract AC	Martha Jean Suter & Bryan, JTWROS
Tract AD	John L. Renner, II
Tract AE	Richard & Linda Tuttle, h/w JTWROS
Tract AF	Edward L. Midcap
Tract AH	Ralph & Sophia Judge
Tract AI	Bounty Minerals, LLC.
Tract AJ	Bounty Minerals, LLC.
Tract AK	Cheryl L. Hill
Tract AL	Roger D. Jones
Tract AN	AMP IV, LP
Tract AP	Robert F. Scardina & Rita K. Scardina, h/w
Tract AQ	Robert F. Scardina & Rita K. Scardina, h/w
Tract AX	Robert F. & Rita K. Scardina

Tyler County				
No.	TM / Par	Owner	Bk / Pg	Ac.
1	5 / 11	Robert F. & Rita K. Scardina	320 / 646	25.00
2	5 / 10	Robert F. & Rita K. Scardina	320 / 646	25.00
3	5 / 12	Robert F. & Rita K. Scardina	320 / 646	25.00
4	5 / 9.4	Neil R. Stebbins	366 / 436	51.48
5	5 / 9	Sally Anderson (L/E)	368 / 92	25.89
6	5 / 4	Ralph D. & Sophia Judge	306 / 681	60.77
7	5 / 2	Brian Clegg	OR2 / 648	19.44
8	4 / 70	Michael J. Eddy	352 / 129	19.00
9	5 / 2.2	Cheryl L. Hill	343 / 572	0.71
10	4 / 71	Darnell & Cindy Fulks	484 / 575	20.00
11	5 / 2.1	John Goode	OR28 / 720	27.52
12	5 / 1	Richard L. & Linda Tuttle	362 / 43	88.00
13	4 / 74.1	Darnell Fulks	273 / 615	1.00
14	4 / 74.2	Darnell & Cindy Fulks	484 / 575	1.66
15	4 / 74	Kevin W. Barnhart	OR11 / 18	12.64
16	4 / 69.2	Bryan J. & Martha J. Suter	282 / 50	5.88
17	4 / 69.1	Richard Tuttle	268 / 440	0.81
18	4 / 69	Richard L. & Linda Tuttle	362 / 43	87.48
19	4 / 67	Richard L. Wright, Jr., et al	408 / 24	71.41
20	1 / 7	Alice M. Bungard	270 / 220	86.83
21	1 / 7.1	Alice M. Bungard	320 / 603	3.25
22	1 / 21	Stanley E. & Edith L. Dennis	350 / 414	77.71
23	1 / 6.1	Charles M. & Rebecca Hayes	272 / 447	3.80
24	1 / 10	Jason W. & Lindsay S. Snider	381 / 517	3.00
25	1 / 6	Charles M. & Rebecca Hayes	272 / 262	3.62
26	1 / 15	G.R. & Patti R. Casteel	412 / 395	11.44
27	1 / 18	Eric S. & Tiffany Hayes	404 / 302	8.63
28	1 / 20.1	Stanley E. & Edith L. Dennis	350 / 414	49.97
29	1 / 19	Steven S. McFadden	350 / 700	1.25
30	1 / 25	Harold M. & Donna J. Harter	327 / 536	1.00
31	1 / 24	Richard L. Armstrong	373 / 204	0.50
32	1 / 17	Richard L. Wright, et al	FR7 / 115	0.50
33	1 / 16	Robert D. Wetzel	OR59 / 298	8.69
34	4 / 111	Joshua S. Amos	337 / 955	0.74
35	3 / 153	Robert D. Wetzel	OR59 / 298	0.86
36	3 / 152	Robert D. Wetzel	OR59 / 298	0.49
37	3 / 151	Harold M. & Donna J. Harter	605 / 819	0.19
38	3 / 150	Harold M. & Donna J. Harter	312 / 143	0.56
39	3 / 148	Harold M. & Donna J. Harter	327 / 536	0.42
40	3 / 146.3	Harold M. Harter	OR8 / 41	0.14
41	3 / 146.4	Steven S. McFadden	OR20 / 8	0.12
42	3 / 146	Steven S. McFadden	OR20 / 8	1.88
43	3 / 145	Dennis & Myra Meko	OR14 / 292	0.19
44	3 / 144	Julie A. Taylor	OR59 / 479	0.19
45	3 / 158	Julie A. Taylor	OR59 / 479	0.08
46	3 / 95	David F. & Carla F. Knoop	331 / 471	0.13
47	3 / 94	William B. & Josephine B. Shepherd (LE)	664 / 643	0.08
48	3 / 94.1	William B. & Josephine B. Shepherd (LE)	664 / 643	0.25
49	3 / 93	Jowill S. Shepherd & Michelle L. Gimm	355 / 56	0.17
50	3 / 97	Daniel H. & Karen A. Welch	324 / 138	0.22
51	3 / 99	Sanford Clegg, Jr.	176 / 31	0.28
52	3 / 101	Richard E. & Flora E. Gallagher	215 / 701	0.19
53	3 / 110	John M. Long	351 / 381	0.10
54	3 / 109	John M. Long	351 / 381	0.08
55	3 / 108	James B. & Patricia J. Means	306 / 189	0.08
56	3 / 106	James B. & Patricia J. Means	267 / 597	0.17
57	3 / 105	Michael J. & Amy S. Palmer	303 / 94	0.08
58	3 / 105.1	Franna M. Rose	358 / 810	0.21
59	3 / 113.2	Clay G. Morris & Mollie M. Baker	OR66 / 252	0.25
60	3 / 113.1	Jeremy P. Byers	OR134 / 558	0.25
61	3 / 114	Jeremy P. Byers	OR134 / 558	0.11
62	3 / 115	Tamela B. Dulaney	575 / 503	0.11
63	3 / 118	Stephen A. & Deborah L. Space	250 / 489	0.23
64	3 / 117.4	Keyonna R. Thompson & Lucus R. Houle	OR97 / 411	0.19
65	3 / 120.5	Dennis K. Grimes, et ux	262 / 194	0.22

FILE NO: 156-54-L-23
DRAWING NO: Grey Unit 1H As Drilled
SCALE: 1" = 2000'
MINIMUM DEGREE OF ACCURACY:
Submeter
PROVEN SOURCE OF ELEVATION:
WVDOT, Harrisville, WV

STATE OF WEST VIRGINIA
DEPARTMENT OF ENVIRONMENTAL PROTECTION
OIL AND GAS DIVISION

DATE: March 9 2026
OPERATOR'S WELL NO. Grey Unit 1H
API WELL NO
47 - 095 - 02934
STATE COUNTY PERMIT

WELL TYPE: ☐ OIL ☒ GAS ☐ LIQUID INJECTION ☐ WASTE DISPOSAL
(IF GAS) PRODUCTION: ☐ STORAGE ☐ DEEP ☒ SHALLOW

LOCATION: ELEVATION: As-Built: 1,092' WATERSHED: Outlet Middle Island Creek QUADRANGLE: Paden City
DISTRICT: Lincoln COUNTY: Tyler 05/01/2026
SURFACE OWNER: Robert F. Scardina & Rita K. Scardina ACREAGE: 25.00
ROYALTY OWNER: Robert F. Scardina & Rita K. Scardina LEASE NO: ACREAGE: 25.00
PROPOSED WORK: ☐ DRILL ☐ CONVERT ☐ DRILL DEEPER ☐ FRACTURE OR STIMULATE ☐ PLUG OFF OLD FORMATION
☐ PERFORATE NEW FORMATION ☒ OTHER PHYSICAL CHANGE IN WELL (SPECIFY) As Drilled 6,288' TVD
☐ PLUG AND ABANDON ☐ CLEAN OUT AND REPLUG TARGET FORMATION: Marcellus Shale ESTIMATED DEPTH: 17,308' MD

WELL OPERATOR: Antero Resources Corporation
ADDRESS: 1615 Wynkoop Street
Denver, CO 80202

DESIGNATED AGENT: Conrad Baston
ADDRESS: 535 White Oaks Blvd.
Bridgeport, WV 26330