

Antero Resources

Well No. Grey 2H

As Drilled

Antero Resources Corporation

Page 1 of 3

Notes:

Well No. Grey Unit 2H

As-Drilled POE Coordinates

WV Coordinate System

of 1927, North Zone

N: 392,685.84'

E: 1,597,820.00'

Latitude: 39°34'09.78"

Longitude: 80°55'36.15"

UTM Zone 17, NAD 1983

N: 4,379,975.867m

E: 506,310.204m

Notes

West Virginia Coordinate System

of 1927, North Zone

based upon Differential GPS Measurements.

Well No. Grey Unit 2H Top Hole coordinates are

N: 392,111.72' Latitude: 39°34'03.98"

E: 1,596,977.65' Longitude: 80°55'46.79"

Bottom Hole coordinates are

N: 403,107.48' Latitude: 39°35'52.25"

E: 1,594,527.13' Longitude: 80°56'20.32"

UTM Zone 17, NAD 1983

Top Hole Coordinates Bottom Hole Coordinates

N: 4,379,796.666m N: 4,383,134.116m

E: 506,056.493m E: 505,254.086m

Plat orientation and corner and well references

are based upon the grid north meridian.

Well location references are based upon the

magnetic meridian.

Legend

Proposed gas well

Well Reference, as noted

Monument, as noted

Existing Well, as noted

Existing Plugged Well, as noted

Digitized Well, as noted

Creek or Drain

Existing Road

Surface boundary (approx.)

Railroad Tracks (approx.)

District line

As Drilled

Well No. Grey Unit 2H

2000'

Note: No water wells were found within 2000'

of proposed well. No occupied dwellings or

buildings 2,500 square feet or larger used to

house or shelter dairy cattle or poultry

husbandry are located within 625' of the

center of the well pad.

Wellhead Layout (NTS)

As Drilled Well

Grey Unit 2H

(API# 47-095-02935)

As Drilled Well

Grey Unit 1H

(API# 47-095-02934)

As Drilled Well

Isabella Unit 2H

(API# 47-095-02937)

As Drilled Well

Isabella Unit 1H

(API# 47-095-02936)

As Drilled Well

Eleanor Unit 2H

(API# 47-095-02933)

As Drilled Well

Eleanor Unit 1H

(API# 47-095-02932)

As Drilled Well No. Grey Unit 2H

6,287' to Bottom Hole

3,664' to Top Hole

BTM LATITUDE 39 - 37 - 30 - 00

TOP LATITUDE 39 - 35 - 00

TOP LONGITUDE 80 - 55 - 00

BTM LONGITUDE 80 - 55 - 00

5,669' to Top Hole

9,890' to Bottom Hole

ALLEGHENY

SURVEYS, INC.

TOP HOLE COORDINATES,

As-drilled data, and

information was provided by

Antero Resources

Corporation. Allegheny

Surveys Inc. (ASI) is not

certifying the data and

information provided. ASI is

not responsible for any

errors or inaccuracies with

the data and information

that has been provided.

I, the undersigned, hereby certify

that this plat is correct to the best

of my knowledge and belief and

shows all the information required

by law and the rules issued and

prescribed by the Department of

Environmental Protection.

Bradley D. Miller, P.S. 2167

BRADLEY D. MILLER

LICENSED

No. 2167

STATE OF

WEST VIRGINIA

PROFESSIONAL SURVEYOR

SEAL

FILE NO: 156-54-L-23

DRAWING NO: Grey Unit 2H As Drilled

SCALE: 1" = 2000'

MINIMUM DEGREE OF ACCURACY:

Submeter

PROVEN SOURCE OF ELEVATION:

WVDOT, Harrisville, WV

STATE OF WEST VIRGINIA

DEPARTMENT OF ENVIRONMENTAL PROTECTION

OIL AND GAS DIVISION

DATE: March 9 20 26

OPERATOR'S WELL NO. Grey Unit 2H

API WELL NO

47 - 095 - 02935

STATE COUNTY PERMIT

WELL TYPE: ☐ OIL ☒ GAS ☐ LIQUID INJECTION ☐ WASTE DISPOSAL

(IF GAS) PRODUCTION: ☐ STORAGE ☐ DEEP ☒ SHALLOW

LOCATION: ELEVATION: As-Built: 1,092' WATERSHED: QUADRANGLE: Paden City

DISTRICT: Lincoln COUNTY: Tyler 05/01/2026

SURFACE OWNER: Robert F. Scardina & Rita K. Scardina ACREAGE: 25.00

ROYALTY OWNER: Robert F. Scardina & Rita K. Scardina LEASE NO: ACREAGE: 25.00

PROPOSED WORK: ☐ DRILL ☐ CONVERT ☐ DRILL DEEPER ☐ FRACTURE OR STIMULATE ☐ PLUG OFF OLD FORMATION

☐ PERFORATE NEW FORMATION ☒ OTHER PHYSICAL CHANGE IN WELL (SPECIFY) As Drilled 6,301' TVD

☐ PLUG AND ABANDON ☐ CLEAN OUT AND REPLUG TARGET FORMATION: Marcellus Shale ESTIMATED DEPTH: 17,451' MD

WELL OPERATOR: Antero Resources Corporation

DESIGNATED AGENT: Conrad Baston

ADDRESS: 1615 Wynkoop Street


ADDRESS: 535 White Oaks Blvd.

Denver, CO 80202


Bridgeport, WV 26330



Detail 1 (1"=500')

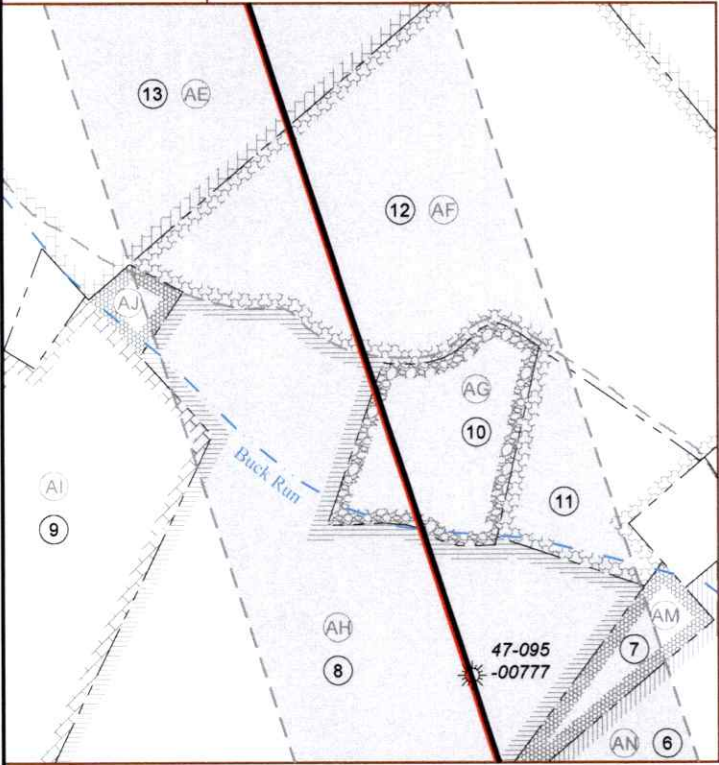

Detail 2 (1"=500')

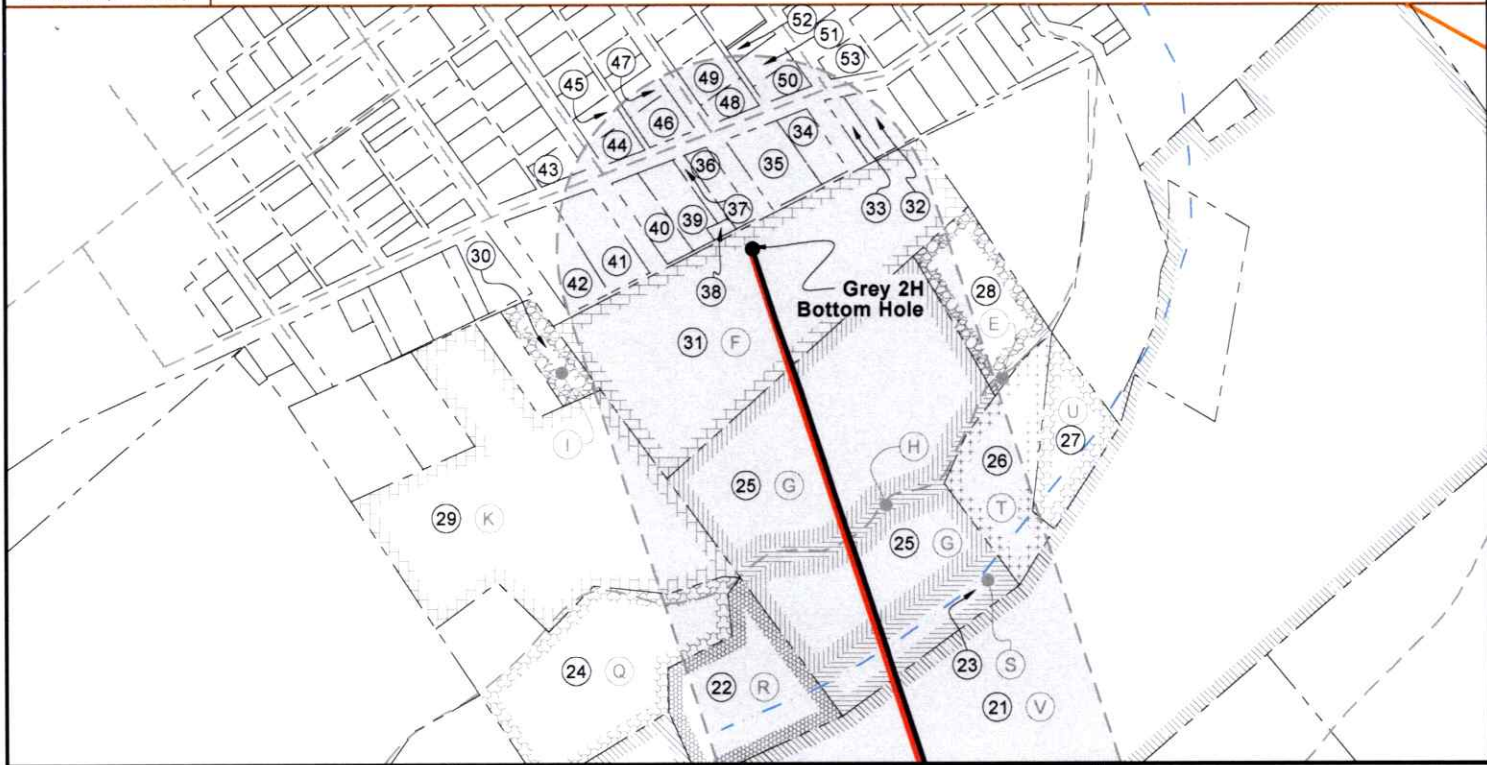

FILE NO: 156-54-L-23
DRAWING NO: Grey Unit 2H As Drilled
SCALE: 1" = 2000'
MINIMUM DEGREE OF ACCURACY:
Submeter
PROVEN SOURCE OF ELEVATION:
WVDOT, Harrisville, WV

STATE OF WEST VIRGINIA
DEPARTMENT OF ENVIRONMENTAL PROTECTION
OIL AND GAS DIVISION

DATE: March 9 2026
OPERATOR'S WELL NO. Grey Unit 2H
API WELL NO
47 - 095 - 02935
STATE COUNTY PERMIT

WELL TYPE: ☐ OIL ☒ GAS ☐ LIQUID INJECTION ☐ WASTE DISPOSAL
(IF GAS) PRODUCTION: ☐ STORAGE ☐ DEEP ☒ SHALLOW
LOCATION: ELEVATION: As-Built: 1,092' WATERSHED: Outlet Middle Island Creek QUADRANGLE: Paden City
DISTRICT: Lincoln COUNTY: Tyler 05/01/2026
SURFACE OWNER: Robert F. Scardina & Rita K. Scardina ACREAGE: 25.00
ROYALTY OWNER: Robert F. Scardina & Rita K. Scardina LEASE NO: ACREAGE: 25.00
PROPOSED WORK: ☐ DRILL ☐ CONVERT ☐ DRILL DEEPER ☐ FRACTURE OR STIMULATE ☐ PLUG OFF OLD FORMATION
☐ PERFORATE NEW FORMATION ☒ OTHER PHYSICAL CHANGE IN WELL (SPECIFY) As Drilled 6,301' TVD
☐ PLUG AND ABANDON ☐ CLEAN OUT AND REPLUG TARGET FORMATION: Marcellus Shale ESTIMATED DEPTH: 17,451' MD

WELL OPERATOR: Antero Resources Corporation DESIGNATED AGENT: Conrad Baston
ADDRESS: 1615 Wynkoop Street ADDRESS: 535 White Oaks Blvd.
Denver, CO 80202 Bridgeport, WV 26330



	Lease
Tract E	The West Virginia Department of Transportation, Division of Highways
Tract F	Timothy O. Brown
Tract G	Sandra Casteel
Tract H	The West Virginia Department of Transportation, Division of Highways
Tract I	Dyeann Lemley, Life Estate & Dail Monica Sorsby, as Remainderman
Tract K	Eric Scott Hayes & Tiffany Hayes, hw
Tract Q	Charles M. Hayes & Rebecca S. Hayes , JTWROS
Tract R	Jason Welby Snider & Lindsay Shay Snider, hw
Tract S	Ashley D. Efaw
Tract T	Robert Edward Lewis
Tract U	Lee & Hall Royalties a West Virginia Foreign General Partnership
Tract V	Henry P. Snyder, et al
Tract W	Gary Holmes & Marsha L. Holmes
Tract X	BRC Appalachian Minerals I LLC
Tract Y	Clifton C. Lough & Allyson B Lough
Tract AA	Brandon P. Mason & Katie E. Mason, JTROS
Tract AB	Richard Tuttle, et ux
Tract AE	Richard & Linda Tuttle, h/w JTWROS
Tract AF	Edward L. Midcap
Tract AG	Warren P. Judge
Tract AH	Ralph & Sophia Judge
Tract AI	Bounty Minerals, LLC.
Tract AJ	Bounty Minerals, LLC.
Tract AM	Cindy J. Cusmano
Tract AN	AMP IV, LP
Tract AO	Robert F. Scardina & Rita K. Scardina, h/w
Tract AP	Robert F. Scardina & Rita K. Scardina, h/w
Tract AQ	Robert F. Scardina & Rita K. Scardina, h/w
Tract AX	Robert F. & Rita K. Scardina
Tract AY	Jane Ann Miller

Tyler County				
No.	TM / Par	Owner	Bk / Pg	Ac.
1	5 / 11	Robert F. & Rita K. Scardina	320 / 646	25.00
2	5 / 10	Robert F. & Rita K. Scardina	320 / 646	25.00
3	5 / 12	Robert F. & Rita K. Scardina	320 / 646	25.00
4	5 / 13	Robert F. & Rita K. Scardina	320 / 646	46.00
5	5 / 9.4	Neil R. Stebbins	366 / 436	51.48
6	5 / 9	Sally Anderson (L/E)	368 / 92	25.89
7	5 / 6	Stephen D. & Pamela L. Hayes	368 / 92	2.11
8	5 / 4	Ralph D. & Sophia Judge	306 / 681	60.77
9	5 / 2	Brian Clegg	OR2 / 648	19.44
10	5 / 3	Warren P. Judge	345 / 89	4.10
11	5 / 5	Ralph D. & Sophia V. Judge	212 / 572	3.58
12	5 / 2.1	John Goode	OR28 / 720	27.52
13	5 / 1	Richard L. & Linda Tuttle	362 / 43	88.00
14	4 / 69	Richard L. & Linda Tuttle	362 / 43	87.48
15	5 / 36	Brandon P. & Katie E. Mason	396 / 464	56.87
16	4 / 68	Clifton C. & Allyson B. Lough	354 / 569	9.00
17	5 / 37	Clegg Family Irrevocable Trust	369 / 576	19.80
18	1 / 7	Alice M. Bungard	270 / 220	86.83
19	1 / 8	Gary & Marsha L. Holmes	372 / 325	95.40
20	1 / 7.1	Alice M. Bungard	320 / 603	3.25
21	1 / 21	Stanley E. & Edith L. Dennis	350 / 414	77.71
22	1 / 10	Jason W. & Lindsay S. Snider	381 / 517	3.00
23	1 / 9	Anna & Ashley Efaw	OR80 / 548	2.27
24	1 / 6	Charles M. & Rebecca Hayes	272 / 262	3.62
25	1 / 15	G.R. & Patti R. Casteel	412 / 395	11.44
26	1 / 11.1	Lloyd Lewis & Edward Robert	256 / 596	2.00
27	1 / 11	Mary M. & Lloyd Lewis, Sr.	285 / 447	1.35
28	1 / 14	Glen R. & Patti R. Casteel (L/E)	412 / 398	2.16
29	1 / 18	Eric S. & Tiffany Hayes	404 / 302	8.63
30	1 / 17	Richard L. Wright, et al	FR7 / 115	0.50
31	1 / 16	Robert D. Wetzel	OR59 / 298	8.69
32	4 / 116	Volusia Ventures, LLC	OR10 / 409	0.46
33	4 / 115.1	Zachary A. Casto	180 / 238	0.22
34	4 / 115	Zachary A. Casto	180 / 238	0.34
35	4 / 114	Alenander T. Booher	OR22 / 102	0.67
36	4 / 113	Donald R. Chambers	335 / 469	0.32
37	4 / 113.3	Donald R. Chambers	335 / 469	0.14
38	4 / 113.1	James Vancamp, et al	W33 / 377	0.05
39	4 / 113.2	Donald R. Chambers	W26 / 625	0.65
40	4 / 112	Joshua S. Amos	337 / 955	0.27
41	4 / 111	Joshua S. Amos	337 / 955	0.74
42	3 / 153	Robert D. Wetzel	OR59 / 298	0.86
43	3 / 120.5	Dennis K. Grimes, et ux	262 / 194	0.22
44	4 / 9	Eric J. Richmond, et ux	OR124 / 159	0.21
45	4 / 8.3	Kathy Loub	447 / 202	0.22
46	4 / 18	Billy R. Katherine Anderegg	164 / 147	0.31
47	4 / 17	Matthew D. Trader & Amanda N. Adams	530 / 386	0.22
48	4 / 23.1	Bonnie S. Collins, et al	563 / 316	0.20
49	4 / 23	Edsel V. Hoover, Jr.	336 / 918	0.32
50	4 / 32	Gwendolyn M. Fiber	209 / 460	0.18
51	4 / 31	Saturnina Morrison	OR81 / 499	0.22
52	4 / 30	Curtis W. Anderson & Stephanie J. Rogers	358 / 10	0.11
53	4 / 41	Kathy Wayman	OR13 / 113	0.22

FILE NO: 156-54-L-23	STATE OF WEST VIRGINIA DEPARTMENT OF ENVIRONMENTAL PROTECTION OIL AND GAS DIVISION	DATE: March 9 2026
DRAWING NO: Grey Unit 2H As Drilled		OPERATOR'S WELL NO. Grey Unit 2H
SCALE: 1" = 2000'		API WELL NO
MINIMUM DEGREE OF ACCURACY: Submeter		47 - 095 - 02935
PROVEN SOURCE OF ELEVATION: WVDOT, Harrisville, WV		STATE COUNTY PERMIT

WELL TYPE: ☐ OIL ☒ GAS ☐ LIQUID INJECTION ☐ WASTE DISPOSAL (IF GAS) PRODUCTION: ☐ STORAGE ☐ DEEP ☒ SHALLOW	
LOCATION: ELEVATION: As-Built: 1,092'	WATERSHED: Outlet Middle Island Creek
DISTRICT: Lincoln	QUADRANGLE: Paden City
SURFACE OWNER: Robert F. Scardina & Rita K. Scardina	COUNTY: Tyler 05/01/2026
ROYALTY OWNER: Robert F. Scardina & Rita K. Scardina	ACREAGE: 25.00
PROPOSED WORK: ☐ DRILL ☐ CONVERT ☐ DRILL DEEPER ☐ FRACTURE OR STIMULATE ☐ PLUG OFF OLD FORMATION	LEASE NO: ACREAGE: 25.00
☐ PERFORATE NEW FORMATION ☒ OTHER PHYSICAL CHANGE IN WELL (SPECIFY) As Drilled 6,301' TVD	
☐ PLUG AND ABANDON ☐ CLEAN OUT AND REPLUG	TARGET FORMATION: Marcellus Shale ESTIMATED DEPTH: 17,451' MD
WELL OPERATOR: Antero Resources Corporation	DESIGNATED AGENT: Conrad Baston
ADDRESS: 1615 Wynkoop Street	ADDRESS: 535 White Oaks Blvd.
Denver, CO 80202	Bridgeport, WV 26330