

ADDRESS: 535 White Oaks Blvd.
Bridgeport, WV 26330

Grey Unit 2H
(API# 47-095-02935)

Grey Unit 1H
(API# 47-095-02934)

Izabela Unit 2H
(API# 47-095-02937)

As Drilled Well

Izabela Unit 1H
(API# 47-095-02936)

Eleanor Unit 2H
(API# 47-095-02933)



Eleanor Unit 1H
(API# 47-095-02932)

N 52° 29' E 150''



Leases	
A	Joseph D. Giovino
B	Ronald L. Cain & Karen K. Cain, h/w
C	Frankie Lee Giovino
D	JACC Acquisitions, LLC
E	T&D Corporation, et al
F	Stanley E. Dennis & Edith L. Dennis, JTWROS
G	Albert Merton & Barbara Jo Mohrman
I	Henry P. Snyder, et al
J	Aunix Energy, LLC
K	Antero Minerals, LLC
L	Eagle Investments, LLC
M	Randolph W. Brown
N	Ralph Mikes or Dora Mikes, h/w
O	Alice M. Bungard
P	John L. Renner, II
Q	Richard & Linda Tuttle, JTWROS
U	Robert W. Cross & Jean A. Cross, JTWROS
V	Moore Self Storage, North Carolina, LLC
W	Ralph David & Sophia Judge
X	AMP IV, LP
Y	Robert F. Scardina & Rita K. Scardina, h/w
Z	Robert F. Scardina & Rita K. Scardina, h/w
AA	Robert F. Scardina & Rita K. Scardina
AB	Robert F. Scardina & Rita K. Scardina
AC	Robert F. Scardina & Rita K. Scardina
AD	Golden Eagle Resources II, LLC

ID	TM-Par	Owner	Bk/Pg	Acres
1	xx-xx	Owner	xx/xx	x.xx
2	3-155	Joseph Giovino, et al	WB87/748	6.07
3	3-155.1	JACC Acquisitions LLC	OR10/127	0.46
4	3-134.1	Ronald L. & Karen K. Cain	OR17/47	0.22
5	3-134.2	Ronald L. & Karen K. Cain	OR17/47	0.62
6	3-134.4	Ronald L. Cain	504/624	0.41
7	3-134.3	Frankie L. Giovino	OR147/160	0.19
8	1-20.2	Trustees of Congregation of Jehovah's Witnesses	292/173	3.59
9	1-20.6	Timothy Bryan & Carolyn Hizer	409/549	1.39
10	1-20.3	Triad Hunter LLC	385/566	0.89
11	1-20	Timothy Bryan & Carolyn Hizer	xx/xx	x.xx
12	1-20.4	Timothy B. & Carolyn R. Hizer	311/682	2.03
13	1-20.5	John T. Daugherty	330/854	1.91
14	1-3	Stanley E. & Edith L. Dennis	350/414	49.97
15	1-20.1	Albert Merton & Barbara Jo Mohrman	399/329	17.50
16	1-4	Haessly Hardwood Lumber Co.	290/457	166.20
17	1-21	Stanley E. & Edith L. Dennis	350/414	77.71
18	1-21.2	Friendly Public Service District	320/321	0.13
19	4-67	Richard L. Wright Jr, et al	408/24	71.41
20	4-66	Dianna M. Mikes	199/362	13.14
21	1-23	Otis Workman	168/186	3.32
22	4-63	Eagle Hardwood Inc.	345/195	16.79
23	4-62	Stephanie D. & Terrance D. Francis	537/521	3.75
24	4-65.1	Carl D. O'Neill	WB36/381	13.26
25	4-65	Carl D. O'Neill	248/117	45.90
26	4-80	Alice M., Harley R. & Judy Bungard	352/104	8.32
27	4-79	Earl A. & Patricia Snider	285/635	3.43
28	4-78.1	Earl Snider	220/11	6.63
29	4-78	Lesley J. Snider	220/13	6.83
30	4-77	Mary Ann Westbrook	243/98	9.5
31	4-69	Richard Lee & Linda Tuttle	362/43	87.48
32	4-75	Bryan & Martha J. Suter	293/345	12.20
33	4-76	Scott & Jeffery Grim	387/119	90.00
34	4-73	Bryan J. & Martha J. Suter	293/345	1.50
35	4-72	Bryan J. & Martha J. Suter	293/345	2.50
36	4-71	Darnell & Cindy Fulks	484/575	20.00
37	4-92	Robert W. & Jean A. Cross	342/751	53.00
38	4-91	Donna K. Johnston	184/133	54.06
39	5-4	Ralph D. & Sophia Judge	306/681	60.77
40	5-9.4	Neil R. Stebbins	366/436	51.48
41	5-12	Robert F. Scardina & Rita K. Scardina	320/646	25.00
42	5-10	Robert F. Scardina & Rita K. Scardina	320/646	25.00
43	5-11	Robert F. Scardina & Rita K. Scardina	320/646	25.00
44	8-14	Robert F. Scardina & Rita K. Scardina	320/646	72.79

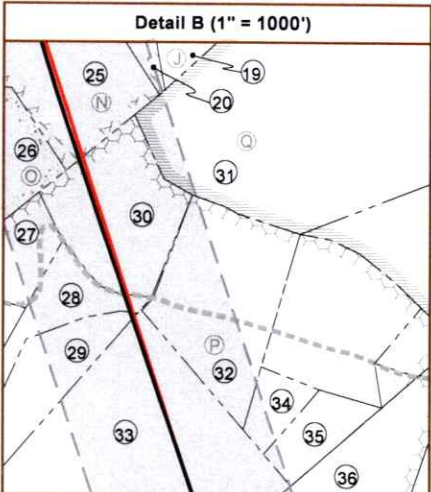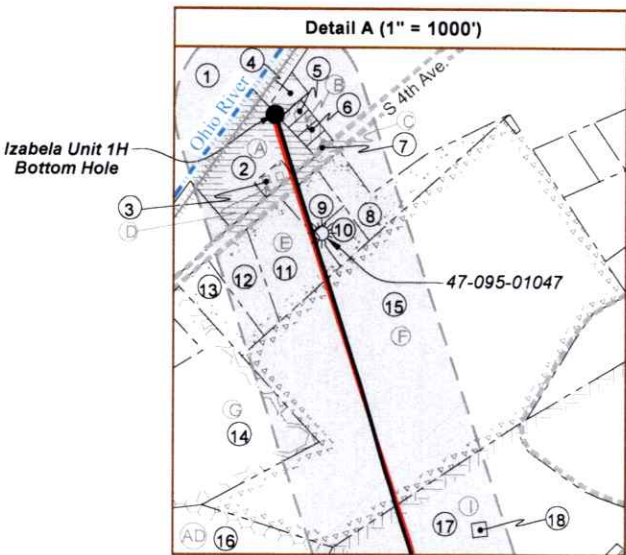

FILE NO: 64-54-L-25
DRAWING NO: Izabela Unit 1H As Drilled
SCALE: 1" = 2000'
MINIMUM DEGREE OF ACCURACY:
Submeter
PROVEN SOURCE OF ELEVATION:
WVDOT, Harrisville, WV

STATE OF WEST VIRGINIA
DEPARTMENT OF ENVIRONMENTAL PROTECTION
OIL AND GAS DIVISION

DATE: March 9 2026
OPERATOR'S WELL NO. Izabela Unit 1H
API WELL NO
47 - 095 - 02936
STATE COUNTY PERMIT

WELL TYPE: ☐ OIL ☒ GAS ☐ LIQUID INJECTION ☐ WASTE DISPOSAL
(IF GAS) PRODUCTION: ☐ STORAGE ☐ DEEP ☒ SHALLOW
LOCATION: ELEVATION: As-Built 1,092' WATERSHED: Outlet Middle Island Creek QUADRANGLE: Paden City
DISTRICT: Lincoln COUNTY: Tyler 05/01/2026
SURFACE OWNER: Robert F. Scardina & Rita K. Scardina ACREAGE: 25.00
ROYALTY OWNER: Robert F. Scardina & Rita K. Scardina LEASE NO: ACREAGE: 25
PROPOSED WORK: ☐ DRILL ☐ CONVERT ☐ DRILL DEEPER ☐ FRACTURE OR STIMULATE ☐ PLUG OFF OLD FORMATION
☐ PERFORATE NEW FORMATION ☒ OTHER PHYSICAL CHANGE IN WELL (SPECIFY) As Drilled 6,259' TVD
☐ PLUG AND ABANDON ☐ CLEAN OUT AND REPLUG TARGET FORMATION: Marcellus Shale ESTIMATED DEPTH: 18,053' MD

WELL OPERATOR: Antero Resources Corporation DESIGNATED AGENT: Conrad Baston
ADDRESS: 1615 Wynkoop Street ADDRESS: 535 White Oaks Blvd.
Denver, CO 80202 Bridgeport, WV 26330