



Legend

- Proposed gas well
- Monument, as noted
- Existing Well, as noted
- Digitized Well, as noted
- Creek or Drain
- Road
- Surface boundary (approx.)
- Interior surface tracts (approx.)


I, the undersigned, hereby certify that this plat is correct to the best of my knowledge and belief and shows all the information required by law and the rules issued and prescribed by the Department of Environmental Protection.

Bradley D. Miller

Bradley D. Miller, P.S. 2167



SEAL

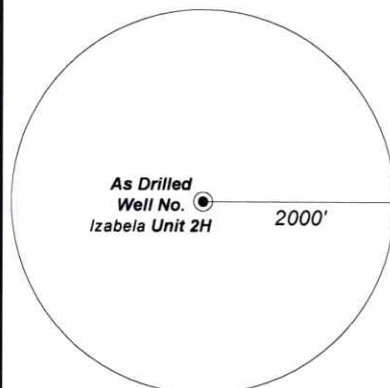

Note: No water wells were found within 2000' of proposed well. No occupied dwellings or buildings 2,500 square feet or larger used to house or shelter dairy cattle or poultry husbandry are located within 625' of the center of the well pad.

FILE NO: 64-54-L-25
DRAWING NO: Izabela Unit 2H Well Drilled
SCALE: 1" = 2000'
MINIMUM DEGREE OF ACCURACY: Submeter
PROVEN SOURCE OF ELEVATION: WVDOT, Harrisville, WV

STATE OF WEST VIRGINIA
DEPARTMENT OF ENVIRONMENTAL PROTECTION
OIL AND GAS DIVISION

DATE: March 9 2026
OPERATOR'S WELL NO. Izabela Unit 2H
API WELL NO
47 - 095 - 02937
STATE COUNTY PERMIT

WELL TYPE: ☐ OIL ☒ GAS ☐ LIQUID INJECTION ☐ WASTE DISPOSAL
(IF GAS) PRODUCTION: ☐ STORAGE ☐ DEEP ☒ SHALLOW
LOCATION: ELEVATION: As-Built 1,092' WATERSHED: Outlet Middle Island Creek QUADRANGLE: Paden City
DISTRICT: Lincoln COUNTY: Tyler 05/01/2026
SURFACE OWNER: Robert F. Scardina & Rita K. Scardina ACREAGE: 25.00
ROYALTY OWNER: Robert F. Scardina & Rita K. Scardina LEASE NO: ACREAGE: 25
PROPOSED WORK: ☐ DRILL ☐ CONVERT ☐ DRILL DEEPER ☐ FRACTURE OR STIMULATE ☐ PLUG OFF OLD FORMATION
☐ PERFORATE NEW FORMATION ☒ OTHER PHYSICAL CHANGE IN WELL (SPECIFY) As Drilled 6,272' TVD
☐ PLUG AND ABANDON ☐ CLEAN OUT AND REPLUG TARGET FORMATION: Marcellus Shale ESTIMATED DEPTH: 17,562' MD

WELL OPERATOR: Antero Resources Corporation DESIGNATED AGENT: Conrad Baston
ADDRESS: 1615 Wynkoop Street ADDRESS: 535 White Oaks Blvd.
Denver, CO 80202 Bridgeport, WV 26330

8,046' to Bottom Hole

3,693' to Top Hole

BHL LATITUDE 39 - 37 - 30
THL LATITUDE 39 - 35 - 00

LONGITUDE 80 - 55 - 00

10,419' to Bottom Hole

	Bearing	Dist.
L1	S 34°19' W	1,104.3'
L2	S 06°07' E	1,266.8'
L3	S 88°57' E	1,589.7'
L4	N 63°13' E	1,236.5'

Top Hole Coordinates, As-drilled data, and information was provided by Antero Resources Corporation. Allegheny Surveys Inc. (ASI) is not certifying the data and information provided. ASI is not responsible for any errors or inaccuracies with the data and information that has been provided.

Izabela Unit 2H Bottom Hole

See Detail "A"

See Detail "B"

Top Hole 7.5' Spot

BTM Hole 7.5' Spot

Notes
West Virginia Coordinate System of 1927, North Zone
based upon Differential GPS Measurements.
Well No. Izabela Unit 2H Top Hole coordinates are
N: 392,093.26' Latitude: 39°34'03.79"
E: 1,596,953.49' Longitude: 80°55'47.09"
Bottom Hole coordinates are
N: 402,603.07' Latitude: 39°35'46.99"
E: 1,592,757.81' Longitude: 80°56'42.82"
UTM Zone 17, NAD 1983
Top Hole Coordinates Bottom Hole Coordinates
N: 4,379,790.918m N: 4,382,971.430m
E: 506,049.227m E: 504,717.613m
Plat orientation and corner and well references are based upon the grid north meridian.
Well location references are based upon the magnetic meridian.

Notes:
Well No. Izabela Unit 2H As-Drilled POE Coordinates
WV Coordinate System of 1927, North Zone
N: 392,122.80'
E: 1,596,198.43'
Latitude: 39°34'03.96"
Longitude: 80°55'56.74"
UTM Zone 17, NAD 1983
N: 4,379,796.071m
E: 505,819.043m



Wellhead Layout (NTS)

- Grey Unit 2H (API# 47-095-02935)
- Grey Unit 1H (API# 47-095-02934)
- As Drilled Izabela Unit 2H (API# 47-095-02937)
- Izabela Unit 1H (API# 47-095-02936)
- Eleanor Unit 2H (API# 47-095-02933)
- Eleanor Unit 1H (API# 47-095-02932)



Leases	
E	T&D Corporation, et al
F	Stanley E. Dennis & Edith L. Dennis, JTWROS
I	Henry P. Snyder, et al
J	Aunix Energy, LLC
N	Ralph Mikes or Dora Mikes, h/w
P	John L. Renner, II
Q	Richard & Linda Tuttle, JTWROS
R	Martha Jean Suter & Bryan Jay Suter, h/w, JTWROS
S	Roger D. Jones
T	Bounty Minerals, LLC
U	Robert W. Cross & Jean A. Cross, JTWROS
W	Ralph David & Sophia Judge
X	AMP IV, LP.
Y	Robert F. Scardina & Rita K. Scardina, h/w
AA	Robert F. Scardina & Rita K. Scardina
AB	Robert F. Scardina & Rita K. Scardina

ID	TM-Par	Owner	Bk/Pg	Acres
1	xx-xx	Owner	xx/xx	x.xx
2	1-20.2	Trustees of Congregation of Jehovah's Witnesses	292/173	3.59
3	1-20.1	Albert Merton & Barbara Jo Mohrman	399/329	17.50
4	1-20.6	Timothy B. & Carolyn R. Hizer	409/549	1.39
5	1-20.3	Triad Hunter LLC	385/566	0.89
6	1-6.1	Charles M. & Rebecca Hayes	272/447	3.80
7	1-21	Stanley E. & Edith L. Dennis	350/414	77.71
8	1-21	Stanley E. & Edith L. Dennis	350/414	77.71
9	1-21.2	Friendly Public Service District	320/321	0.13
10	1-21.1	West Virginia Department of Highways	251/689	0.49
11	1-7	Alice M. Bungard	270/220	86.83
12	4-67	Richard L. Wright Jr, et al	408/24	71.41
13	4-66	Dianna M. Mikes	199/362	13.14
14	4-65	Carl D. O'Neill	248/117	45.90
15	4-77	Mary Ann Westbrooks	243/98	9.50
16	4-69	Richard Lee & Linda Tuttle	362/43	87.48
17	4-75	Bryan & Martha J. Suter	293/345	12.20
18	4-74	Kevin W. Barnhart	OR11/18	12.64
19	4-69.2	Bryan J. & Martha J. Suter	288/50	5.88
20	4-74.2	Darnell & Cindy Fulks	484/575	1.66
21	4-74.1	Darnell & Cindy Fulks	484/575	1.00
22	4-72	Bryan J. & Martha J. Suter	293/345	2.50
23	4-73	Bryan J. & Martha J. Suter	293/345	1.50
24	4-76	Scott & Jeffery Grim	387/119	90.00
25	4-71	Darnell & Cindy Fulks	484/575	20.00
26	4-70	Michael J. Eddy	352/129	19.00
27	5-2	Brian Clegg	OR2/648	19.44
28	4-92	Robert W. & Jean A. Cross	342/751	53.00
29	5-4	Ralph D. & Sophia Judge	306/681	60.77
30	5-9.4	Neil R. Stebbins	366/436	51.48
31	5-11	Robert F. Scardina & Rita K. Scardina	320/646	25.00
32	5-10	Robert F. Scardina & Rita K. Scardina	320/646	25.00
33	5-12	Robert F. Scardina & Rita K. Scardina	320/646	25.00

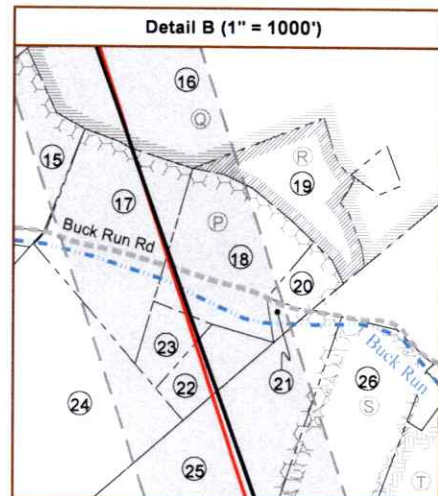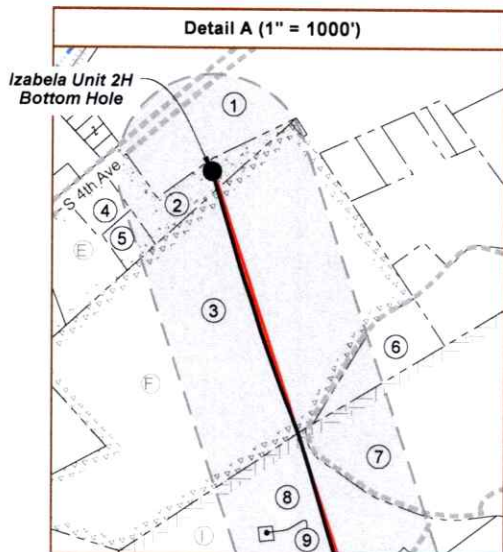

FILE NO: 64-54-L-25
DRAWING NO: Izabela Unit 2H Well Drilled
SCALE: 1" = 2000'
MINIMUM DEGREE OF ACCURACY:
Submeter
PROVEN SOURCE OF ELEVATION:
WVDOT, Harrisville, WV

STATE OF WEST VIRGINIA
DEPARTMENT OF ENVIRONMENTAL PROTECTION
OIL AND GAS DIVISION

DATE: March 9 2026
OPERATOR'S WELL NO. Izabela Unit 2H
API WELL NO
47 - 095 - 02937
STATE COUNTY PERMIT

WELL TYPE: ☐ OIL ☒ GAS ☐ LIQUID INJECTION ☐ WASTE DISPOSAL
(IF GAS) PRODUCTION: ☐ STORAGE ☐ DEEP ☒ SHALLOW
LOCATION: ELEVATION: As-Built 1,092' WATERSHED: Outlet Middle Island Creek QUADRANGLE: Paden City
DISTRICT: Lincoln COUNTY: Tyler 05/01/2026
SURFACE OWNER: Robert F. Scardina & Rita K. Scardina ACREAGE: 25.00
ROYALTY OWNER: Robert F. Scardina & Rita K. Scardina LEASE NO: ACREAGE: 25
PROPOSED WORK: ☐ DRILL ☐ CONVERT ☐ DRILL DEEPER ☐ FRACTURE OR STIMULATE ☐ PLUG OFF OLD FORMATION
☐ PERFORATE NEW FORMATION ☒ OTHER PHYSICAL CHANGE IN WELL (SPECIFY) As Drilled
☐ PLUG AND ABANDON ☐ CLEAN OUT AND REPLUG TARGET FORMATION: Marcellus Shale ESTIMATED DEPTH: 6,272' TVD 17,562' MD

WELL OPERATOR: Antero Resources Corporation DESIGNATED AGENT: Conrad Baston
ADDRESS: 1615 Wynkoop Street ADDRESS: 535 White Oaks Blvd.
Denver, CO 80202 Bridgeport, WV 26330