


TH: 10352' LAT: 39-40-00

Longwell 9H
Longwell
EQT Production Company

GRID NORTH


TH: 3625' LONG: 80-27-30

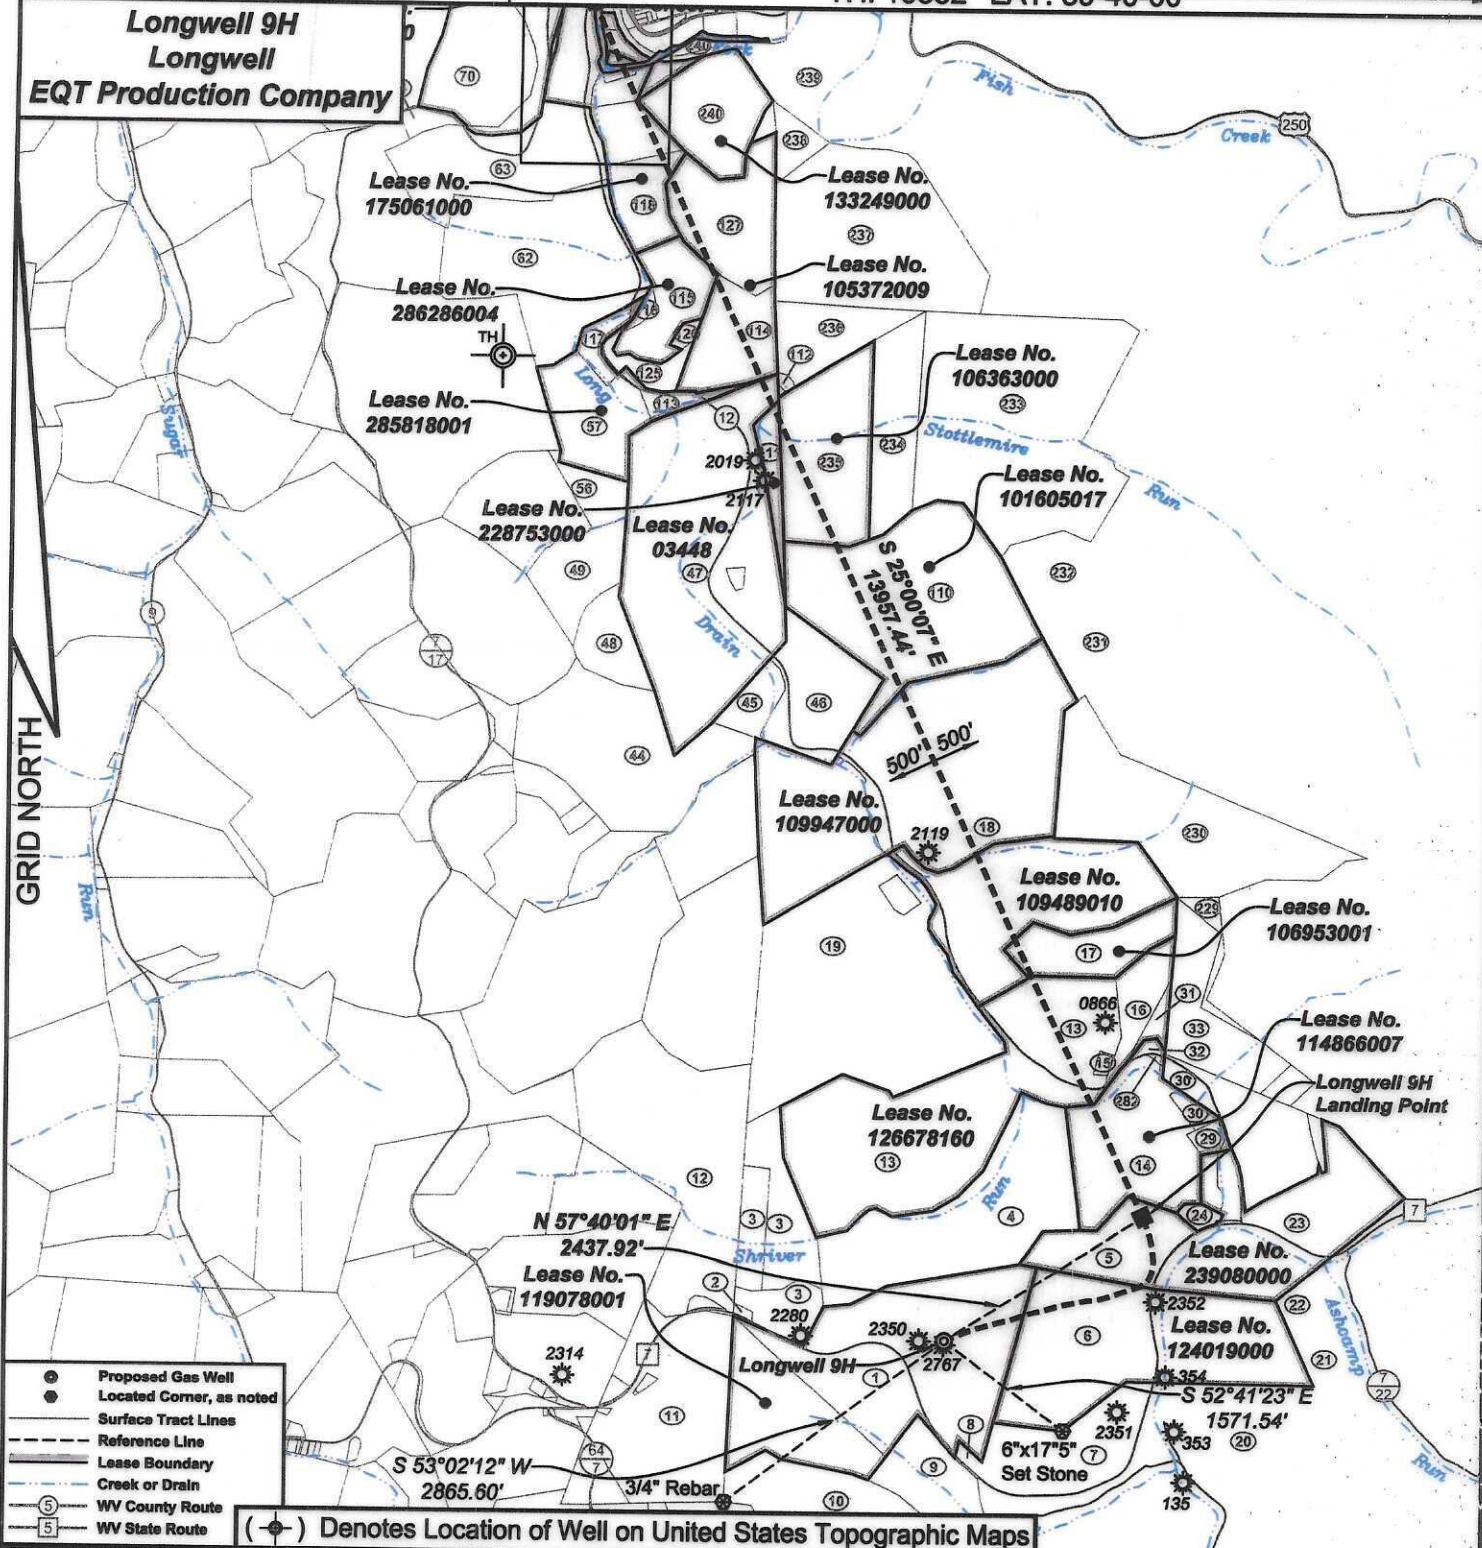

I, the undersigned, hereby certify that this plat is correct to the best of my knowledge and belief and shows all the information required by law and the regulations issued and prescribed by the Department of Environmental Protection.

[Signature]

P.S. 2092

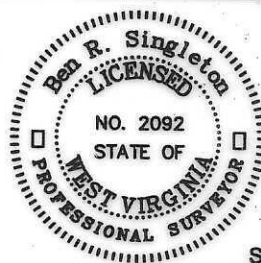

SEAL

FILE NO: 14-24

DRAWING NO: Longwell 9H

SCALE: 1" = 2000'

MINIMUM DEGREE OF ACCURACY: 1:2500

PROVEN SOURCE OF ELEVATION: NGS CORS Station

STATE OF WEST VIRGINIA
DEPARTMENT OF ENVIRONMENTAL PROTECTION
OIL AND GAS DIVISION



DATE: April 21 20 26

OPERATOR'S WELL NO.: Longwell 9H

API WELL NO

47 - 103 - 03759
STATE COUNTY PERMIT

WELL TYPE: ☐ OIL ☒ GAS ☐ LIQUID INJECTION ☐ WASTE DISPOSAL
(IF GAS) PRODUCTION: ☐ STORAGE ☐ DEEP ☒ SHALLOW

LOCATION: ELEVATION: As-Built: 1435' WATERSHED Long Drain of West Virginia Fork Fish Creek QUADRANGLE: Hundred

DISTRICT: Church and Clay COUNTY: Wetzel

SURFACE OWNER: Jeffery Todd Longwell

ACREAGE: 106.50

ROYALTY OWNER: Jeffery Todd Longwell, et al

LEASE NO: 119078001

ACREAGE: 106.50

PROPOSED WORK: ☒ DRILL ☐ CONVERT ☐ DRILL DEEPER ☒ FRACTURE OR STIMULATE ☐ PLUG OFF OLD FORMATION
☐ PERFORATE NEW FORMATION ☐ OTHER PHYSICAL CHANGE IN WELL (SPECIFY)

☐ PLUG AND ABANDON ☐ CLEAN OUT AND REPLUG TARGET FORMATION: Marcellus ESTIMATED DEPTH: 7,711'

WELL OPERATOR: EQT Production Company

DESIGNATED AGENT: Joseph C. Mallow

ADDRESS: 2200 Energy Drive

ADDRESS: 427 Midstate Drive

Canonsburg, PA 15317

Clarksburg, WV 26301

BH: 2945' LAT: 39-42-30

Longwell 9H
Longwell
EQT Production Company

Lease No.
286537003

Lease No.
140111000

Lease No.
290843001

See
Sheet 5

Lease No.
287538000

Lease No.
166850000

See
Sheet 4

Lease No.
175061000

Lease No.
286286004

Lease No.
285818001

Lease No.
228753000

Lease No.
03448

Lease No.
133249000

Lease No.
105372009

Lease No.
106363000

Lease No.
101605017

Lease No.
109947000

Lease No.
109489010

Lease No.
106953001

Lease No.
114866007

Longwell 9H
Landing Point

Lease No.
126678160

Lease No.
239080000

Lease No.
124019000

N 57°40'01" E
2437.92'

Lease No.
119078001

S 53°02'12" W
2865.60'

3/4" Rebar

Longwell 9H

6"x17"5"
Set Stone

S 52°41'23" E
1571.54'

05/22/2026

BH: 4203' LONG: 80-30-00


GRID NORTH

Longwell 9H
Longwell
EQT Production Company

BH: 8826' LAT: 39-45-00

BH: 6482' LONG: 80-30-00

GRID NORTH

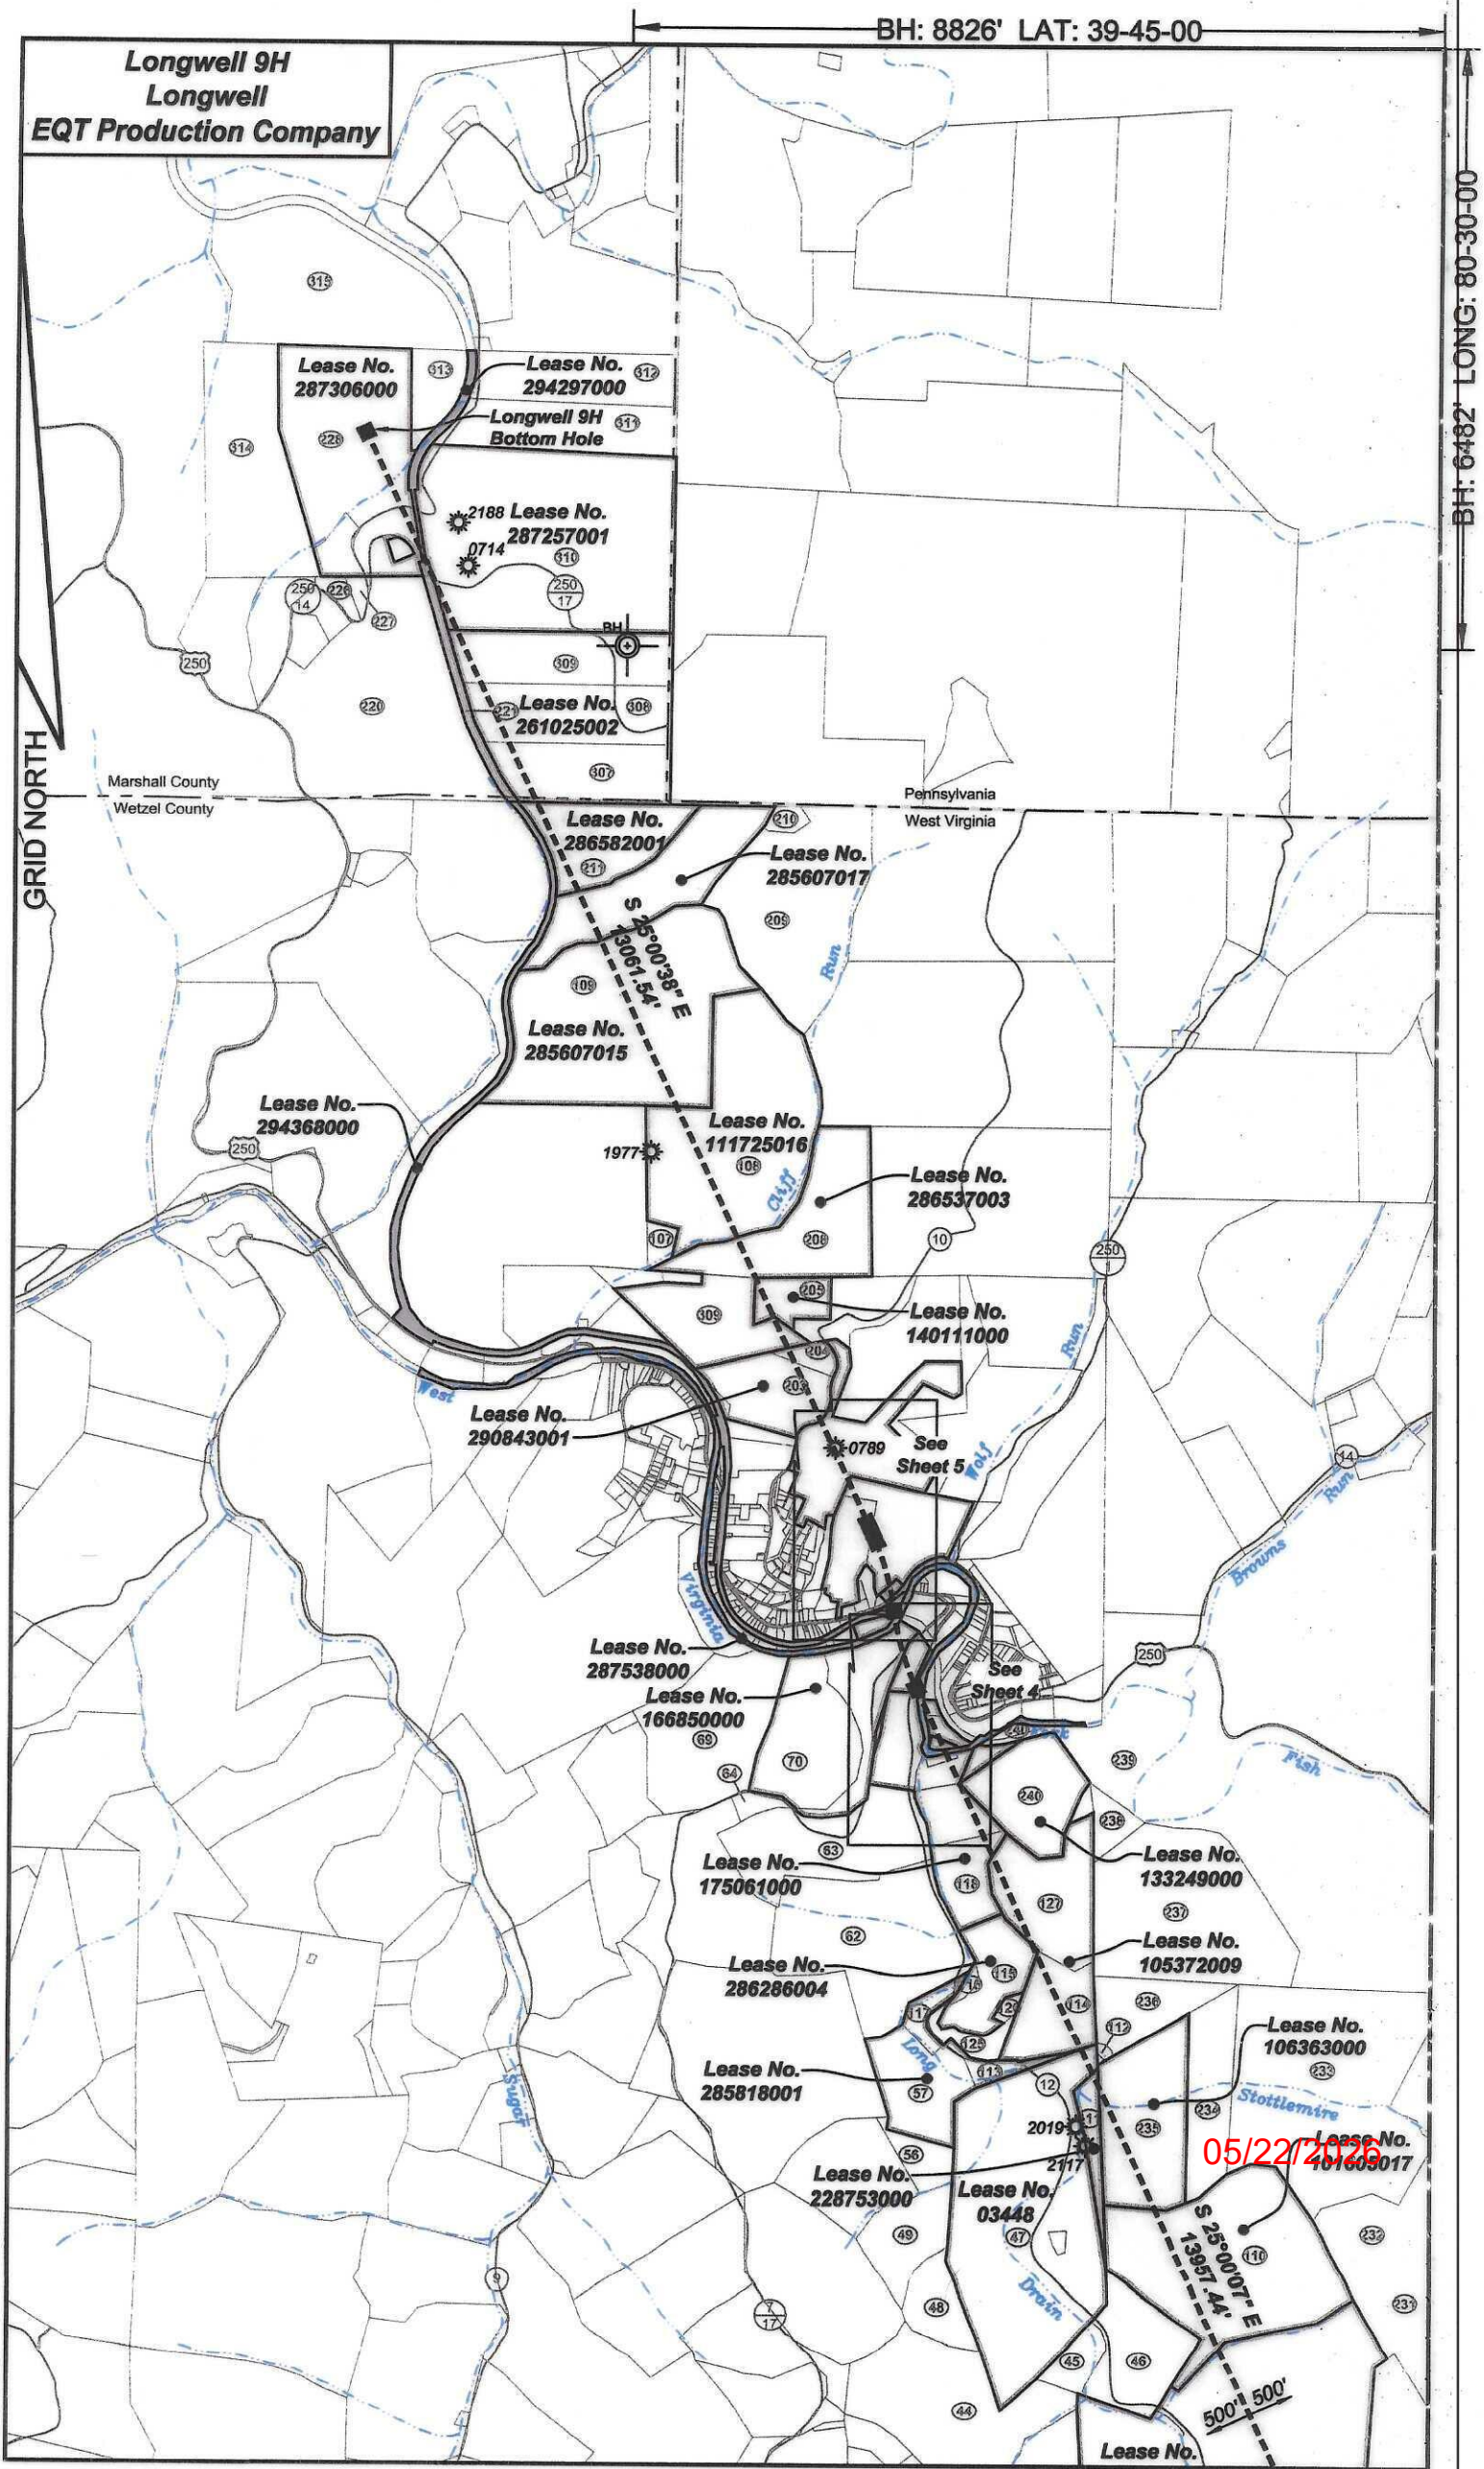

05/22/2026

Longwell 9H
Longwell
EQT Production Company

N 07°10'22" W
9.13'

GRID NORTH

Lease No.
166850000

Lease No.
286578000

Lease No.
03933

Lease No.
290549001

Lease No.
288105002

Lease No.
287538000

Lease No.
122005000

Lease No.
175061000

Lease No.
133249000

05/22/2026

CURVE	RADIUS	ARC LENGTH	CHORD BEARING	CHORD LENGTH
C1	2864.34'	891.32'	N 16°05'14" W	887.73'
C2	2855.88'	778.71'	N 14°59'03" W	776.30'
C3	2676.21'	103.47'	N 23°54'11" W	103.46'

Longwell 9H
Longwell
EQT Production Company

CURVE	RADIUS	ARC LENGTH	CHORD BEARING	CHORD LENGTH
C1	2864.34'	891.32'	N 16°05'14" W	887.73'
C2	2855.88'	778.71'	N 14°59'03" W	776.30'
C3	2676.21'	103.47'	N 23°54'11" W	103.46'

GRID NORTH

0789

Lease No.
126339018

306

Lease No.
111207003

304

N 23°41'4" E
122.71'

C2

Lease No.
283335000

303

307

Lease No.
294368000

300

N 07°10'22" W
9.73'

05/22/2026

250

103


246

246

Longwell 9H
Longwell
EQT Production Company

Tract I.D.	Tax Map No.	Parcel No.	County	District	Surface Tract Owner	Acres
1	10	13	Wetzel	Church	Jeffery I. Longwell	106.6
2	10	14	Wetzel	Church	Leann L. Hams & Penny L. Sole	0.6
3	10	4	Wetzel	Church	Lela J. LeMasters	33.09
4	10	5	Wetzel	Church	Bruce & Linda Garrison	61.5
5	6	29	Wetzel	Church	Larry V. Watson, et al	17.86
6	10	15	Wetzel	Church	Charles I. Miller	30
7	10	23	Wetzel	Church	John R. Riss	33
8	10	22	Wetzel	Church	Paul Hill Chapel	1.8
9	10	21	Wetzel	Church	Charles L. Matthews	29
10	10	20	Wetzel	Church	Catherine Roberts, et al.	50
11	10	12	Wetzel	Church	Hamel L. Hustn	56.32
12	1	19	Wetzel	Clay	McLach Land LLC	73.211
13	6	23	Wetzel	Church	Bruce & Linda Garrison	124
14	6	25	Wetzel	Church	Larry V. Watson, et al	40.83
15	6	24	Wetzel	Church	Shriver Cemetery	0.88
16	6	12	Wetzel	Church	Edward M. Balkauf, et al	9.04
17	7	11	Wetzel	Clay	Edward M. Balkauf, et al	20.5
18	7	8	Wetzel	Clay	Paul R. Curry, et al	130
19	1	12	Wetzel	Clay	Wilde M. Church & Peggy Brown	204.35
20	10	25	Wetzel	Church	Allin K. Greathouse	23
21	10	16	Wetzel	Church	Nicholas L. & Joseph K. Eastham	27
22	10	1	Wetzel	Church	David R. Watson, et al.	6.5
23	10	6	Wetzel	Church	Nicholas L. & Joseph K. Eastham	48.39
24	6	26	Wetzel	Church	Thomas Chapel	1.4
25	6	29.1	Wetzel	Church	Board of Education	10.61
26	6	27	Wetzel	Church	Larry V. Watson, et al	2.54
27	6	13	Wetzel	Church	Edward M. Balkauf, et al	2.9
28	6	14.1	Wetzel	Church	Edward M. Balkauf, et al	1.24
29	6	15	Wetzel	Church	Edward M. Balkauf, et al	28.5
30	1	1	Wetzel	Clay	Howard W. Farnish, Jr.	52.5
31	1	6	Wetzel	Clay	Stephen I. Varner	1
32	1	1	Wetzel	Clay	William A. Myers II	29.0
33	4	48	Wetzel	Clay	Stephen I. Varner	116.3
34	7	5	Wetzel	Clay	Stephen T. Varner	12.8
35	4	50.1	Wetzel	Clay	Richard L. Wise	23.05
36	4	49	Wetzel	Clay	Jack & Linda Mason	7.46
37	4	33	Wetzel	Clay	Jack & Linda Mason	19.08
38	1	25	Wetzel	Clay	Ralph M. Cramer	56.5
39	1	28	Wetzel	Clay	Robert J. Minor	38.3
40	1	27	Wetzel	Clay	Susan J. Minor	3.3
41	1	3	Wetzel	Clay	Urdley A. Calp	42.5
42	1	1	Wetzel	Clay	Godwin Living Trust	48.5
43	2	63	Wetzel	Clay	CNX Land LLC	61.94
44	2	19.1	Wetzel	Clay	Kevin N. Soles	3
45	2	19	Wetzel	Clay	Donna D. Soles	101.4
46	2	6	Wetzel	Clay	Sarah F. Fitzgerald Falate, et al	160
47	4	46	Wetzel	Clay	William Myers	77.7
48	4	42	Wetzel	Clay	Tim Williams	6
49	1	40	Wetzel	Clay	Ty Rabe	0.5
50	1	39	Wetzel	Clay	Jamie Johnson	4.4
51	1	38	Wetzel	Clay	L.N. Murphy	20.2
52	1	36	Wetzel	Clay	Dallison Lumber Inc.	11.8
53	1	35	Wetzel	Clay	Walter Longwell	1.2
54	4	34	Wetzel	Clay	William White	8.6
55	4	24	Wetzel	Clay	Dallison Lumber Inc.	10.3
56	4	53	Wetzel	Clay	Maureen Mackey	7.85
57	4	53.1	Wetzel	Clay	Maureen Mackey	3.4
58	4	57	Wetzel	Clay	David Milk	9.88
59	4	52	Wetzel	Clay	William Smith Estate	8
60	1	57	Wetzel	Clay	Piney Holdings Inc.	1.2
61	4	22	Wetzel	Clay	F.N. Murphy	33.5
62	1	4.1	Wetzel	Clay	Kevin S. & Melinda S. Gott	0.39
63	1	4.2	Wetzel	Clay	Patricia Parker	2.3
64	2	26	Wetzel	Clay	Constance Melghen	30.2
65	2	62	Wetzel	Clay	Thomas I. Melghen, et al	1
66	2	35	Wetzel	Clay	David Miller	13
67	2	18	Wetzel	Clay	Michael Wade	66
68	2	1	Wetzel	Clay	Thomas Strick	88.5
69	2	7	Wetzel	Clay	Kevin Soles	1.5
70	2	5	Wetzel	Clay	Thomas Bilinovich	31.5
71	23	16	Marshall	Liberty	Michael Pomeroy	99.55
72	23	29	Marshall	Liberty	CNX Land LLC	124.8
73	23	10	Marshall	Liberty	Virginia Midcap	1
74	23	17	Marshall	Liberty	Venuti H&G	2
75	23	7	Marshall	Liberty	Paul Lucas	77.777
76	6	16	Wetzel	Church	Edward M. Balkauf, et al.	4.7
77	6	7	Wetzel	Church	Dallison Lumber Inc.	88
78	1	9	Wetzel	Clay	James Jones Estate	15.3
79	1	45	Wetzel	Clay	James Jones Estate	24.3
80	4	43	Wetzel	Clay	Kathryn Simoni	104
81	4	43.1	Wetzel	Clay	Kathryn Simoni	31.50
82	1	41	Wetzel	Clay	Valerie Kiger	37.33
83	4	21.1	Wetzel	Clay	Kathleen Mercer	45
84	1	21	Wetzel	Clay	Wilma Omduff	72.0
85	1	20.1	Wetzel	Clay	Wilma Omduff	4.5
86	4	20	Wetzel	Clay	Aaron Kalat	34.6
87	1	23	Wetzel	Clay	Richard Korman	30.4
88	1	54	Wetzel	Clay	Maureen Mackey	2
89	4	53.2	Wetzel	Clay	Hundred Littleton PSD	0.949
90	4	53.3	Wetzel	Clay	Hundred Littleton PSD	0.754
91	9	30	Wetzel	Clay	Hundred Littleton PSD	3.4
92	9	31	Wetzel	Clay	Paula Mackey	0.5
93	9	32	Wetzel	Clay	David Park	0.5
94	9	33	Wetzel	Clay	Patricia Parker	0.575
95	2L	65	Wetzel	Clay	Larry Wharton	1.5
96	2L	64	Wetzel	Clay	Larry Wharton	0.5
97	6	11	Wetzel	Church	Larry Watson	0.18
98	3L	15	Wetzel	Clay	CNX Land LLC	0.8
99	3L	12	Wetzel	Clay	Patricia St. John	Lot
100	3L	13	Wetzel	Clay	Patricia St. John	Lot
101	3L	14	Wetzel	Clay	Patricia St. John	Lot
102	2	38	Wetzel	Clay	Agnes King Fal	26.7
103	3L	6	Wetzel	Clay	Agnes King Fal	13
104	2	39	Wetzel	Clay	James Murphy, et al.	65
105	23	15	Liberty	Marshall	Thomas J. Bilinovich	32
106	23	14	Liberty	Marshall	Thomas J. Bilinovich	32
107	23	13	Liberty	Marshall	Thomas J. Bilinovich	32
108	23	12	Liberty	Marshall	Thomas J. Bilinovich	32
109	23	11	Liberty	Marshall	Thomas J. Bilinovich	32
110	23	10	Liberty	Marshall	Thomas J. Bilinovich	32
111	23	9	Liberty	Marshall	Thomas J. Bilinovich	32
112	23	8	Liberty	Marshall	Thomas J. Bilinovich	32
113	23	7	Liberty	Marshall	Thomas J. Bilinovich	32
114	23	6	Liberty	Marshall	Thomas J. Bilinovich	32
115	23	5	Liberty	Marshall	Thomas J. Bilinovich	32
116	23	4	Liberty	Marshall	Thomas J. Bilinovich	32
117	23	3	Liberty	Marshall	Thomas J. Bilinovich	32
118	23	2	Liberty	Marshall	Thomas J. Bilinovich	32
119	23	1	Liberty	Marshall	Thomas J. Bilinovich	32
120	23	0	Liberty	Marshall	Thomas J. Bilinovich	32

Well References

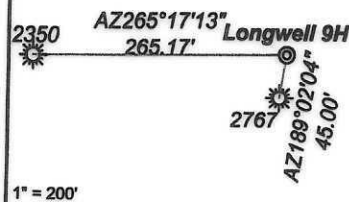

Notes:

Longwell 9H coordinates are
NAD 27 N: 422,853.13 E: 1,719,833.53
NAD 27 Lat: 39.656716 Long: -80.495101
NAD 83 UTM N: 4,389,788.28 E: 543,329.92
Longwell 9H Landing Point coordinates are
NAD 27 N: 424,157.02 E: 1,721,893.45
NAD 27 Lat: 39.660358 Long: -80.487836
NAD 83 UTM N: 4,390,196.00 E: 543,950.88
Longwell 9H Bottom Hole coordinates are
NAD 27 N: 450,463.00 E: 1,709,934.79
NAD 27 Lat: 39.732206 Long: -80.531382
NAD 83 UTM N: 4,394,229.11 E: 541,987.55
West Virginia Coordinate system of 1927 (North Zone)
based upon Differential GPS Measurements.
Plat orientation, corner and well ties are based upon
the grid north meridian.
Well location references are based upon the grid north
meridian.
UTM coordinates are NAD83, Zone 17, Meters.

Longwell

Longwell 11H

Longwell 9H

Longwell 7H

Longwell 5H

Longwell 1H

Longwell 3H

Lease No.

Owner

Acres

119078001	Jeffery Todd Longwell, et al.	106.5
124019000	Janice Cosgray, et al.	90
239080000	EQT TGH Exploration II LLC, et al.	85
114868007	Samuel Harlan Ellis, et al.	45.13
126678160	Stone Hill Mineral Holdings, LLC, et al.	194
106953001	Nancy Dawn Cosgray, et al.	20.5 of 49
109489010	Paul R. Curry, et ux., et al.	170
109947000	Peggy Church Brown, et al.	31.307949 of 140
101605017	Linda Jo Wood Smith, et al.	80
106363000	Janet E. Love, et al.	37.5
228753000	William Francis Vieweg, et al.	6 of 50
03448	Steve Varner, et al.	116 of 152
285818001	Country Roads Minerals, LLC, et al.	36
105372009	AMP IV, LP, et al.	53.70
286286004	Gary H. Kappel, et al.	12.80
175061000	BRC Appalachian Minerals I, LLC BRC Minerals LP	36 of 31151.581
133249000	Elk Range Royalties II, LP, et al.	32.588
122005000	Maureen V. Mackey, et al.	2.00
287538000	West Virginia Division of Natural Resources	38.1877
288105002	Morris Mountaineer Oil and Gas, et al.	0.75
290549001	Morris Mountaineer Oil and Gas, et al.	3.146
03933	Liberty Holding Company	0.575
286578000	Bounty Minerals, et al.	16.30
166850000	AMP IV, LP, et al.	48.5
294368000	CNX Gas Company, LLC	61.94
294368000	CNX Gas Company, LLC	0.80
283335000	Patricia A. St. John	0.26
111207003	Patsy Ann Carlsson, et al.	39.90
126339018	Wilma Marie Morris, et al.	109.80
290843001	Constance Melghen-Cichon	34.2
140111000	EQT TGH Exploration II LLC	13 of 1962.7875
286537003	Foss Minerals, LLC, et al.	81.70
111725016	Standard Land Company, LLC, et al.	101.1375
285607015	The Habitat for Humanity, et al.	160
285607017	George Doyle Self, et al.	160
286582001	Thomas F. Bilinovich 2017 Trust, et al.	31.50
261025002	Chestnut Holdings, Inc., et al.	96
287257001	Highlands Royalty Fund LLC, et al.	130
294297000	CNX Gas Company LLC	8.71
287306000	AMP V, LP	83.0125

