
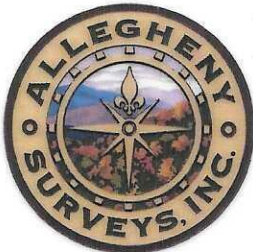


TH: 10350' LAT: 39-40-00

Longwell 11H
Longwell
EQT Production Company


GRID NORTH

TH: 3610' LONG: 80-27-30

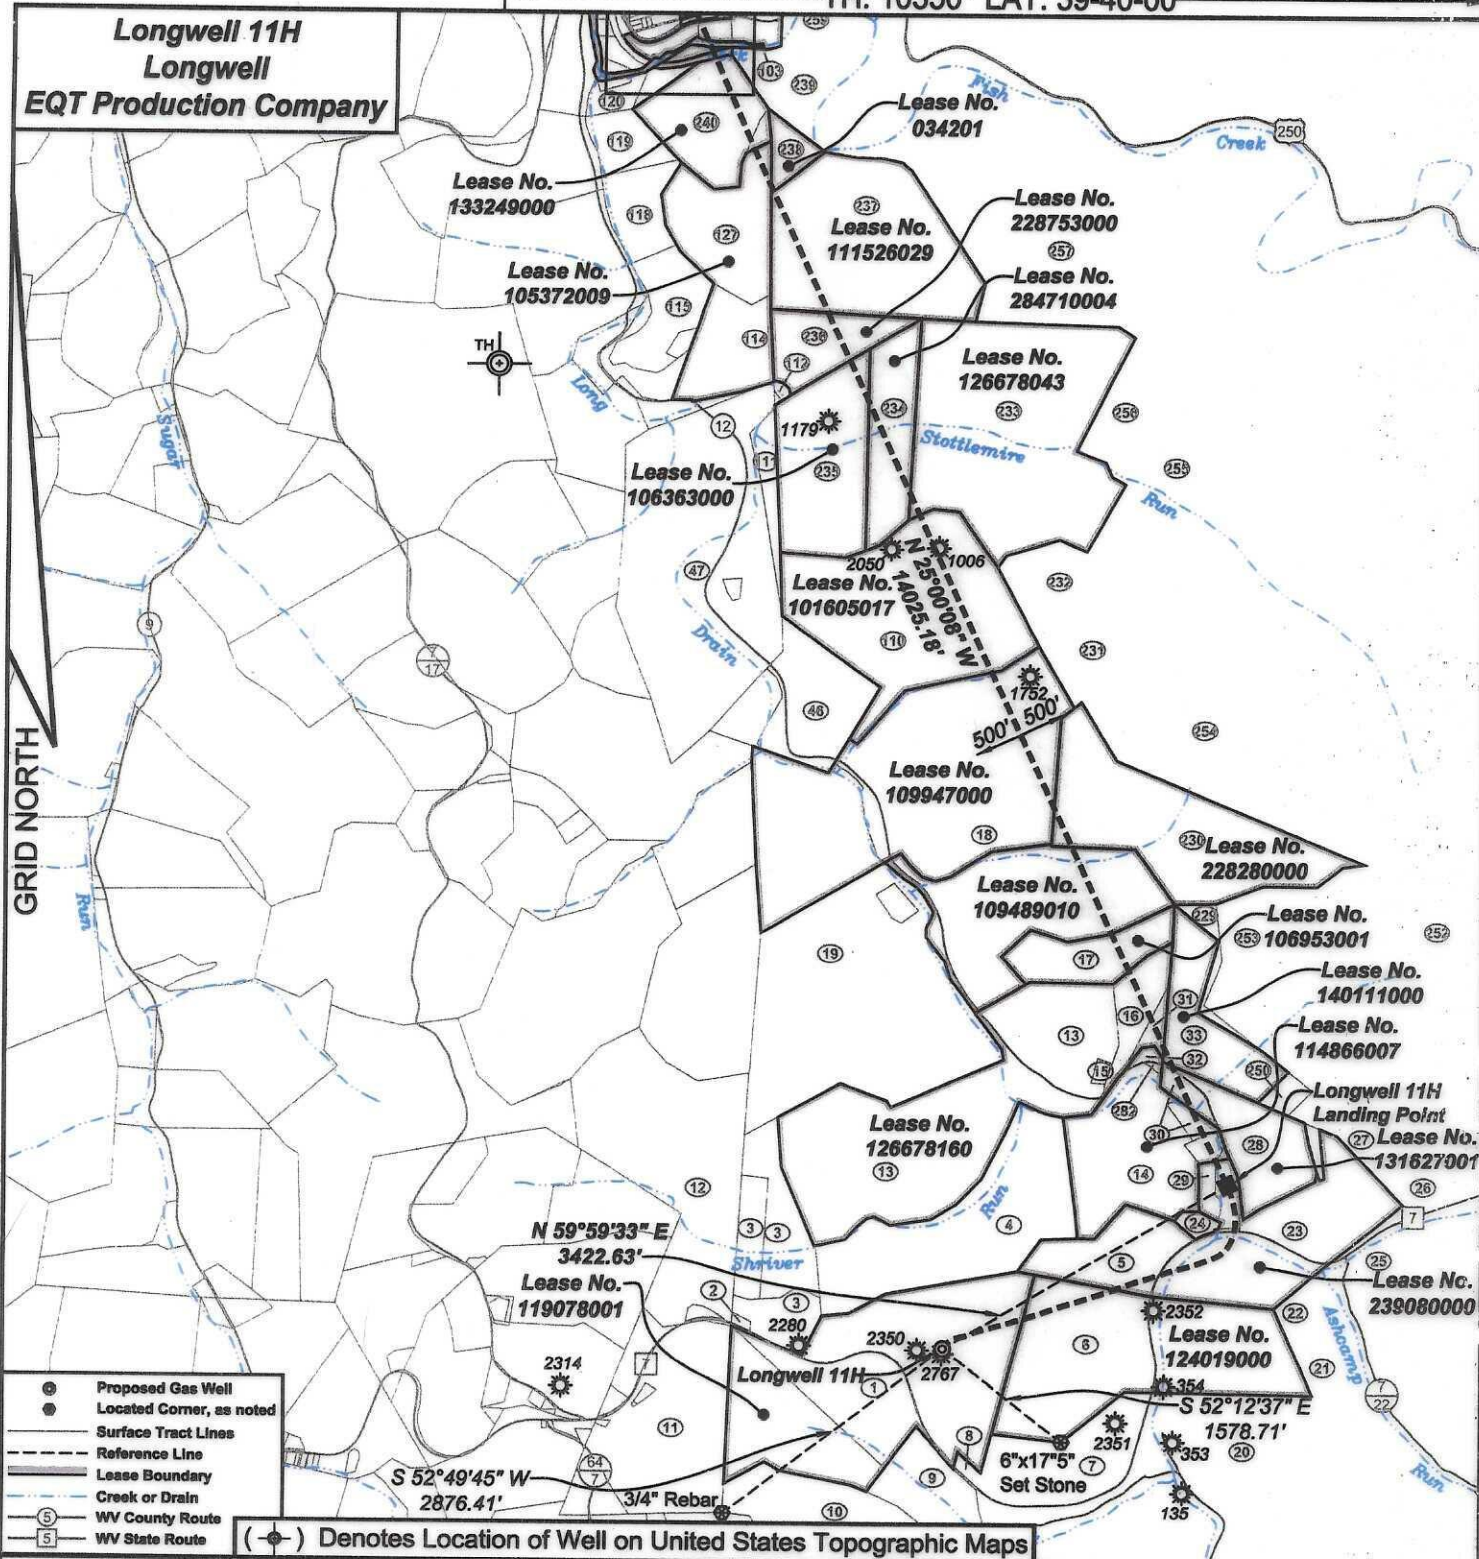

I, the undersigned, hereby certify that this plat is correct to the best of my knowledge and belief and shows all the information required by law and the regulations issued and prescribed by the Department of Environmental Protection.

Ben R. Singleton
P.S. 2092

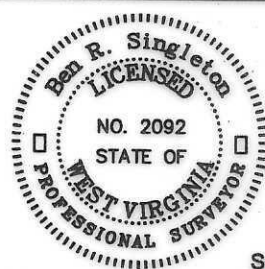

SEAL

FILE NO: 14-24

DRAWING NO: Longwell 11H

SCALE: 1" = 2000'

MINIMUM DEGREE OF ACCURACY:
1:2500

PROVEN SOURCE OF ELEVATION:
NGS CORS Station

STATE OF WEST VIRGINIA
DEPARTMENT OF ENVIRONMENTAL PROTECTION
OIL AND GAS DIVISION



DATE: April 23 20 26

OPERATOR'S WELL NO.: Longwell 11H

API WELL NO

47 - 103 - 03760
STATE COUNTY PERMIT

WELL TYPE: ☐ OIL ☒ GAS ☐ LIQUID INJECTION ☐ WASTE DISPOSAL
(IF GAS) PRODUCTION: ☐ STORAGE ☐ DEEP ☒ SHALLOW

LOCATION: ELEVATION: As-Built: 1435' WATERSHED Long Drain of West Virginia Fork Fish Creek QUADRANGLE: Hundred

DISTRICT: Church and Clay COUNTY: Wetzel

SURFACE OWNER: Jeffery Todd Longwell

ACREAGE: 106.50

ROYALTY OWNER: Jeffery Todd Longwell, et al

LEASE NO: 119078001

ACREAGE: 106.50

PROPOSED WORK: ☒ DRILL ☐ CONVERT ☐ DRILL DEEPER ☒ FRACTURE OR STIMULATE ☐ PLUG OFF OLD FORMATION
☐ PERFORATE NEW FORMATION ☐ OTHER PHYSICAL CHANGE IN WELL (SPECIFY)

☐ PLUG AND ABANDON ☐ CLEAN OUT AND REPLUG TARGET FORMATION: Marcellus ESTIMATED DEPTH: 7,711'

WELL OPERATOR: EQT Production Company

DESIGNATED AGENT: Joseph C. Mallow


ADDRESS: 2200 Energy Drive

ADDRESS: 427 Midstate Drive

Canonsburg, PA 15317

Clarksburg, WV 26301

Longwell 11H
Longwell
EQT Production Company

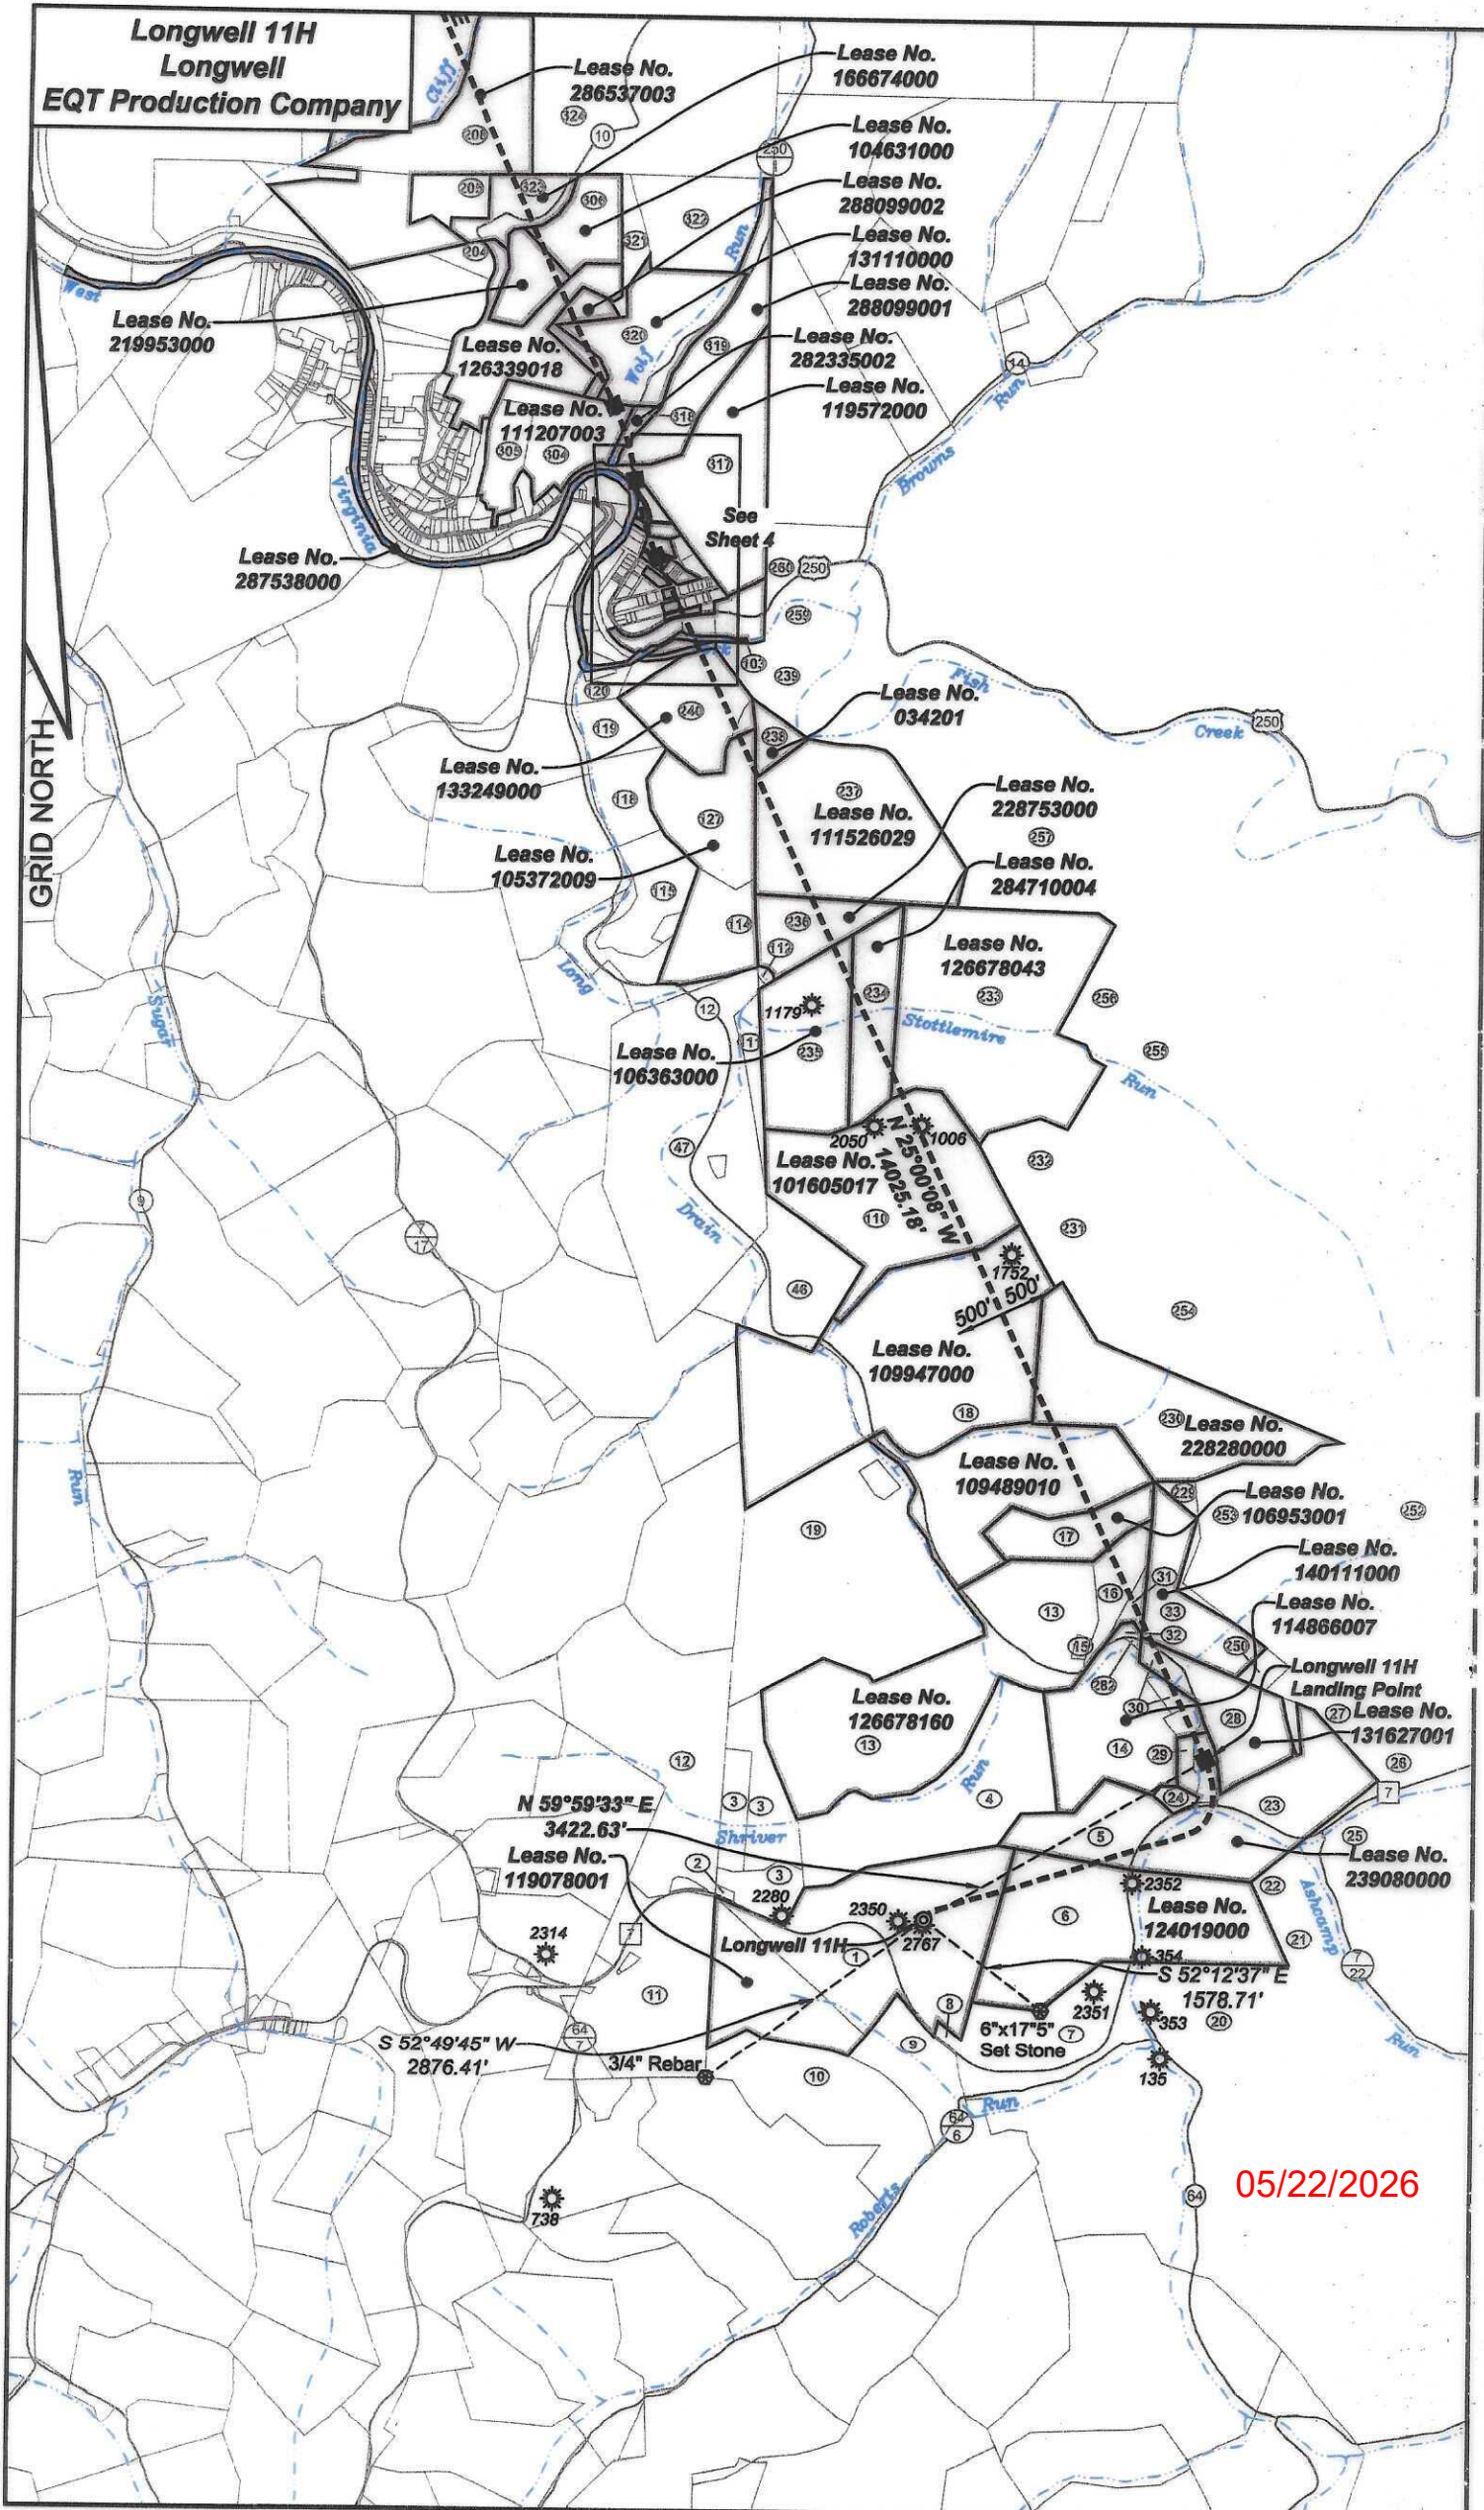


05/22/2026

**Longwell 11H
Longwell
EQT Production Company**

BH: 7679' LAT: 39-45-00


BH: 6653' LONG: 80-30-00

GRID NORTH

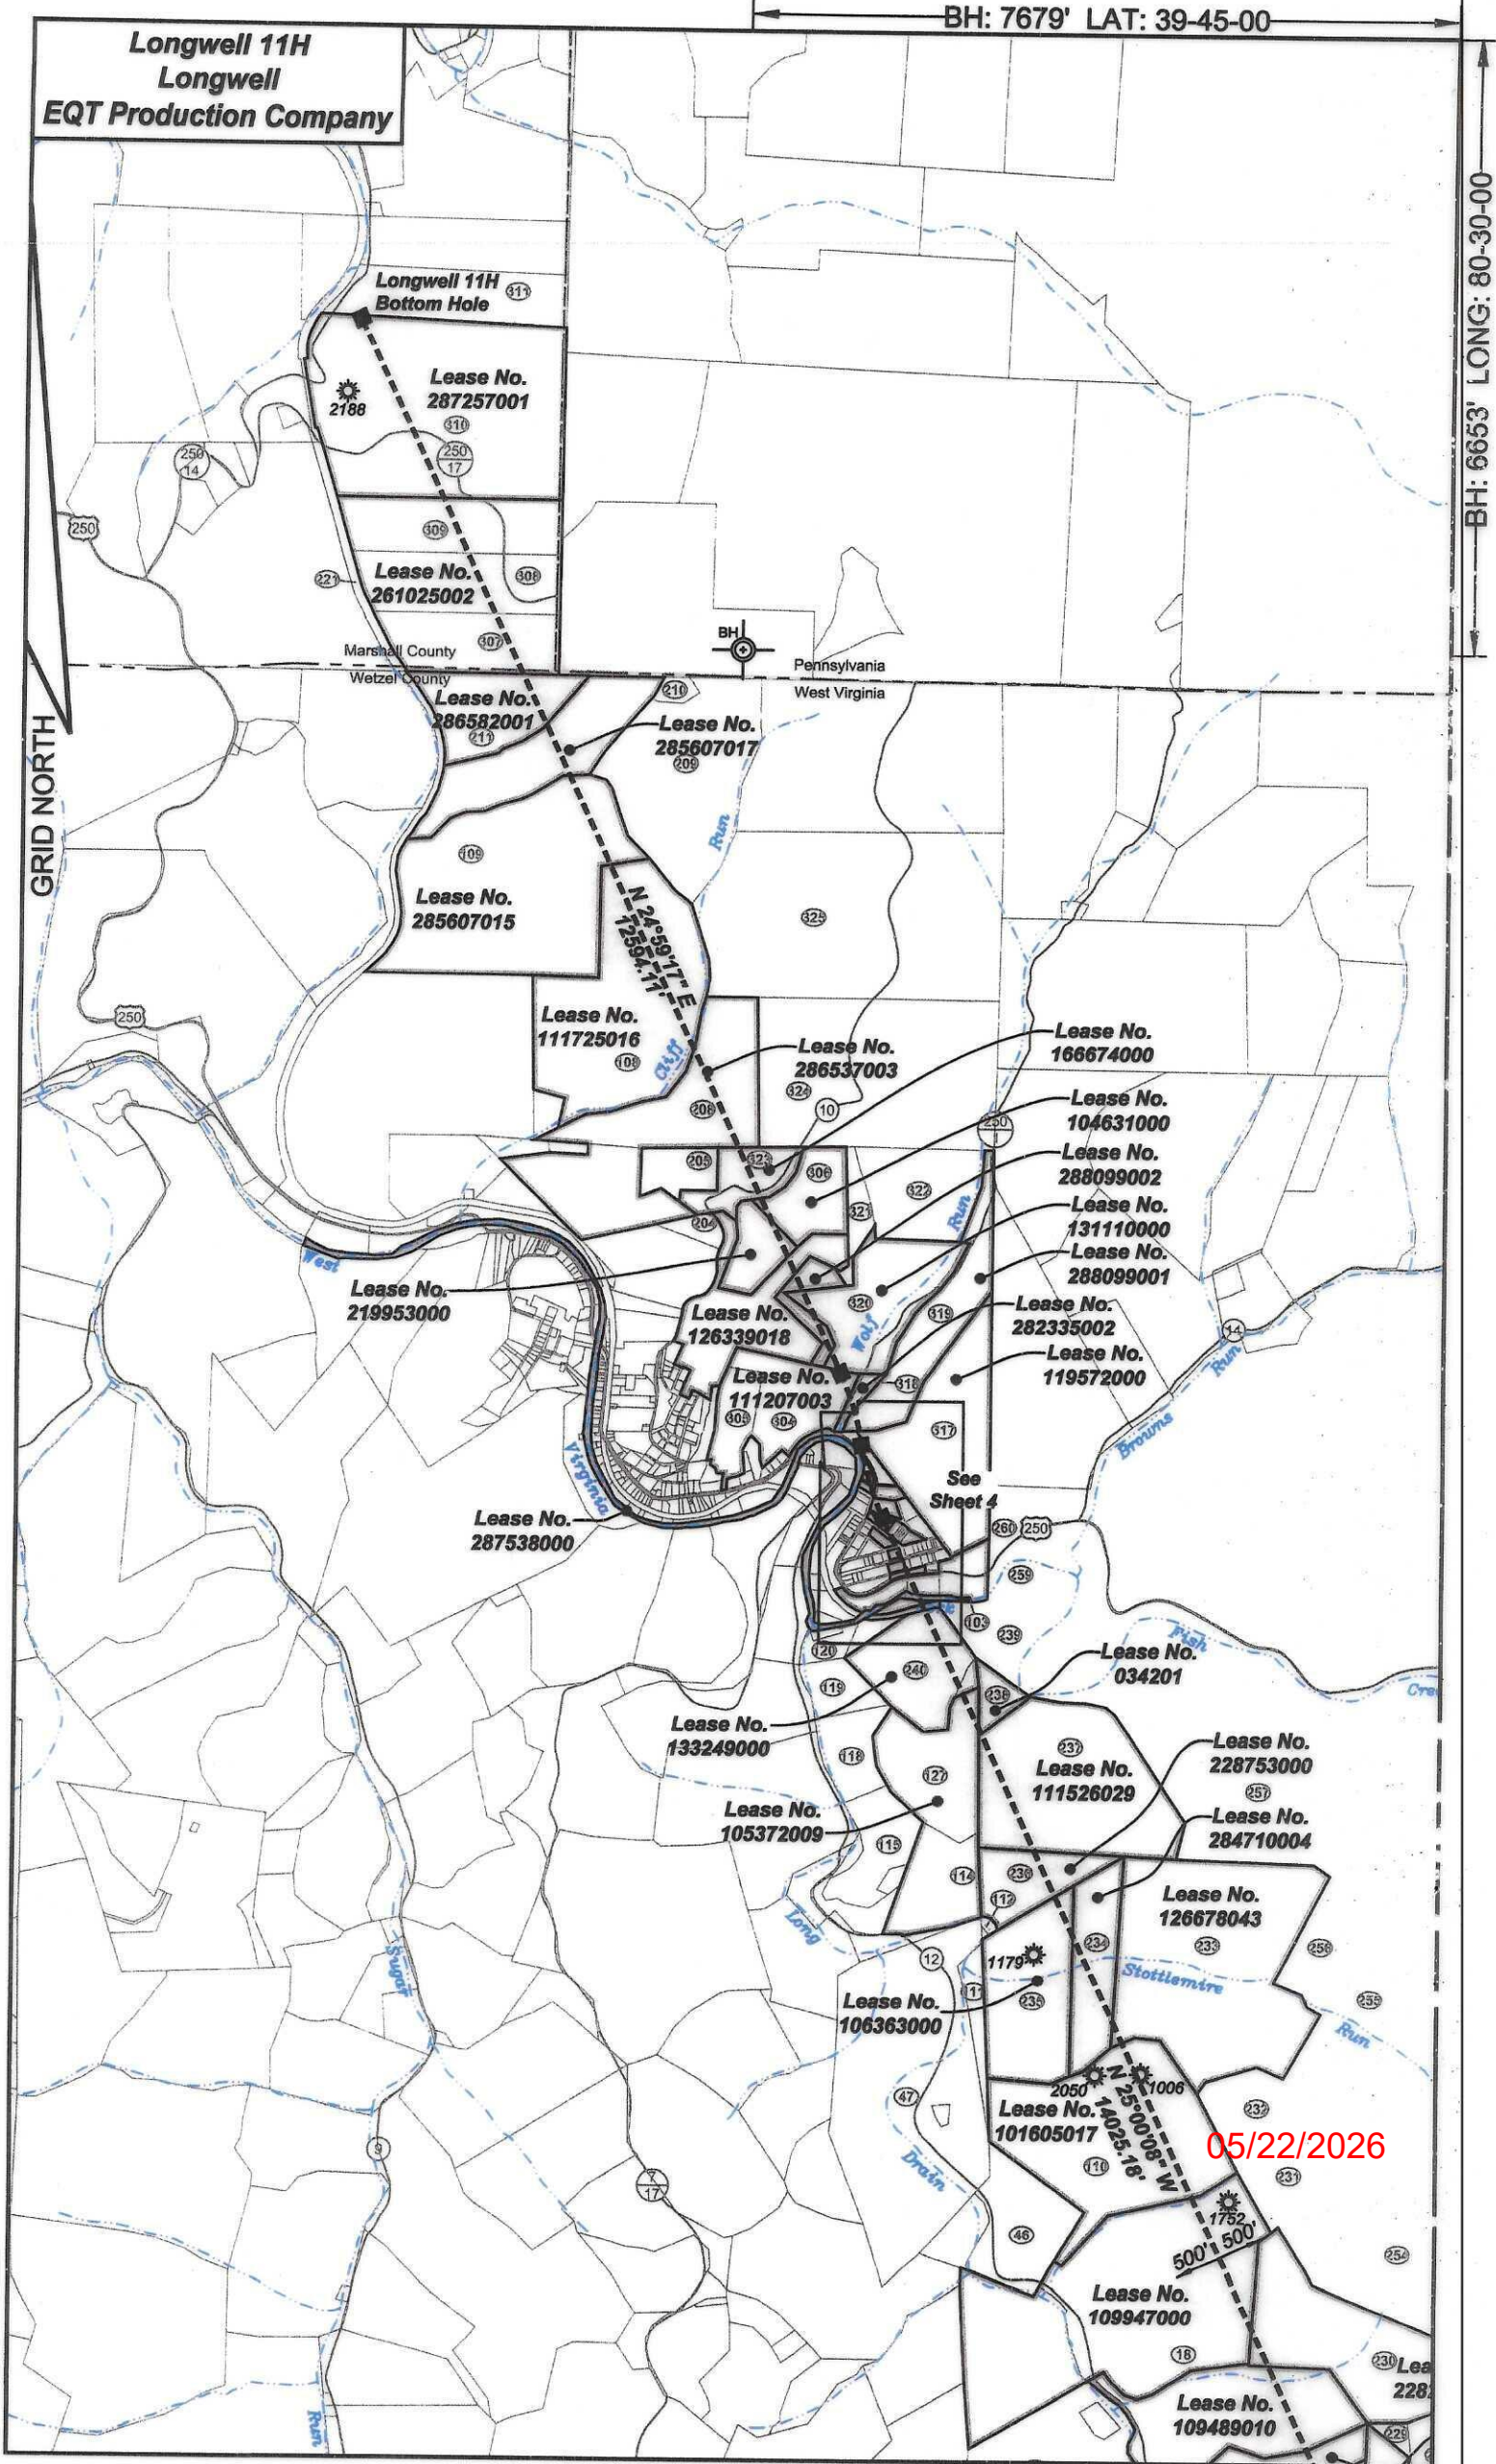

Longwell 11H
Longwell
EQT Production Company


CURVE	RADIUS	ARC LENGTH	CHORD BEARING	CHORD LENGTH
C1	2869.24'	827.78'	N 16°44'14" W	824.91'
C2	2824.93'	814.30'	S 16°43'49" E	811.48'

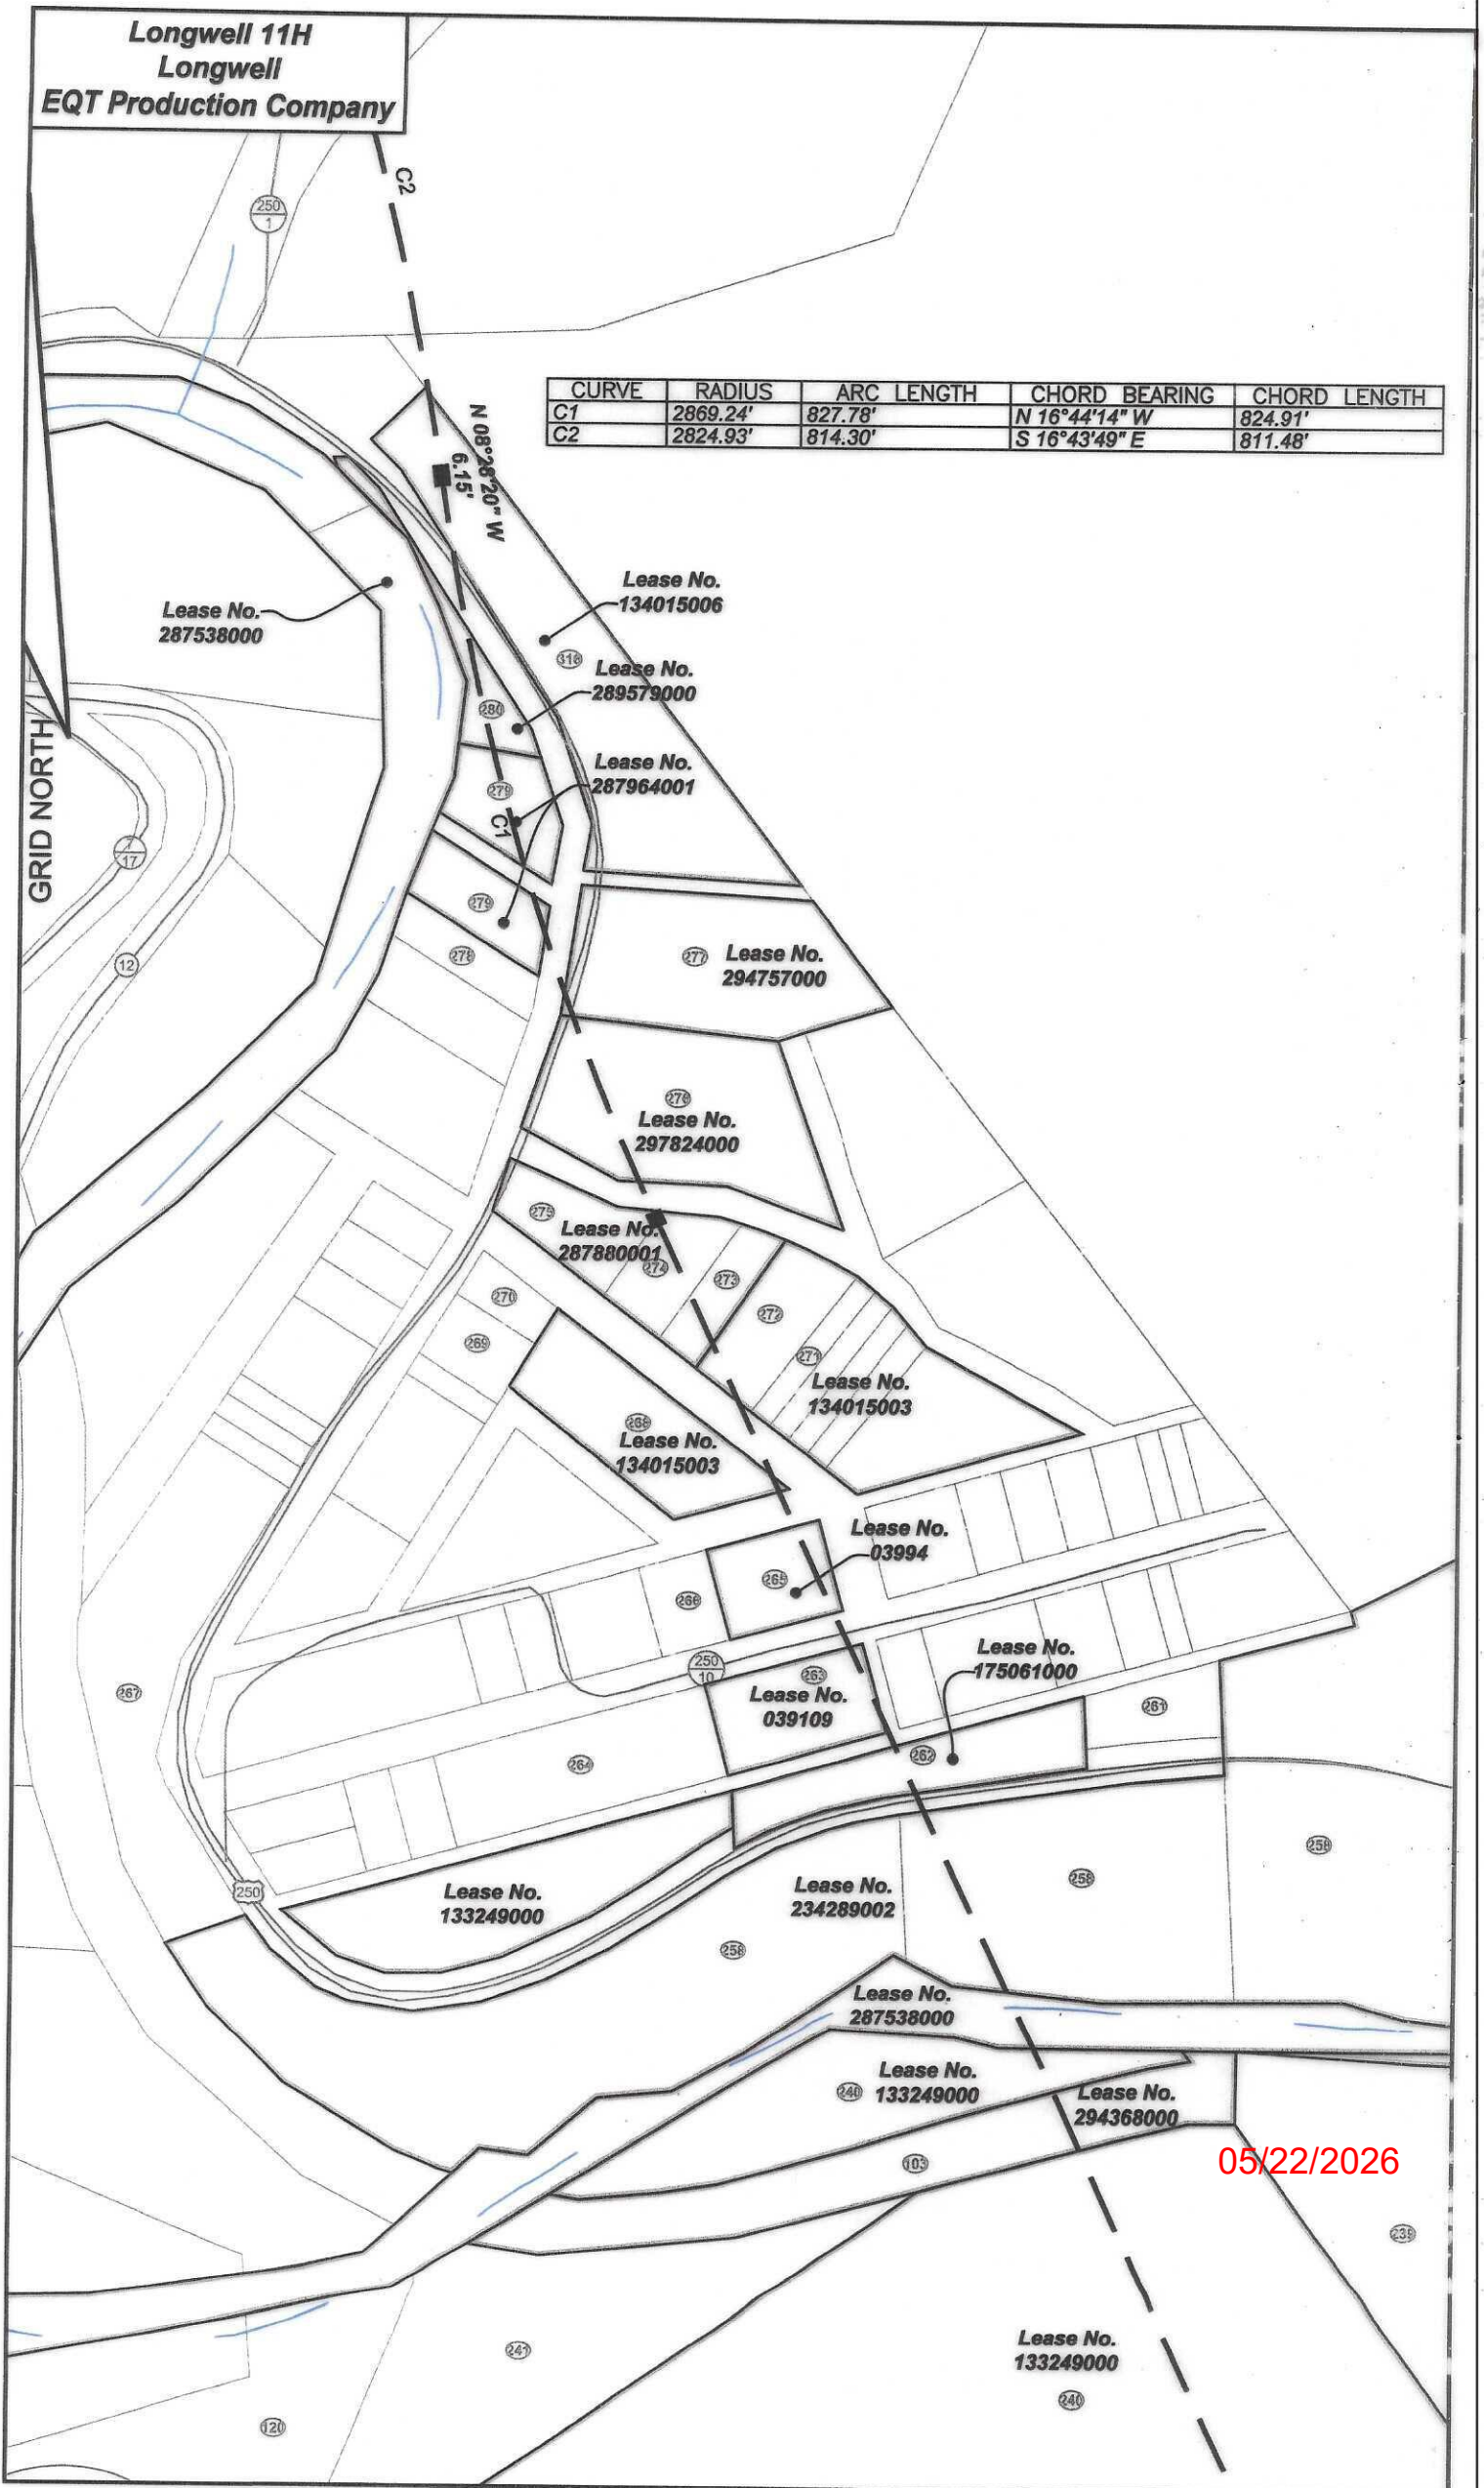

Longwell 11H
Longwell
EQT Production Company

Tract ID	Tract Map No.	Parcel No.	County	District	Surface Tract Owner	Acres
1	10	13	Wetzel	Church	Jeffery I. Longwell	106.5
2	10	14	Wetzel	Church	James I. Hanks & Penny I. Gale	0.5
3	10	4	Wetzel	Church	Edna J. L. McAdams	33.08
4	10	5	Wetzel	Church	Hance & Linda Garrison	61.5
5	8	20	Wetzel	Church	Larry V. Watson, et al.	17.88
6	10	15	Wetzel	Church	Charles I. Miller	90
7	10	23	Wetzel	Church	John R. Rice	33
8	10	22	Wetzel	Church	Roll Hill Chapel	1.8
9	10	21	Wetzel	Church	Charles L. Mathews	28
10	10	20	Wetzel	Church	Catherine Roberts, et al.	50
11	10	12	Wetzel	Church	Harriet L. Tustin	56.32
12	7	19	Wetzel	Clay	McLach Land LLC	73.211
13	6	23	Wetzel	Church	Bruce & Linda Garrison	124
14	6	25	Wetzel	Church	Larry V. Watson, et al.	40.83
15	6	24	Wetzel	Church	Shriver Cemetery	0.80
16	6	12	Wetzel	Church	Edward M. Baldauf, et al.	8.04
17	7	11	Wetzel	Clay	Edward M. Baldauf, et al.	20.5
18	7	8	Wetzel	Clay	Paul R. Curry, et al.	130
19	7	12	Wetzel	Clay	Wilks M. Church & Peggy Brown	208.85
20	10	25	Wetzel	Church	Allin K. Greathouse	23
21	10	18	Wetzel	Church	Nicholas I. & Joseph K. Fealham	27
22	10	7	Wetzel	Church	David R. Watson, et al.	6.5
23	10	6	Wetzel	Church	Nicholas L. & Joseph K. Eastham	48.39
24	6	26	Wetzel	Church	Thomas Chapel	1.4
25	10	8	Wetzel	Church	Gary Alan Cole	9.66
26	6	30.1	Wetzel	Church	Ashley W. & Jimmy L. Frye	4.36
27	6	30	Wetzel	Church	Leslie N. Williams	20.64
28	6	27.1	Wetzel	Church	Edward M. Baldauf, et al.	22.08
29	6	28.1	Wetzel	Church	Board of Education	10.81
30	6	27	Wetzel	Church	Larry V. Watson, et al.	2.54
31	6	13	Wetzel	Church	Edward M. Baldauf, et al.	2.8
32	6	14.1	Wetzel	Church	Edward M. Baldauf, et al.	1.24
33	6	15	Wetzel	Church	Edward M. Baldauf, et al.	28.5
34	7	7	Wetzel	Clay	William A. Myers II	29.8
35	4	48	Wetzel	Clay	Stephen T. Venter	115.3
36	2	63	Wetzel	Clay	CNX Land LLC	61.54
37	2	19	Wetzel	Clay	Donna D. Soles	101.4
38	2	6	Wetzel	Clay	Sarah F. Fitzgerald Estate, et al.	160
39	4	46	Wetzel	Clay	William Myers	77.7
40	4	42	Wetzel	Clay	Tim Williams	6
41	4	40	Wetzel	Clay	Ty Blake	0.6
42	4	38	Wetzel	Clay	L.N. Murphy	20.2
43	4	36	Wetzel	Clay	Dallison Lumber Inc.	11.6
44	4	24	Wetzel	Clay	Dallison Lumber Inc.	10.3
45	4	53	Wetzel	Clay	Maureen Mackey	7.85
46	4	53.1	Wetzel	Clay	Maureen Mackey	3.4
47	4	22	Wetzel	Clay	E.N. Murphy	33.5
48	2	36	Wetzel	Clay	Thomas I. McHugh, et al.	4
49	2	18	Wetzel	Clay	David Miller	13
50	2	7.1	Wetzel	Clay	Michael Wade	55
51	2	7	Wetzel	Clay	Donna Soles	68.5
52	2	7	Wetzel	Clay	Karen Soles	1.5
53	2	5	Wetzel	Clay	Thomas Billnovich	31.6
54	23	59	Marshall	Liberty	CNX Land LLC	124.8
55	6	16	Wetzel	Church	Edward M. Baldauf, et al.	4.7
56	6	7	Wetzel	Church	Dallison Lumber Inc.	65
57	7	9	Wetzel	Clay	James Jones Estate	16.3
58	4	45	Wetzel	Clay	James Jones Estate	28.3
59	4	43	Wetzel	Clay	Kathryn Simon	104
60	4	43.1	Wetzel	Clay	Kathryn Simon	31.58
61	4	41	Wetzel	Clay	Volena Kiger	37.33
62	4	21.1	Wetzel	Clay	Kathleen Mercer	45
63	4	21	Wetzel	Clay	Wilma Omduff	72.8
64	4	20.1	Wetzel	Clay	Wilma Omduff	4.5
65	4	20	Wetzel	Clay	Aaron Kolat	34.6
66	4	23	Wetzel	Clay	Richard Korman	30.4
67	1	54	Wetzel	Clay	Maureen Mackey	2
68	6	17	Wetzel	Church	Edward M. Baldauf, et al.	2.6
69	6	8	Wetzel	Church	Edward M. Baldauf, et al.	101.84
70	6	8	Wetzel	Church	Franklin Tennant, et al.	45
71	6	7	Wetzel	Church	Dallison Lumber Inc.	63
72	3	12	Wetzel	Clay	Kathryn Simon	45.7
73	4	44	Wetzel	Clay	Kathryn Simon	18.1
74	4	18	Wetzel	Clay	Ronald Kasserman	110
75	4	5	Wetzel	Clay	Cynthia Boyce	10
76	4	6	Wetzel	Clay	Wetzel County Board of Education	46.5
77	4	61	Wetzel	Clay	Richard H. Harts	6.5
78	9	106.1	Wetzel	Clay	Harry Wright	0.6
79	9	108.1	Wetzel	Clay	Linda Greathouse	1
80	9	109	Wetzel	Clay	Delmas Greathouse	0.517
81	9	110	Wetzel	Clay	Delmas Greathouse	0.888
82	9	94	Wetzel	Clay	Dean Miller	0.287
83	9	83	Wetzel	Clay	Dean Miller	0.172
84	9	20	Wetzel	Clay	Robert Long	1.27
85	9	78	Wetzel	Clay	Lloyd Henderson	0.621
86	9	72	Wetzel	Clay	Neil Longwell	0.172
87	9	71	Wetzel	Clay	Neil Longwell	0.682
88	9	63	Wetzel	Clay	Lloyd Henderson	0.107
89	9	64	Wetzel	Clay	Lloyd Henderson	0.31
90	9	66	Wetzel	Clay	Walter Longwell	0.181
91	9	68	Wetzel	Clay	Walter Longwell	0.26
92	9	68	Wetzel	Clay	Walter Longwell	0.323
93	9	69	Wetzel	Clay	Daniel Kennedy	1.55
94	9	48	Wetzel	Clay	Roy Dunn	0.82
95	9	0.1	Wetzel	Clay	Hundred Littleton F&D	0.235
96	9	6	Wetzel	Clay	Sherrilyn Greaver	0.6
97	9	5.1	Wetzel	Clay	Sally Anderson	0.18
98	9	14	Wetzel	Church	Larry Watson	0.18
99	2	38	Wetzel	Clay	Agnes King Est	28.7
100	31	6	Wetzel	Clay	Agnes King Est	13
101	2	30	Wetzel	Clay	James Murphy, et al.	65
102	23	15	Marshall	Liberty	Thomas J. Billnovich	32
103	23	14	Marshall	Liberty	Thomas J. Billnovich	32
104	23	13	Marshall	Liberty	Thomas J. Billnovich	32
105	23	12	Marshall	Liberty	Thomas F. Billnovich	130
106	23	11	Marshall	Liberty	Thomas F. Billnovich	30.6
107	9	38	Wetzel	Clay	Betty Paine	Lot
108	2	68.1	Wetzel	Clay	Cephus K. Seay	45.66
109	2	50	Wetzel	Clay	Alice Sapp	2.2
110	2	58	Wetzel	Clay	Norman L. Ashcraft	23.0
111	2	42	Wetzel	Clay	Norman L. Ashcraft	33
112	2	41	Wetzel	Clay	Norman L. Ashcraft	11.7
113	2	43	Wetzel	Clay	Donald Garrison	28.4
114	2	40	Wetzel	Clay	Donald H. Miller	13
115	2	17	Wetzel	Clay	Lois Calvert	100
116	2	9	Wetzel	Clay	Ralph Sole	68

Well References

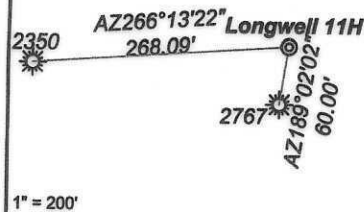

Notes:

Longwell 11H coordinates are
NAD 27 N: 422,867.95 E: 1,719,835.86
NAD 27 Lat: 39.656756 Long: -80.495093
NAD 83 UTM N: 4,389,792.81 E: 543,330.56
Longwell 11H Landing Point coordinates are
NAD 27 N: 424,578.65 E: 1,722,799.74
NAD 27 Lat: 39.661545 Long: -80.484833
NAD 83 UTM N: 4,390,329.37 E: 544,224.85
Longwell 11H Bottom Hole coordinates are
NAD 27 N: 450,278.99 E: 1,711,079.80
NAD 27 Lat: 39.731737 Long: -80.527304
NAD 83 UTM N: 4,398,099.33 E: 540,523.72
West Virginia Coordinate system of 1927 (North Zone),
based upon Differential GPS Measurements.
Plat orientation, corner and well ties are based upon
the grid north meridian.
Well location references are based upon the grid north
meridian.
UTM coordinates are NAD83, Zone 17, Meters.

Longwell

Longwell 11H

Longwell 9H

Longwell 7H

Longwell 5H

Longwell 1H

Longwell 3H

Lease No.	Owner	Acres
119078001	Jeffery Todd Longwell, et al.	106.5
124019000	Janice Cosgray, et al.	90
239080000	EQT TGH Exploration II LLC, et al.	85
114866007	Samuel Harlan Ellis, et al.	45.13
131627001	Nancy Dawn Cosgray, et al.	28.15
140111000	EQT TGH Exploration II, LLC, et al.	28.5 of 1962.7875
126678160	Stone Hill Mineral Holdings, LLC, et al.	194
106953001	Nancy Dawn Cosgray, et al.	20.5 of 49
109489010	Paul R. Curry, et ux., et al.	170
228280000	Richardson Rhodes Trust dated April 10, 2019	63
109947000	Peggy Church Brown, et al.	31.307949 of 140
101605017	Linda Jo Wood Smith, et al.	80
126678043	Three Rivers Royalty II, LLC, et al.	133.04 of 1734.20
284710004	Betty M. Prine, et al.	31.58
106363000	Janet E. Love, et al.	37.5
228753000	Merle Oates, et al.	50
111528029	Elkhorn Mineral Fund, LP, et al.	72.78
034201	Wilma L. Omduff, et al.	4.5
105372009	AMP IV, LP, et al.	53.70
133249000	Elk Range Royalties II, LP, et al.	32.5875
294368000	CNX Gas Company, LLC	61.94
287538000	West Virginia Division of Natural Resources	18.51444 of 38.187
234289002	Three Rivers Royalty II LLC, et al.	260.25
175061000	OXY USA, Inc., et al.	1 of 31151.581
039109	Delmas Greathouse, Jr, et al.	0.517
03994	Dean W. Miller, et al.	0.29
134015003	Lloyd F. Henderson, et al.	2.60067
287880001	Essie Rosalee Longwell, et al.	0.77
297824001	Sunshine State Investment Group LLC, et al.	1.55
294757000	Cody M. Jones	2.11
287964001	Raymond E. Greaver, et al.	0.81
289579000	Stephen Douglas Hayes	0.157
134015006	Betty Maxine Prine	10.11041
119572000	Kevin Goff, et al.	46
288099001	John W. Kerns Heirs Trust, et al.	23.80 of 35.50
282335002	Minnie Alice Sapp, et al.	2.20
111207003	Patsy Ann Carlson, et al.	39.90
131110000	Norman E. Ashcraft	33
288099002	Wilma Marie Morris, et al.	11.70
126339018	Wilma Marie Morris, et al.	109.80
219953000	Stone Hill Minerals Holdings, LLC, et al.	21.50 of 811.96
104631000	Betty Maxine Prine	41.50
186674000	AMP Fund III, LP	13
286537003	Foss Minerals, LLC, et al.	81.70
111725016	Standard Land Company, LLC, et al.	101.1375
285607015	The Habitat for Humanity, et al.	160
285607017	George Doyle Self, et al.	160
286582001	Thomas F. Billnovich 2017 Trust, et al.	31.50
261025002	Chestnut Holdings, Inc., et al.	96
287257001	Highlands Royalty Fund LLC, et al.	130

05/22/2026

