

3301476P

WW-7
5-02



West Virginia Department of Environmental Protection
Office of Oil and Gas
WELL LOCATION FORM: GPS

Received
Office of Oil & Gas
MAR 25 2015

API: 47-033-01476 WELL NO.: 7411
FARM NAME: REYNOLDS - GORE
RESPONSIBLE PARTY NAME: CNX GAS COMPANY LLC
COUNTY: HARRISON DISTRICT: COAL
QUADRANGLE: CLARKSBURG
SURFACE OWNER: GARY BATES, ET. AL.
ROYALTY OWNER: RICHARD C. ROCKENSTEIN
UTM GPS NORTHING: 4,352,291.13 METERS
UTM GPS EASTING: 554,545.25 METERS GPS ELEVATION: 356.54 METERS (1169')

The Responsible Party named above has chosen to submit GPS coordinates in lieu of preparing a new well location plat for a plugging permit on the above well. The Office of Oil and Gas will not accept GPS coordinates that do not meet the following requirements:

1. Datum: NAD 1983, Zone: 17 Coordinate Units: meters Altitude: Height above mean sea level (MSL) - meters
2. Accuracy to Datum - 3.05 meters
3. Data Collection Method: Survey Grade GPS : Post Processed Differential Real-Time Differential
Mapping Grade GPS : Post Processed Differential Real-Time Differential


I the undersigned hereby state this data is correct to the best of my knowledge and belief and shows all the information required by law and the regulation issued and prescribed by the Office of Oil and Gas.

Signature 
Stephen D. Losh, PS #674

Title WV Professional Surveyor #674


Date 11/13/14

Received
Office of Oil & Gas
MAR 11 2015

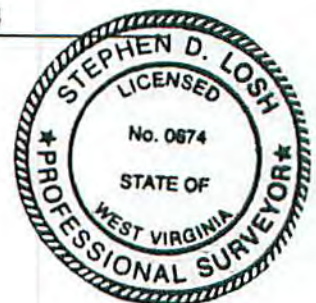

CNX USE: NAD 27 WV NORTH SPC: 7411 = 299,196.03' 1,754,586.25' ELEV. = 1169.74'

3301476P

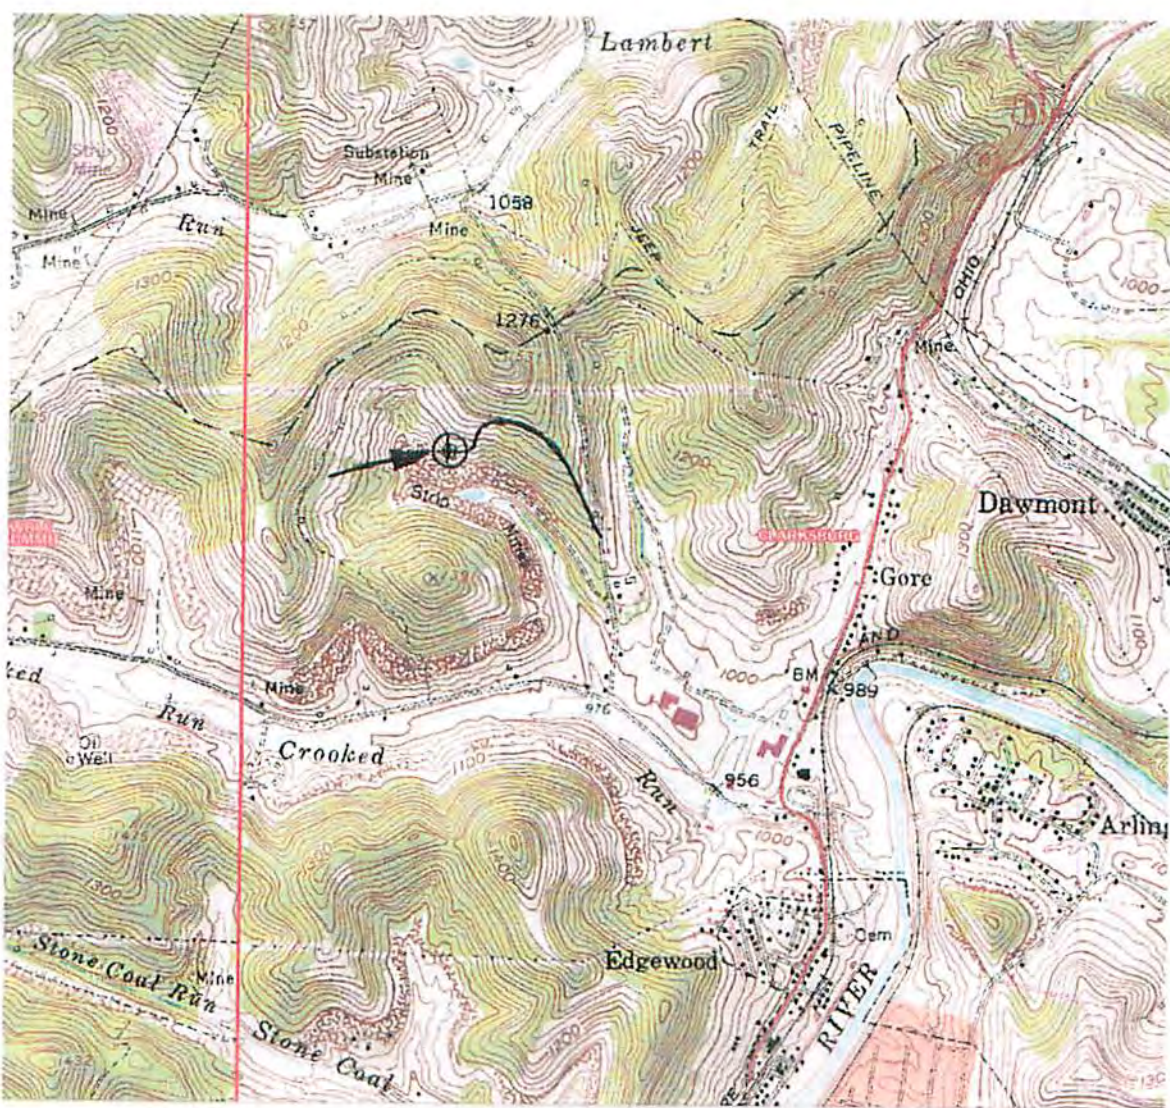

SDW
319/15

Received
Office of Oil & Gas
MAR 25 2015

Received
Office of Oil & Gas
MAR 11 2015

LAND SURVEYING SERVICES
21 CEDAR LANE
BRIDGEPORT, WV 26330
PHONE: 304-842-2018 OR 5762

DRAWINGS TO ACCOMPANY FORM WW-9	
CNX GAS COMPANY LLC	
P. O. BOX 1248	
JANE LEW, WV 26378	
WATERSHED:	CROOKED RUN
DISTRICT: COAL	COUNTY: HARRISON
QUADRANGLE: CLARKSBURG	WELL NO.: 7411
DATE: 11/13/14	PAGE ___ of ___