

WW-7
8-30-06

RECEIVED
Office of Oil and Gas

JAN 06 2021

WV Department of
Environmental Protection



West Virginia Department of Environmental Protection
Office of Oil and Gas
WELL LOCATION FORM: GPS

API: 47-033-01636 WELL NO.: WV 650331 (Robinson #140)

FARM NAME: Dally D. Robinson

RESPONSIBLE PARTY NAME: EQT Production Company

COUNTY: Harrison DISTRICT: Eagle

QUADRANGLE: Wallace 7.5'

SURFACE OWNER: Consolidation Coal Company

ROYALTY OWNER: Murray Energy Corporation

UTM GPS NORTHING: ⁴³⁶⁵⁹⁸4365947

UTM GPS EASTING: ⁵⁵⁰⁹⁷²560551 GPS ELEVATION: 396m (1299ft)

The Responsible Party named above has chosen to submit GPS coordinates in lieu of preparing a new well location plat for a plugging permit or assigned API number on the above well. The Office of Oil and Gas will not accept GPS coordinates that do not meet the following requirements:

1. Datum: NAD 1983, Zone: 17 North, Coordinate Units: meters, Altitude: height above mean sea level (MSL) – meters.
2. Accuracy to Datum – 3.05 meters
3. Data Collection Method:
Survey grade GPS _____ : Post Processed Differential _____
Real-Time Differential _____
Mapping Grade GPS X : Post Processed Differential X
Real-Time Differential _____

4. **Letter size copy of the topography map showing the well location.**

I the undersigned, hereby certify this data is correct to the best of my knowledge and belief and shows all the information required by law and the regulations issued and prescribed by the Office of Oil and Gas.


Signature

PS# 2100
Title

12/11/2020
Date

Topo Quad: Wallace 7.5'

Scale: 1" = 2000'

4703301636P

County: Harrison


Date: December 10, 2020

District: Eagle

Project No: 70-36-00-08

47-033-01636 WV 650331 (Robinson #140)

Topo

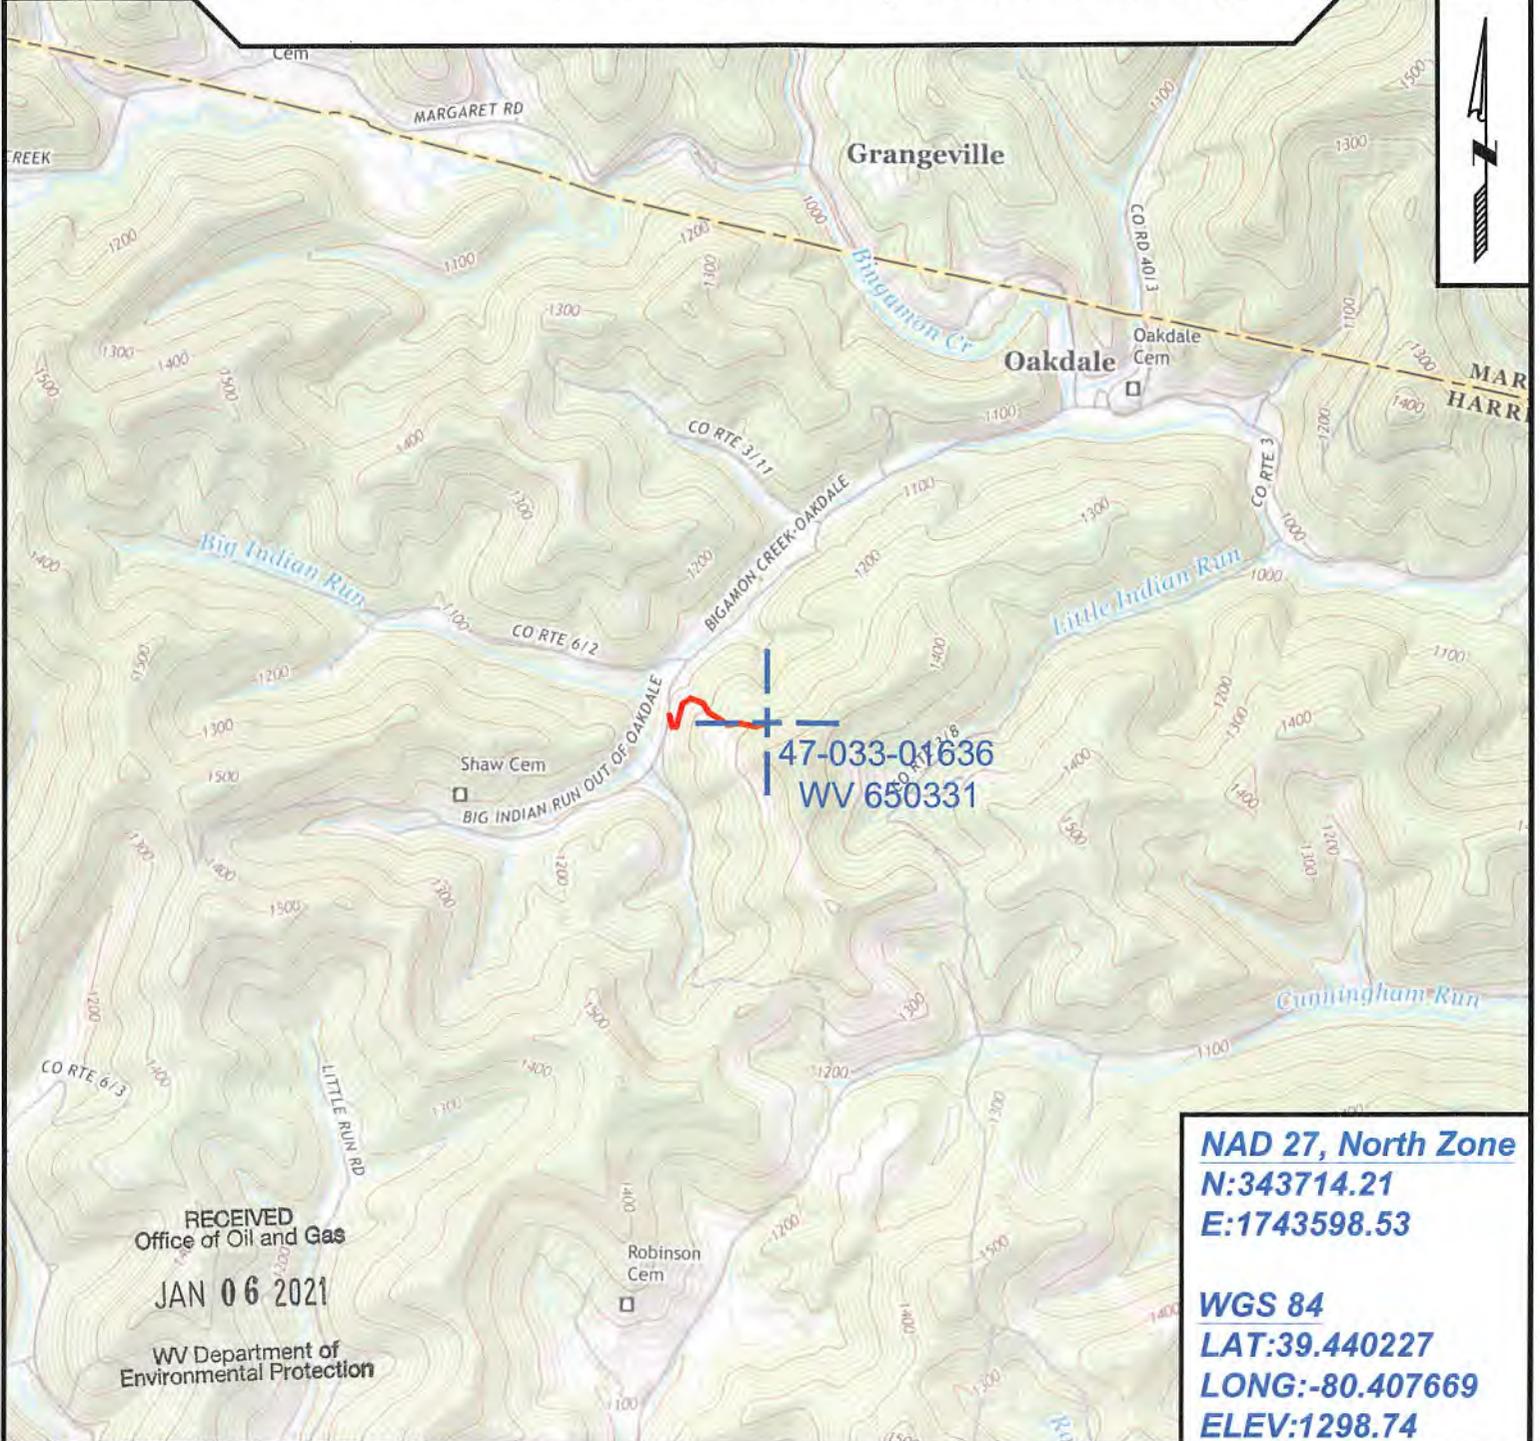

RECEIVED
Office of Oil and Gas

JAN 06 2021

WV Department of
Environmental Protection

NAD 27, North Zone
N:343714.21
E:1743598.53

WGS 84
LAT:39.440227
LONG:-80.407669
ELEV:1298.74



SURVEYING AND MAPPING SERVICES PERFORMED BY:
ALLEGHENY SURVEYS, INC.

1-800-482-8606
237 Birch River Road
Birch River, WV 26610
PH: (304) 649-8606
FAX: (304) 649-8608

PREPARED FOR:

EQT Production Company

400 Woodcliff Drive
Canonsburg, PA 15317

04/02/2021