

WW-7  
8-30-06



West Virginia Department of Environmental Protection  
Office of Oil and Gas

**WELL LOCATION FORM: GPS**

API: 47-033-02195 WELL NO.: Lowe 1 S-10

FARM NAME: Lowe, Henry C.

RESPONSIBLE PARTY NAME: XTO Energy, Inc.

COUNTY: Harrison DISTRICT: Eagle

QUADRANGLE: Wallace

SURFACE OWNER: Consolidation Coal Company

ROYALTY OWNER: See Attached

UTM GPS NORTHING: 4365811.58

UTM GPS EASTING: 546878.41 GPS ELEVATION: 419.98 / 1378'

The Responsible Party named above has chosen to submit GPS coordinates in lieu of preparing a new well location plat for a plugging permit or assigned API number on the above well. The Office of Oil and Gas will not accept GPS coordinates that do not meet the following requirements:

1. Datum: NAD 1983, Zone: 17 North, Coordinate Units: meters, Altitude: height above mean sea level (MSL) – meters.
2. Accuracy to Datum – 3.05 meters
3. Data Collection Method:  
Survey grade GPS \_\_\_\_ : Post Processed Differential \_\_\_\_

Real-Time Differential \_\_\_\_

Mapping Grade GPS  : Post Processed Differential

Real-Time Differential \_\_\_\_


4. **Letter size copy of the topography map showing the well location.**

I the undersigned, hereby certify this data is correct to the best of my knowledge and belief and shows all the information required by law and the regulations issued and prescribed by the Office of Oil and Gas.

*Tim Lamb* Regulatory Coordinator 6/14/18  
Signature Title Date

08/17/2018

RECEIVED  
Office of Oil and Gas  
JUL 23 2018  
WV Department of  
Environmental Protection

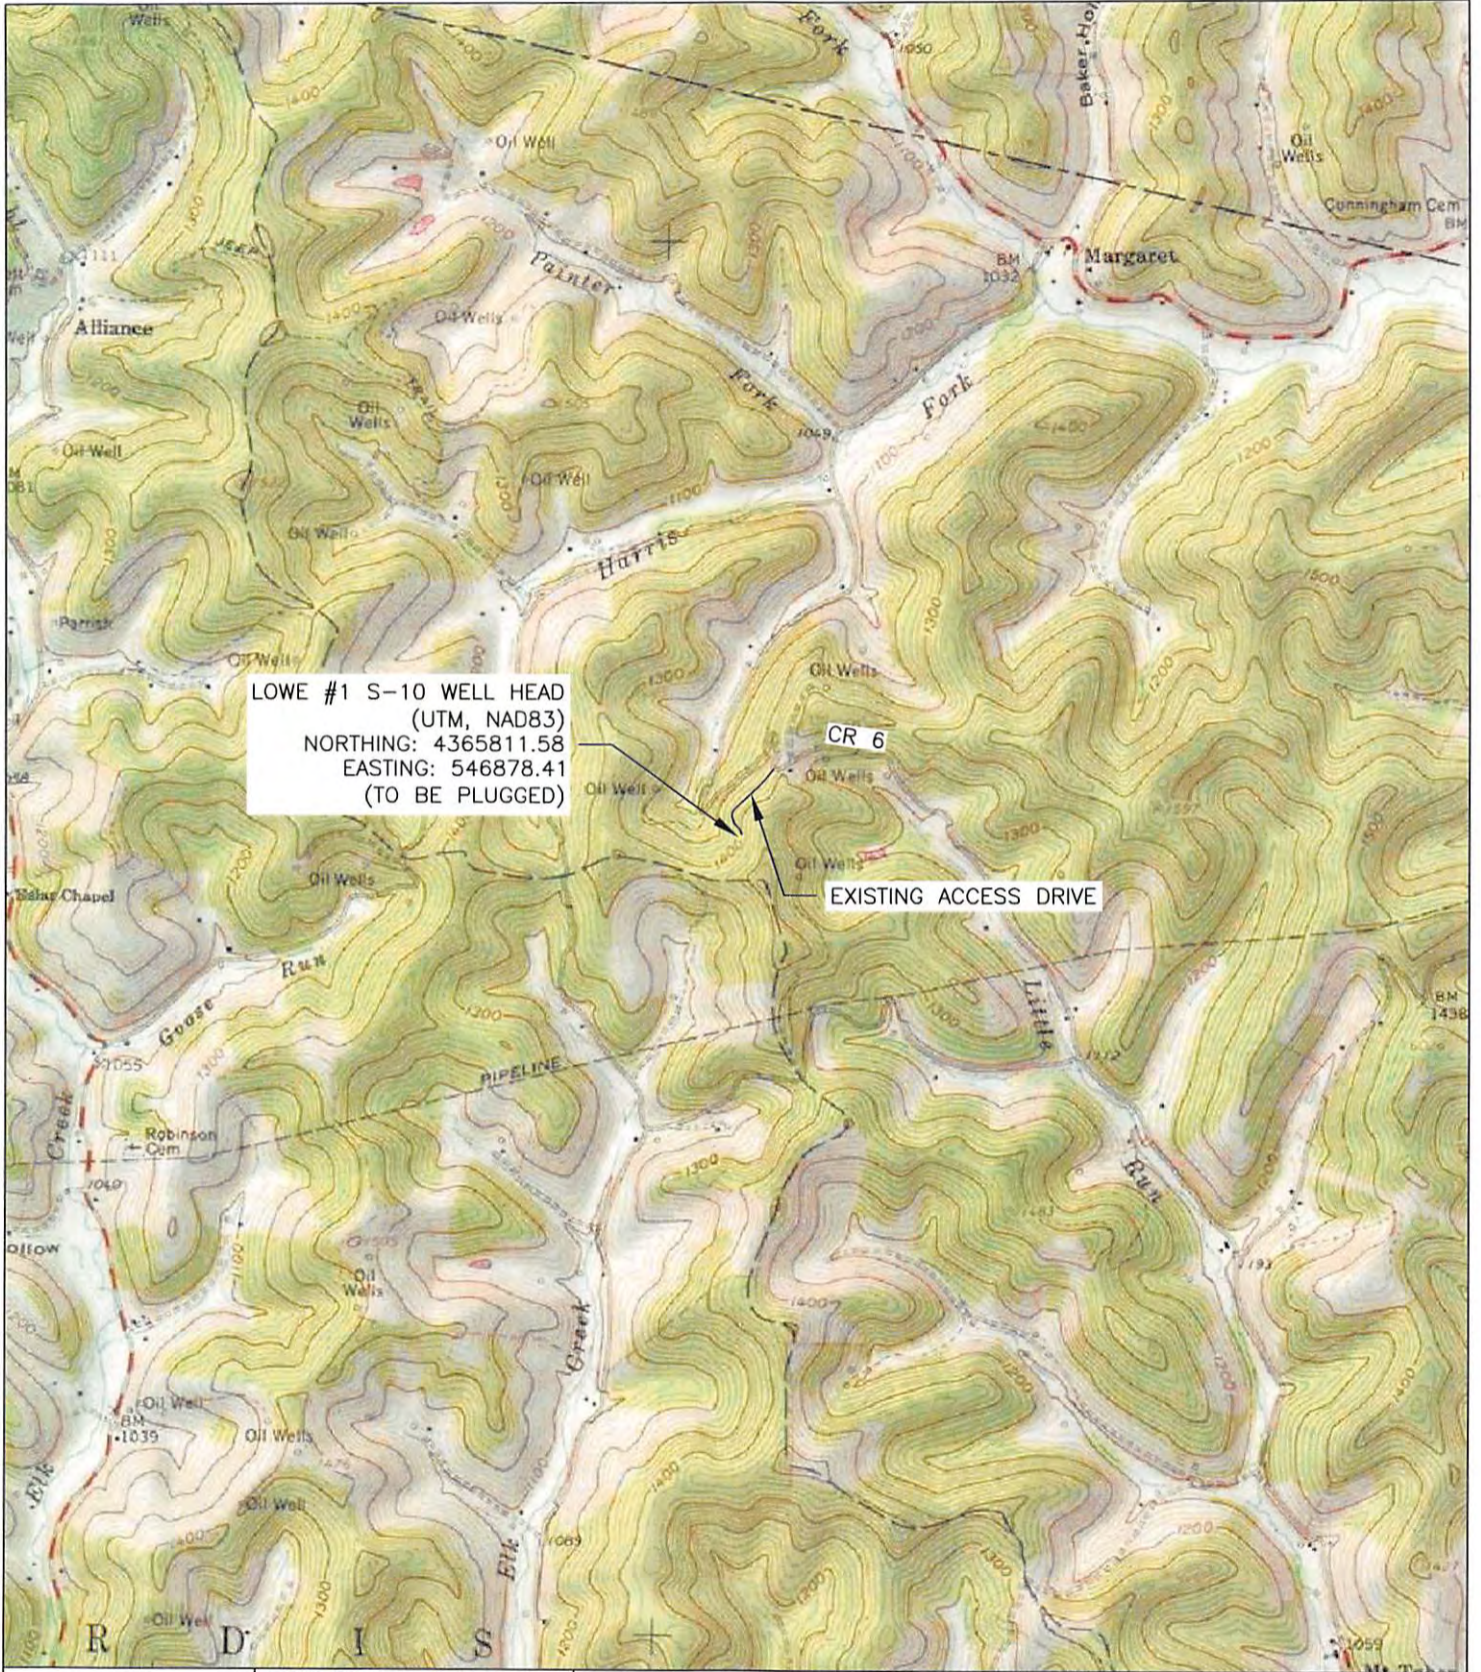

LOWE #1 S-10 WELL HEAD  
 (UTM, NAD83)  
 NORTHING: 4365811.58  
 EASTING: 546878.41  
 (TO BE PLUGGED)

EXISTING ACCESS DRIVE

SCALES HORIZ: 1"=2000' VERT: CONTOUR INT: 20'	DESN BY: SDG	REV. BY: _____ DATE: _____ DESC.: _____
	DRWN BY: SDG	REV. BY: _____ DATE: _____ DESC.: _____
	RVWD BY: MMV	REV. BY: _____ DATE: _____ DESC.: _____
	FLD BK: _____	REV. BY: _____ DATE: _____ DESC.: _____
	BK PG: _____ DATE: 06/12/18	REV. BY: _____ DATE: _____ DESC.: _____

SHEET NUMBER:  
 1 OF 1

USGS MAP - WALLACE QUADRANGLE  
**LOWE #1 S-10**  
 FOR: XTO ENERGY, INC.  
 CR 6, HARRISON COUNTY, WEST VIRGINIA

**MORRIS KNOWLES & ASSOCIATES, INC.**  
 A HAMMONTREE COMPANY  
 ENGINEERS, PLANNERS, SURVEYORS  
 443 ATHENA DRIVE DELMONT, PA 15626  
 PHN: (724) 468-4623 FAX: (724) 468-8910  
 www.morris-k.com

RECEIVED  
 Office of Oil and Gas  
**JUL 23 2018**  
 WV Department of  
 Environmental Protection