


HG Energy II Appalachia, LLC
Well No. Neel 1207 S-9H
As-Drilled
 Page 1 of 4

Notes:
 Well No. Neel 1207 S-9H
 UTM NAD 1983 (USSF)
 Top Hole Coordinates
 N: 14,218,312.78'
 E: 1,809,818.86'
 Landing Point Coordinates
 N: 14,218,099.54'
 E: 1,809,103.61'
 Bottom Hole Coordinates
 N: 14,204,716.72'
 E: 1,814,032.16'

Legend

- ⊙ Proposed gas well
- ⊕ Well Reference, as noted
- ⊗ Monument, as noted
- ☀ Existing Well, as noted
- ☀ Existing Plugged Well, as noted
- ☀ Digitized Well, as noted
- Creek or Drain
- Existing Road
- Surface boundary (approx.)
- Interior surface tracts (approx.)

Notes: Well No. Neel 1207 S-9H
 West Virginia Coordinate System of 1927, North Zone
 based upon Differential GPS Measurements.
 Top Hole coordinates Bottom Hole coordinates
 Latitude: 39°09'04.79" Latitude: 39°06'50.08"
 Longitude: 80°24'09.44" Longitude: 80°23'17.11"
 UTM Zone 17, NAD 1983
 Top Hole Coordinates Bottom Hole Coordinates
 N: 4,333,750.403m N: 4,329,606.315m
 E: 551,633.892m E: 552,918.108m
 Plat orientation and corner and well references are
 based upon the grid north meridian. Well location
 references are based upon the magnetic meridian.

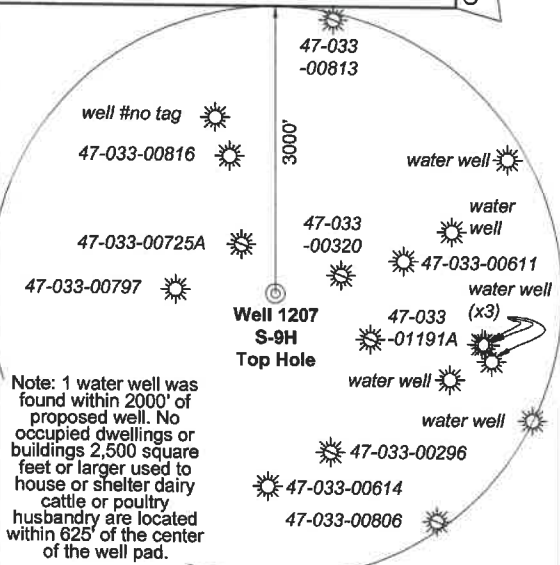


Tag	Bearing	Dist.
L1	S 02°20' E	1,495.9'
L2	S 16°59' W	1,590.1'
L3	S 75°04' W	2,159.2'
L4	N 73°58' W	989.6'

7,831' to Top Hole

3,712' to Bottom Hole

TOP LATITUDE 39 - 10 - 00
 BTM LATITUDE 39 - 07 - 30

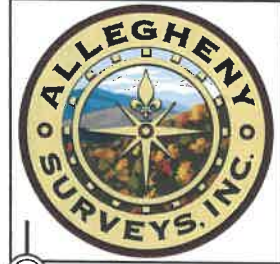

LONGITUDE 80 - 22 - 30
 4,038' to Bottom Hole
 5,584' to Top Hole

Bottom Hole
 7.5' Spot



I, the undersigned, hereby certify that this plat is correct to the best of my knowledge and belief and shows all the information required by law and the rules issued and prescribed by the Department of Environmental Protection.

Dwayne D. Matheny
 Dwayne D. Matheny, P.S. 2070

FILE NO: 296-36-G-18
 DRAWING NO: Neel 1207 S-9H ASWP
 SCALE: 1" = 2000'
 MINIMUM DEGREE OF ACCURACY: Submeter
 PROVEN SOURCE OF ELEVATION: CORS, Bridgeport, WV

STATE OF WEST VIRGINIA
 DEPARTMENT OF ENVIRONMENTAL PROTECTION
OIL AND GAS DIVISION

DATE: April 7 2021
 OPERATOR'S WELL NO. Neel 1207 S-9H
 API WELL NO
 47 - 033 - 05974
 STATE COUNTY PERMIT

WELL TYPE: OIL GAS LIQUID INJECTION WASTE DISPOSAL
 (IF GAS) PRODUCTION: STORAGE DEEP SHALLOW

LOCATION: ELEVATION: 1,344' WATERSHED: Middle West Fork Creek
 DISTRICT: Grant
 SURFACE OWNER: HG Energy II Appalachia, LLC
 ROYALTY OWNER: Dora B. McWhorter, et al LEASE NO: ACREAGE: 103.00


PROPOSED WORK: DRILL CONVERT DRILL DEEPER FRACTURE OR STIMULATE PLUG OFF OLD FORMATION
 PERFORATE NEW FORMATION OTHER PHYSICAL CHANGE IN WELL (SPECIFY) LP & BH MOD
 PLUG AND ABANDON CLEAN OUT AND REPLUG TARGET FORMATION: Marcellus Shale ESTIMATED DEPTH: 21,669' MD

WELL OPERATOR: HG Energy II Appalachia, LLC DESIGNATED AGENT: Diane C. White
 ADDRESS: 5260 Dupont Road ADDRESS: 5260 Dupont Road
 Parkersburg, WV 26101 Parkersburg, WV 26101

09/16/2022




Detail 1 (Scale 1"=500')

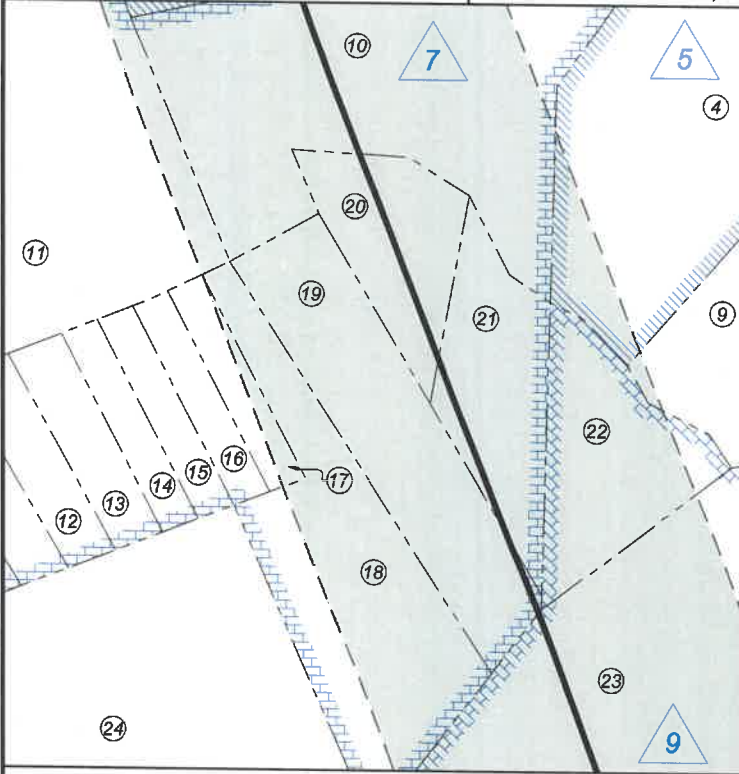

ID	Lease
2	A.J. Smith, et ux
3	Dora B. McWhorter, et al
5	Union National Bank Trustee of Gore Morris
7	John T. Freeman
8	Walter Neely, et al
9	William H. & Fannie M. Homer
22	Nathan G. & Dora E. McWhorter
25	Nathan McWhorter, et al
32	James W. Rogers, et al
33	Hugh Davis
38	Hugh Davis
41	Myrtle Edmonds, et al
45	A.L. Waggoner, et al

Detail 2 (Scale 1"=500')

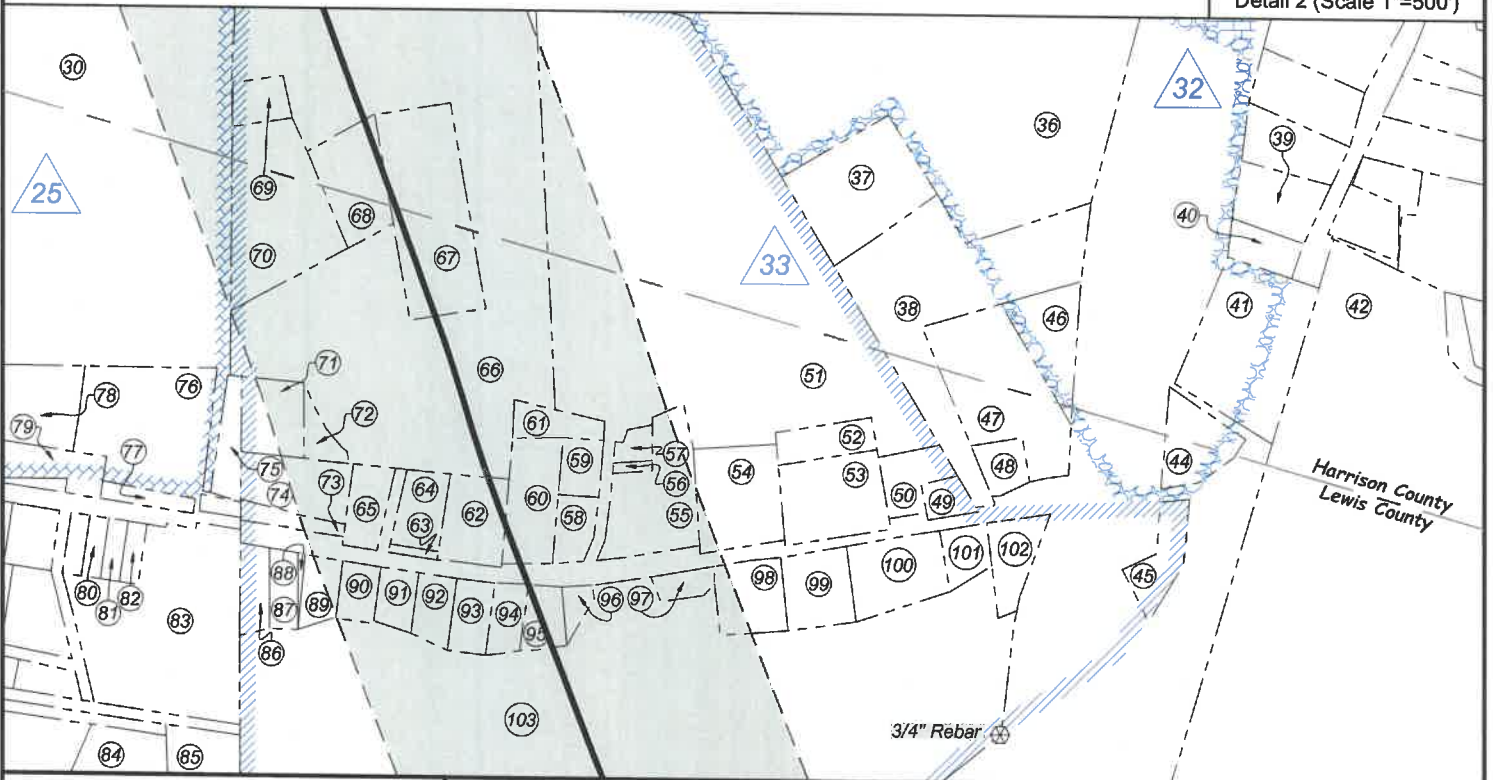

FILE NO: 296-36-G-18
DRAWING NO: Neel 1207 S-9H ASWP
SCALE: 1" = 2000'
MINIMUM DEGREE OF ACCURACY:
Submeter
PROVEN SOURCE OF ELEVATION:
CORS, Bridgeport, WV

STATE OF WEST VIRGINIA
DEPARTMENT OF ENVIRONMENTAL PROTECTION
OIL AND GAS DIVISION

DATE: April 7 2021
OPERATOR'S WELL NO. Neel 1207 S-9H
API WELL NO
47 - 033 - 05974
STATE COUNTY PERMIT

WELL TYPE: OIL GAS LIQUID INJECTION WASTE DISPOSAL
(IF GAS) PRODUCTION: STORAGE DEEP SHALLOW

LOCATION: ELEVATION: 1,344' WATERSHED: Middle West Fork Creek
DISTRICT: Grant

Top: West Milford
QUADRANGLE: Btm: Weston
COUNTY: Harrison
ACREAGE: 103.07

SURFACE OWNER: HG Energy II Appalachia, LLC
ROYALTY OWNER: Dora B. McWhorter, et al

LEASE NO: _____ ACREAGE: 103.00

PROPOSED WORK: DRILL CONVERT DRILL DEEPER FRACTURE OR STIMULATE PLUG OFF OLD FORMATION
 PERFORATE NEW FORMATION OTHER PHYSICAL CHANGE IN WELL (SPECIFY) LP & BH MOD

PLUG AND ABANDON CLEAN OUT AND REPLUG TARGET FORMATION: Marcellus Shale ESTIMATED DEPTH: 21,689' MD

WELL OPERATOR: HG Energy II Appalachia, LLC
ADDRESS: 5260 Dupont Road
Parkersburg, WV 26101

DESIGNATED AGENT: Diane C. White
ADDRESS: 5260 Dupont Road
Parkersburg, WV 26101




Harrison Co. - Grant Dist.

No.	TM / Par	Owner	Bk / Pg	Ac.
1	445 / 5	HG Energy II Appalachia, LLC	--- / ---	89.07
2	445 / 3	Lisa M. Nutter	W188 / 687	64.00
3	445 / 12	Lisa M. Nutter	W188 / 687	64.50
4	445 / 13	Mickey Petitto	W175 / 1167	132.85
5	445 / 13.1	Martha E. Lambert	--- / ---	26.77
6	445 / 14	Martha E. Lambert	1276 / 582	2.61
7	445 / 15.1	Martha E. Lambert	1276 / 582	35.00
8	445 / 15	Margaret S. Fisher	1276 / 576	49.69
9	445 / 28	Margaret S. Fisher	1200 / 626	28.75
10	445 / 26	Leland Freeman	W188 / 329	15.25
11	445 / 25	Leland Jackson Freeman	W167 / 371	21.00
12	445 / 35.1	Robert Freeman	1510 / 178	1.85
13	445 / 35	Robert Freeman	1266 / 521	3.82
14	445 / 36	Leland Jackson Freeman	W167 / 371	1.34
15	445 / 37	Leland Jackson Freeman	W167 / 371	1.34
16	445 / 38	Leland Jackson Freeman	W167 / 371	1.34
17	445 / 39	Leland Jackson Freeman	W167 / 371	1.34
18	445 / 40	Leland Jackson Freeman	W167 / 371	8.20
19	445 / 41	Charles Sutton	--- / ---	7.40
20	445 / 42	Ivy Myrle Freeman	W56 / 47	4.80
21	445 / 42.1	Charles R. Sutton	--- / ---	3.00
22	445 / 43	Charles R. & Franklin L. Sutton	1623 / 1057	4.65

Harrison Co. - Grant Dist.

No.	TM / Par	Owner	Bk / Pg	Ac.
23	445 / 47	Charles R. & Franklin L. Sutton	1623 / 1057	78.00
24	445 / 46	James W. Riffle II, et al	1385 / 259	140.43
25	445 / 15	Margaret S. Fisher	1276 / 576	49.69
26	446 / 30	Charles R. Sutton	1535 / 207	29.00
27	446 / 31	Richard L. Hawkins, Jr.	1569 / 982	58.96
28	465 / 10	Catherine D. Weber	1495 / 458	81.50
29	465 / 4.1	J. Gregory & Rebecca Moore	1421 / 350	353.80
30	465 / 1	Catherine D. Weber	1495 / 458	103.72
31	466 / 5	Mary Reel	1244 / 948	75.48
32	466 / 4	Mary Reel	1244 / 948	10.90
33	466 / 2	Worthey E. & Connie S. Poe	1240 / 388	16.70
34	466 / 1	Worthey E. & Connie S. Poe	1240 / 388	25.16
35	466 / 20	Worthey E. & Connie S. Poe	1240 / 388	49.24
36	466 / 39.1	Worthey E. & Connie S. Poe	1240 / 388	28.88
37	466 / 57.1	Martha L. Davis	W168 / 435	1.91
38	466 / 57.2	Vicki & Michael Davis	1198 / 1125	4.16
39	466 / 57.2	Vicki & Michael Davis	1198 / 1125	4.16
40	466 / 41	Dominioin Transmission	A158 / 362	0.77
41	466 / 59	David & Ladonna Manley	1380 / 151	1.68
42	466 / 40	Frank N. Wine, Jr. & III	1596 / 809	42.04
43	465 / --	Unknown Parcel	--- / ---	16.52

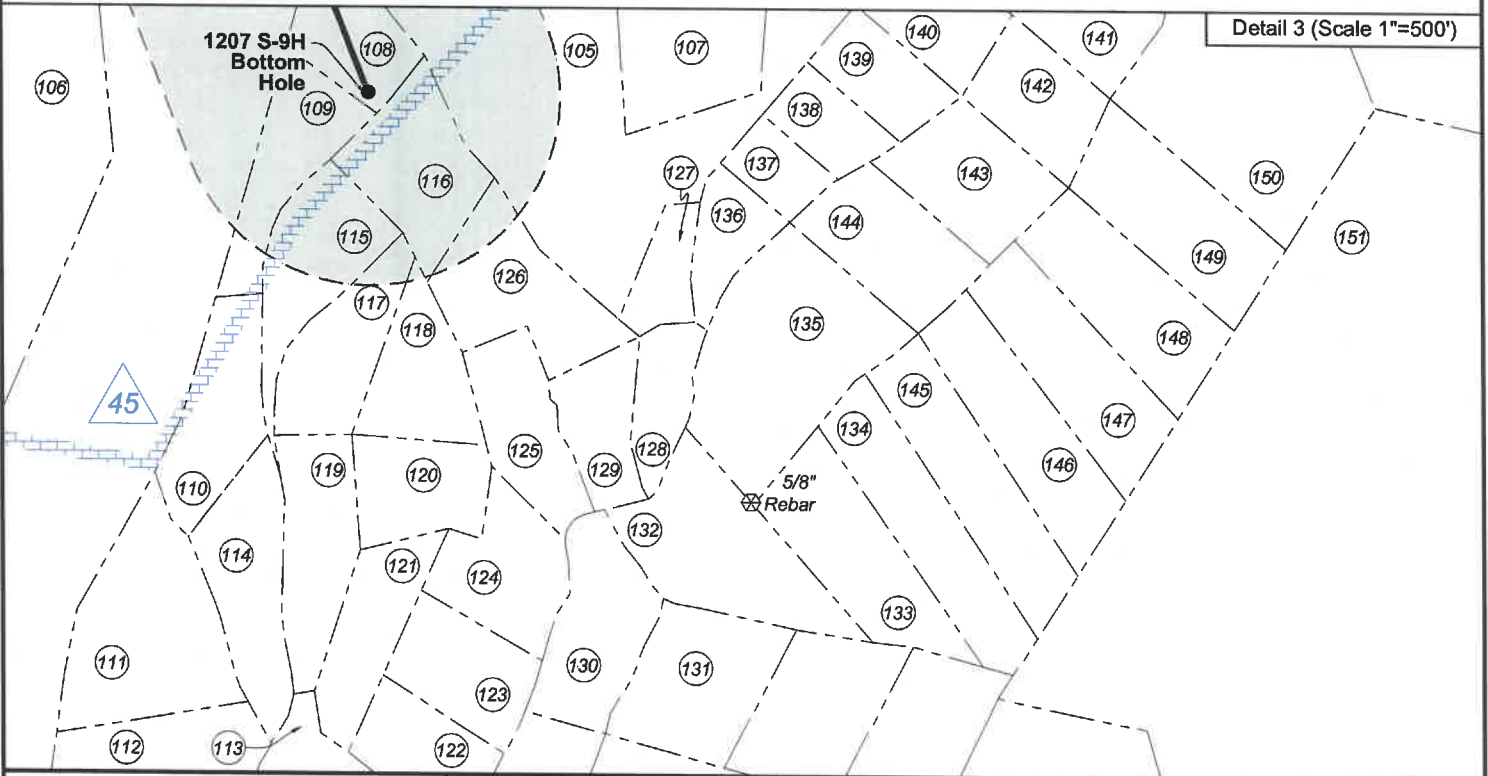

FILE NO: 296-36-G-18
DRAWING NO: Neel 1207 S-9H ASWP
SCALE: 1" = 2000'
MINIMUM DEGREE OF ACCURACY: Submeter
PROVEN SOURCE OF ELEVATION: CORS, Bridgeport, WV

STATE OF WEST VIRGINIA
DEPARTMENT OF ENVIRONMENTAL PROTECTION
OIL AND GAS DIVISION

DATE: April 7 2021
OPERATOR'S WELL NO. Neel 1207 S-9H
API WELL NO
47 - 033 - 05974
STATE COUNTY PERMIT

WELL TYPE: OIL GAS LIQUID INJECTION WASTE DISPOSAL
(IF GAS) PRODUCTION: STORAGE DEEP SHALLOW


LOCATION: ELEVATION: 1,344' WATERSHED: Middle West Fork Creek
DISTRICT: Grant
SURFACE OWNER: HG Energy II Appalachia, LLC
ROYALTY OWNER: Dora B. McWhorter, et al LEASE NO: ACREAGE: 103.00

PROPOSED WORK: DRILL CONVERT DRILL DEEPER FRACTURE OR STIMULATE PLUG OFF OLD FORMATION
 PERFORATE NEW FORMATION OTHER PHYSICAL CHANGE IN WELL (SPECIFY) LP & BH MOD
 PLUG AND ABANDON CLEAN OUT AND REPLUG TARGET FORMATION: Marcellus Shale ESTIMATED DEPTH: 21,669' MD


WELL OPERATOR: HG Energy II Appalachia, LLC ADDRESS: 5260 Dupont Road Parkersburg, WV 26101
DESIGNATED AGENT: Diane C. White ADDRESS: 5260 Dupont Road Parkersburg, WV 26101



Wellhead Layout (NTS)

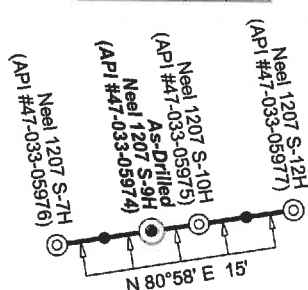


Well Location References
Not to Scale

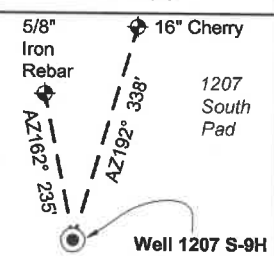

No.	TM / Par	Owner	Bk / Pg	Ac.
44	9C / 49	Timothy Dean Skinner	W4 / 706	1.35
45	9C / 50	Sharon Lee Allman	W47 / 298	0.73
46	9C / 46	Josephine M. Richardson	681 / 790	0.80
47	9C / 47	Josephine M. Richardson	681 / 790	2.36
48	9C / 45	Josephine M. Richardson	681 / 790	0.40
49	9C / 5.2	James R. & Sharon L. Allman	357 / 369	0.27
50	9C / 5.11	James R. & Sharon L. Allman	582 / 386	0.54
51	9C / 5	Steven Davis, et ux	665 / 329	20.47
52	9C / 6.11	Steve Davis & Darlene Davis	623 / 356	0.50
53	9C / 31	Steven M. Davis, et ux	713 / 12	1.62
54	9C / 5.3	Ryan K. Dumont, et ux	701 / 418	1.24
55	9C / 6.15	James R. Allman, et ux	662 / 432	1.51
56	9C / 6.16	Terrie & Mark Gregory	663 / 744	0.06
57	9C / 5.12	Mark A. Gregory, et ux	597 / 290	0.18
58	9C / 5.10	Angela M. Batten, et al	726 / 545	0.40
59	9C / 5.7	Mark A. Gregory, et ux	597 / 290	0.37
60	9C / 4	Joseph C. Rumbach, et ux	440 / 196	1.00
61	9C / 5.9	Christopher James Allman, et ux	513 / 527	0.41
62	9C / 3.2	David M. Hughes	506 / 714	0.85
63	9C / --	Monongahela Vally Traction Co.	76 / 424	0.06
64	9C / 3	Mary J. Radcliff, et al	W46 / 491	0.55
65	9C / 3.1	Nolan D. Gunter, Jr., et ux	594 / 145	0.50
66	9C / 6	Steven Davis, et ux	665 / 329	16.99
67	9C / 6.12	Amy N. Davis & Ryan K. Dumont	640 / 349	2.50
68	9C / 6.13	April D. & Brannon L. Jordan	641 / 42	1.05
69	9C / 6.3	Steve & Darlene Davis	665 / 329	0.38
70	9C / 6.14	April D. & Brannon L. Jordan	641 / 42	2.34
71	9C / 6.10	Elizabeth Post	594 / 764	0.74
72	9C / 6.17	Elizabeth Post	664 / 702	0.26
73	9C / 2	Nolan D. Gunter, Jr., et ux	594 / 145	0.25
74	9C / 1	Nolan D. Gunter, Jr., et ux	594 / 145	0.90
75	6 / 3	Catherine Weber	663 / 603	0.44
76	6 / 2.2	Willard J. Prince	--- / ---	0.24
77	6 / 2	Willard J. Prince	W22 / 109	1.22
78	6 / 1	Willard J. Prince	W22 / 109	4.75
79	6 / 2.1	JSB Land Holding	684 / 432	0.97
80	6 / 13	Jackie Lee Frazier	244 / 399	0.18
81	6 / 14	Daniel R. Rochelle L. Hinkle	732 / 6	0.18
82	6 / 15	Daniel R. Rochelle L. Hinkle	732 / 6	0.18
83	6 / 16	Floyd S. Woodyard	W6 / 138	4.00
84	6 / 31	Steven L. & Anna M. Butcher	543 / 765	3.34
85	6 / 32	Ronzel C. & Sandra K. Richards	317 / 331	4.00
86	9C / 5.6	Meranda K. Langbein	651 / 728	0.38
87	9C / 6.1	Robert Lee Smith, et ux	520 / 670	0.35
88	9C / 6.5	Robert Lee Smith, et ux	536 / 42	0.04
89	9C / 6.4	Kelly C. Montgomery	721 / 40	0.39
90	9C / 6.6	Charles W. Davis, et ux	611 / 655	0.35
91	9C / 6.8	Jerry D. Muncy, et ux	569 / 687	0.35
92	9C / 6.9	Jerry D. Muncy, et ux	569 / 687	0.40
93	9C / 6.7	Richard E. Ratliff, et ux	567 / 47	0.44
94	9C / 5.14	John M. Krupia, et ux	599 / 37	0.39
95	9C / 5.13	John M. Krupia, et ux	599 / 37	0.37
96	9C / 5.8	Charles E. Miller, et ux	663 / 185	0.18
97	9C / 5.5	T&G Rentals, LLC	667 / 767	0.24

No.	TM / Par	Owner	Bk / Pg	Ac.
98	9C / 7.1	Shaylee Suzanna Allman	670 / 621	0.77
99	9C / 7.2	Marcus Shane Gregory	673 / 609	0.80
100	9C / 7.3	Tyke Bryant Foster II	715 / 270	1.04
101	9C / 5.4	Jeffrey Russell Allman	162 / 588	0.38
102	9C / 5.1	Dominion Energy Transmission	--- / ---	0.70
103	9C / 7	Sharon Lee Allman	W47 / 298	74.55
104	9C / 30	Mike Ross Inc.	550 / 561	38.77
105	9C / 16.3	Mike Ross Inc.	712 / 409	42.71
106	9C / 8	Rose Ann & Hunter Kolb	W6 / 670	88.16
107	9C / 16.49	Rick & Carol Nolan	669 / 650	5.00
108	9C / 16.35	Tamera & Jonathan Riggs	724 / 203	2.07
109	9C / 16.36	Tamera & Jonathan Riggs	724 / 203	2.26
110	9C / 16.32	Roy & Rhoda Martin	638 / 722	2.51
111	9C / 16.16	Roy & Rhoda Martin	612 / 82	2.26
112	9C / 16.10	SWN Production Company, LLC	684 / 397	18.16
113	9C / 16.48	Roy & Rhoda Martin	662 / 618	4.29
114	9C / 16.28	Roy & Rhoda Martin	626 / 433	2.71
115	9C / 16.45	Jeffrey & Angela Ross	662 / 418	2.46
116	9C / 16.41	Tamera & Jonathan Riggs	724 / 199	2.62
117	9C / 16.34	Michael Stowers	669 / 418	2.26
118	9C / 16.33	Michael Stowers	669 / 418	2.07
119	9C / 16.13	Joni Nelson Howard	612 / 85	2.52
120	9C / 16.14	Joni Nelson Howard	669 / 642	2.03
121	9C / 16.29	Joni Nelson Howard	627 / 389	1.87
122	9C / 16.46	Roy & Rhoda Martin	662 / 618	2.03
123	9C / 16.47	Roy & Rhoda Martin	662 / 618	2.17
124	9C / 16.53	Joni Nelson Howard	674 / 69	2.38
125	9C / 16.6	Ross A. Lodge	717 / 846	1.73
126	9C / 52	Jeffrey & Ricki Leary	673 / 758	2.95
127	9C / 16.44	Jeremy & Autumn Vance	658 / 345	1.02
128	9C / 16.19	Robert P. Lindsey J. Shepherd	717 / 515	1.31
129	9C / 51	Jeffrey & Ricki Leary	673 / 744	1.64
130	9C / 16.21	David & Trena Bonnett	620 / 345	2.70
131	9C / 16.1	Mahadeo Ramkisoon	600 / 305	3.00
132	9C / 16.23	Brian W. Smith	712 / 459	1.60
133	9C / 16.43	Jason Eager	658 / 291	3.18
134	9C / 16.7	Sarah Nealis	684 / 321	6.37
135	9C / 16.11	Brian & Deborah Shillingburg	726 / 816	5.25
136	9C / 16.8	Virginia Barnette	608 / 505	1.25
137	9C / 16.2	Cody Kemper	736 / 800	0.96
138	9C / 16.31	Ross & Brenda Helmick	678 / 427	1.22
139	9C / 16.57	Samuel McDaniel, Jr.	713 / 53	1.53
140	9C / 16.18	Timothy Rice	702 / 475	2.00
141	9C / 16.5	Robert S. Hinderliter	608 / 6	4.30
142	9C / 16.17	Robert G. Fisher	639 / 511	2.00
143	9C / 16.30	John T. Vincent	647 / 344	2.56
144	9C / 50	Travis W. Taylor, et al	670 / 245	2.56
145	9C / 16.7	Sarah Nealis	684 / 321	6.37
146	9C / 16.27	Sarah Nealis	691 / 557	3.19
147	9C / 16.25	Paul A. & Karen B. Guillette	617 / 389	3.19
148	9C / 16.26	Paul A. & Karen B. Guillette	617 / 389	3.19
149	9C / 16.24	Paul A. & Karen B. Guillette	617 / 389	3.35
150	9C / 16.4	William A. & Amy D. Burchett	607 / 202	9.66
151	9C / 27	S. Thomas & Esther M. Bond	577 / 328	225.25

FILE NO: 296-36-G-18
DRAWING NO: Neel 1207 S-9H ASWP
SCALE: 1" = 2000'
MINIMUM DEGREE OF ACCURACY:
Submeter
PROVEN SOURCE OF ELEVATION:
CORS, Bridgeport, WV

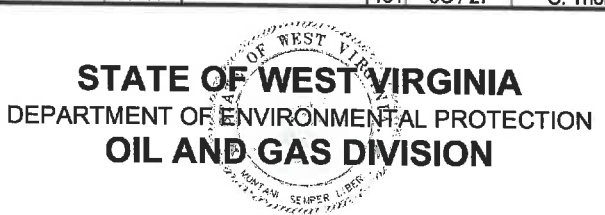

DATE: April 7 2021
OPERATOR'S WELL NO. Neel 1207 S-9H
API WELL NO
47 - 033 - 05974
STATE COUNTY PERMIT

WELL TYPE: OIL GAS LIQUID INJECTION WASTE DISPOSAL
(IF GAS) PRODUCTION: STORAGE DEEP SHALLOW

LOCATION: ELEVATION: 1,344' WATERSHED: Middle West Fork Creek
DISTRICT: Grant
SURFACE OWNER: HG Energy II Appalachia, LLC
ROYALTY OWNER: Dora B. McWhorter, et al LEASE NO: ACREAGE: 103.00
PROPOSED WORK: DRILL CONVERT DRILL DEEPER FRACTURE OR STIMULATE PLUG OFF OLD FORMATION
 PERFORATE NEW FORMATION OTHER PHYSICAL CHANGE IN WELL (SPECIFY) LP & BH MOD
 PLUG AND ABANDON CLEAN OUT AND REPLUG TARGET FORMATION: Marcellus Shale ESTIMATED DEPTH: 21,669' TVD

WELL OPERATOR: HG Energy II Appalachia, LLC DESIGNATED AGENT: Diane C. White
ADDRESS: 5260 Dupont Road ADDRESS: 5260 Dupont Road
Parkersburg, WV 26101 Parkersburg, WV 26101