

New Location  
 Deeper  
 Abandonment X

Company South Penn Oil Company 0772  
 Address 411-7th Ave. Pittsburgh, Pa.  
 Farm Jemima Bailey  
 Tract \_\_\_\_\_ Acres 100 Lease No. 25747  
 Well (Farm) No. 4 Serial No. \_\_\_\_\_  
 Elevation (Spirit Level) 1167.78  
 Quadrangle Vadis NE  
 County Harrison District Union  
 Engineer E.C. Tabler  
 Engineer's Registration No. \_\_\_\_\_  
 File No. \_\_\_\_\_ Drawing No. \_\_\_\_\_  
 Date Nov, 16, 1939 Scale 1" = 400'

STATE OF WEST VIRGINIA  
 DEPARTMENT OF MINES  
 OIL AND GAS DIVISION  
 CHARLESTON

WELL LOCATION MAP  
 FILE NO HAR-551A

+ Denotes location of well on United States Topographic Maps, scale 1 to 62,500. latitude and longitude lines being represented by border lines as shown.

- Denotes one inch spaces on border line of original tracing.

WEST VIRGINIA DEPARTMENT OF MINES

OIL & GAS DIVISION

WELL RECORD

Permit No. Haz-551 (plugging)  
- Quad.

Oil Well  
CASING & TUBING

Company	South Penn Oil Co.	10	354	pulled
Address	411-7th Ave., Pgh. Pa.	8-1/4	1533	
Farm	Jemima Bailey ACRES 100	6-5/8	2036	
Location	Kincheloe Creek	Cond. 16'		
Well No.	4	ELEV. 1167.78		
District	Union - Harrison County	COAL AT:		
Surface & Mineral	Mrs. Zina Haddon, Kincheloe, W. Va.	600'	60"	
Commenced	Nov. 6, 1919			
Completed	Jan. 16, 1940			
Shot	1/19/20 - Gordon Stray			
	7/23/29 - Gordon Stray			
Oil	22 bbls. 1st 24 hrs.			
Salt Water	1412			

✓ JAN 29 1940

Formation	Top	Base	Result
Bluff Sand	25	280	
Pgh. Coal	600	605	
Little Dunkard Sand	1000	1030	
Big Dunkard Sand	Shelly		
Gas Sand	1196	1240	
1st Salt Sand	1282	1330	
2nd Salt Sand	1363	1450	
			Water 1412
Taxon Sand	Shelly		
Little Lime	1963	1983	
Big Lime	1995	2060	
Big Injun Sand	2060	2165	
Squaw Sand	2165	2195	
Gantz Sand	2300	2383	
Fifty Foot Sand	2482	2490	
			Gas (very light) 2487
Thirty Foot Sand	2570	2585	
Gordon Stray Sand	2652		
			Oil 2662
Total Depth		2672	

NOW DRY WELL  
(Plat Service Data Jan. 1940)

STATE OF WEST VIRGINIA  
DEPARTMENT OF MINES  
OIL AND GAS DIVISION

444

WELL RECORD

Permit No. *Has-551A*

Oil or Gas Well **OIL**  
(Kind)


Company **South Penn Oil Company**  
Address **411 Seventh Ave., Pittsburgh, Pa.**  
Farm **Jemima Bailey** Acres **100**  
Location (waters) **Kincheloe Creek**  
Well No. **4** Elev. **1167.78**  
District **Union** County **Harrison**  
The surface of tract is owned in fee by **Mrs. Zina Windon**  
**Kincheloe, W. Va.**  
Mineral rights are owned by **Mrs. Zina Windon et al**  
**Kincheloe, W. Va.**  
Drilling commenced **Nov. 6, 1919**  
Drilling completed **Jan. 16, 1930**  
Date shot **Jan. 19-1920** Depth of shot **Gordon Stray**  
**July 23-1929** **Gordon Stray**  
Open Flow /10ths Water in **--** Inch  
/10ths Merc. in **--** Inch  
Volume **--** Cu. Ft.  
Rock Pressure **--** lbs. **--** hrs.  
Oil **22** bbls., 1st 24 hrs.  
Fresh water **--** feet **--** feet  
Salt water **1412** feet **--** feet

Casing and Tubing	Used in Drilling	Left in Well	Packers
Size			
16			Kind of Packer <b>--</b>
13			
10	<b>354' (pulled)</b>		Size of <b>--</b>
8 1/4	<b>1533'</b>		
6 5/8	<b>2036'</b>		Depth set <b>--</b>
5 3/16			
3			Perf. top <b>--</b>
2			Perf. bottom <b>--</b>
	Liners Used		Perf. top <b>--</b>
	Cond. <b>16'</b>		Perf. bottom <b>--</b>

CASING CEMENTED **--** SIZE **--** No. Ft. **--** Date **--**  
COAL WAS ENCOUNTERED AT **600** FEET **60** INCHES  
**--** FEET **--** INCHES **--** FEET **--** INCHES  
**--** FEET **--** INCHES **--** FEET **--** INCHES

Formation	Color	Hard or Soft	Top	Bottom	Oil, Gas or Water	Depth Found	Remarks
Bluff Sand			25	280			
Pittsburgh Coal			600	605			
Little Dunkard Sand			1000	1030			
Big Dunkard Sand				Shelly			
Gas Sand			1196	1240			
1st Salt Sand			1282	1330			
2nd Salt Sand			1363	1450			
Maxon Sand				Shelly	Water	1412	
Little Lime			1963	1983			
Big Lime			1995	2060			
Big Injun Sand			2060	2165			
Squaw Sand			2165	2195			
Gantz Sand			2300	2383			
Fifty Foot Sand			2482	2490			
Thirty Foot Sand			2570	2585	Gas (Very Light)	2487	
Gordon Stray Sand			2652		Oil	2662	
<b>Total Depth</b>				<b>2672</b>			

*Dry well*

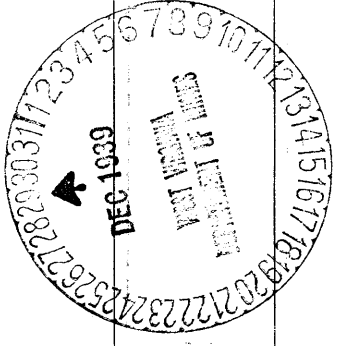

Formation	Color	Hard or Soft	Top	Bottom	Oil, Gas or Water	Depth Found	Remarks

Date **December 28,** 19**39**

APPROVED **SOUTH PENN OIL COMPANY,** Owner

By *Eaton Spring* Land Agent  
(Title)