

New Location
 Drill Deeper
 Abandonment

Map Sheet 55 Squares S19E9FB783R26

Company Hope Natural Gas Co.
 Address Clarksburg, W. Va.
 Farm W.S. Burnside
 Tract _____ Acres 0.50 Lease No. 52947
 Well (Farm) No. _____ Serial No. 1879
 Elevation (Spirit Level) 1017
 Quadrangle Weston
 County Harrison District Union
 Engineer W.M. Powers
 Engineer's Registration No. 900
 File No. _____ Drawing No. _____
 Date Jan. 21, 1946 Scale 1"=50'

STATE OF WEST VIRGINIA
 DEPARTMENT OF MINES
 OIL AND GAS DIVISION
 CHARLESTON

WELL LOCATION MAP
 FILE NO. HAR-936-A

+ Denotes location of well on United States Topographic Maps, scale 1 to 62,500. latitude and longitude lines being represented by border lines as shown.
 - Denotes one inch spaces in distance of original tracing



STATE OF WEST VIRGINIA
DEPARTMENT OF MINES
OIL AND GAS DIVISION

765

WELL RECORD

Permit No. 926-A


Oil or Gas Well _____
(KIND)

Company Hope Natural Gas Company.
 Address 445 West Main St. Clarksburg, W. Va.
 Farm W.S. Burnside Acres 0.50
 Location (waters) _____
 Well No. 1879 Elev. 1017
 District Union County Harrison
 The surface of tract is owned in fee by _____
 Address _____
 Mineral rights are owned by _____
 Address _____
 Drilling commenced June 15, 1910
 Drilling completed July 13, 1910
 Date Shot _____ From _____ To _____
 With _____
 Open Flow _____ /10ths Water in _____ Inch
 _____ /10ths Merc. in _____ Inch
 Volume _____ Cu. Ft.
 Rock Pressure _____ lbs. _____ hrs.
 Oil _____ bbls., 1st 24 hrs.
 Fresh water 320 385 feet _____ feet
 Salt water _____ feet _____ feet

Casing and Tubing	Used in Drilling	Left in Well	Packers
Size			
16			Kind of Packer _____
13			
10	✓ 342	342	Size of _____
8 1/4	✓ 709	709	
6 3/8	✓ 1281	1281	Depth set _____
5 3/16	✓ 1659	1659	
3			Perf. top _____
2			Perf. bottom _____
Liners Used	5 3/16" 103	103	Perf. top _____
			Perf. bottom _____

not cemented
 CASING CEMENTED _____ SIZE _____ No. Ft. _____ Date _____
 COAL WAS ENCOUNTERED AT 70 FEET 48 INCHES
165 FEET 60 INCHES FEET INCHES
 FEET INCHES FEET INCHES

Formation	Color	Hard or Soft	Top	Bottom	Oil, Gas or Water	Depth Found	Remarks
Coal			70	74			
Coal			165	170			
Little Dunkard			241	281			
Big Dunkard			375	398	water 320 385		
Gas sand			512	572			
First Salt			607	662			
Second Salt			722	780			
Maxon			855	900			
Little Lime			1162	1170			
Bencil cave			1170	1175			
Big Lime			1198	1272	gas 1210 show oil 1212		
Big Injun			1272	1388	gas 1319		
Berea			1587	1620			
Gantz			1691	1718	gas 1695		
Fifty foot			1731	1743			
Thirty foot			1778	1788			
Gordon stray			1838	1860			
Gordon			1880	1967			
Fourth			1971	1986			
Fifth			2092	2102	gas 2092 2102		
Total depth				2132			

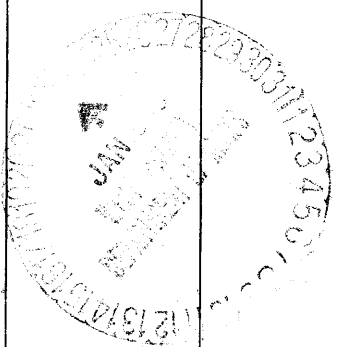

Formation	Color	Hard or Soft	Top	Bottom	Oil, Gas or Water	Depth Found	Remarks

Date January 21, 1946., 194

APPROVED Hope Natural Gas Company/, Owner

By J.A. Clark
General Superintendent.

