


Latitude 39° 20'

Longitude 80° 30'

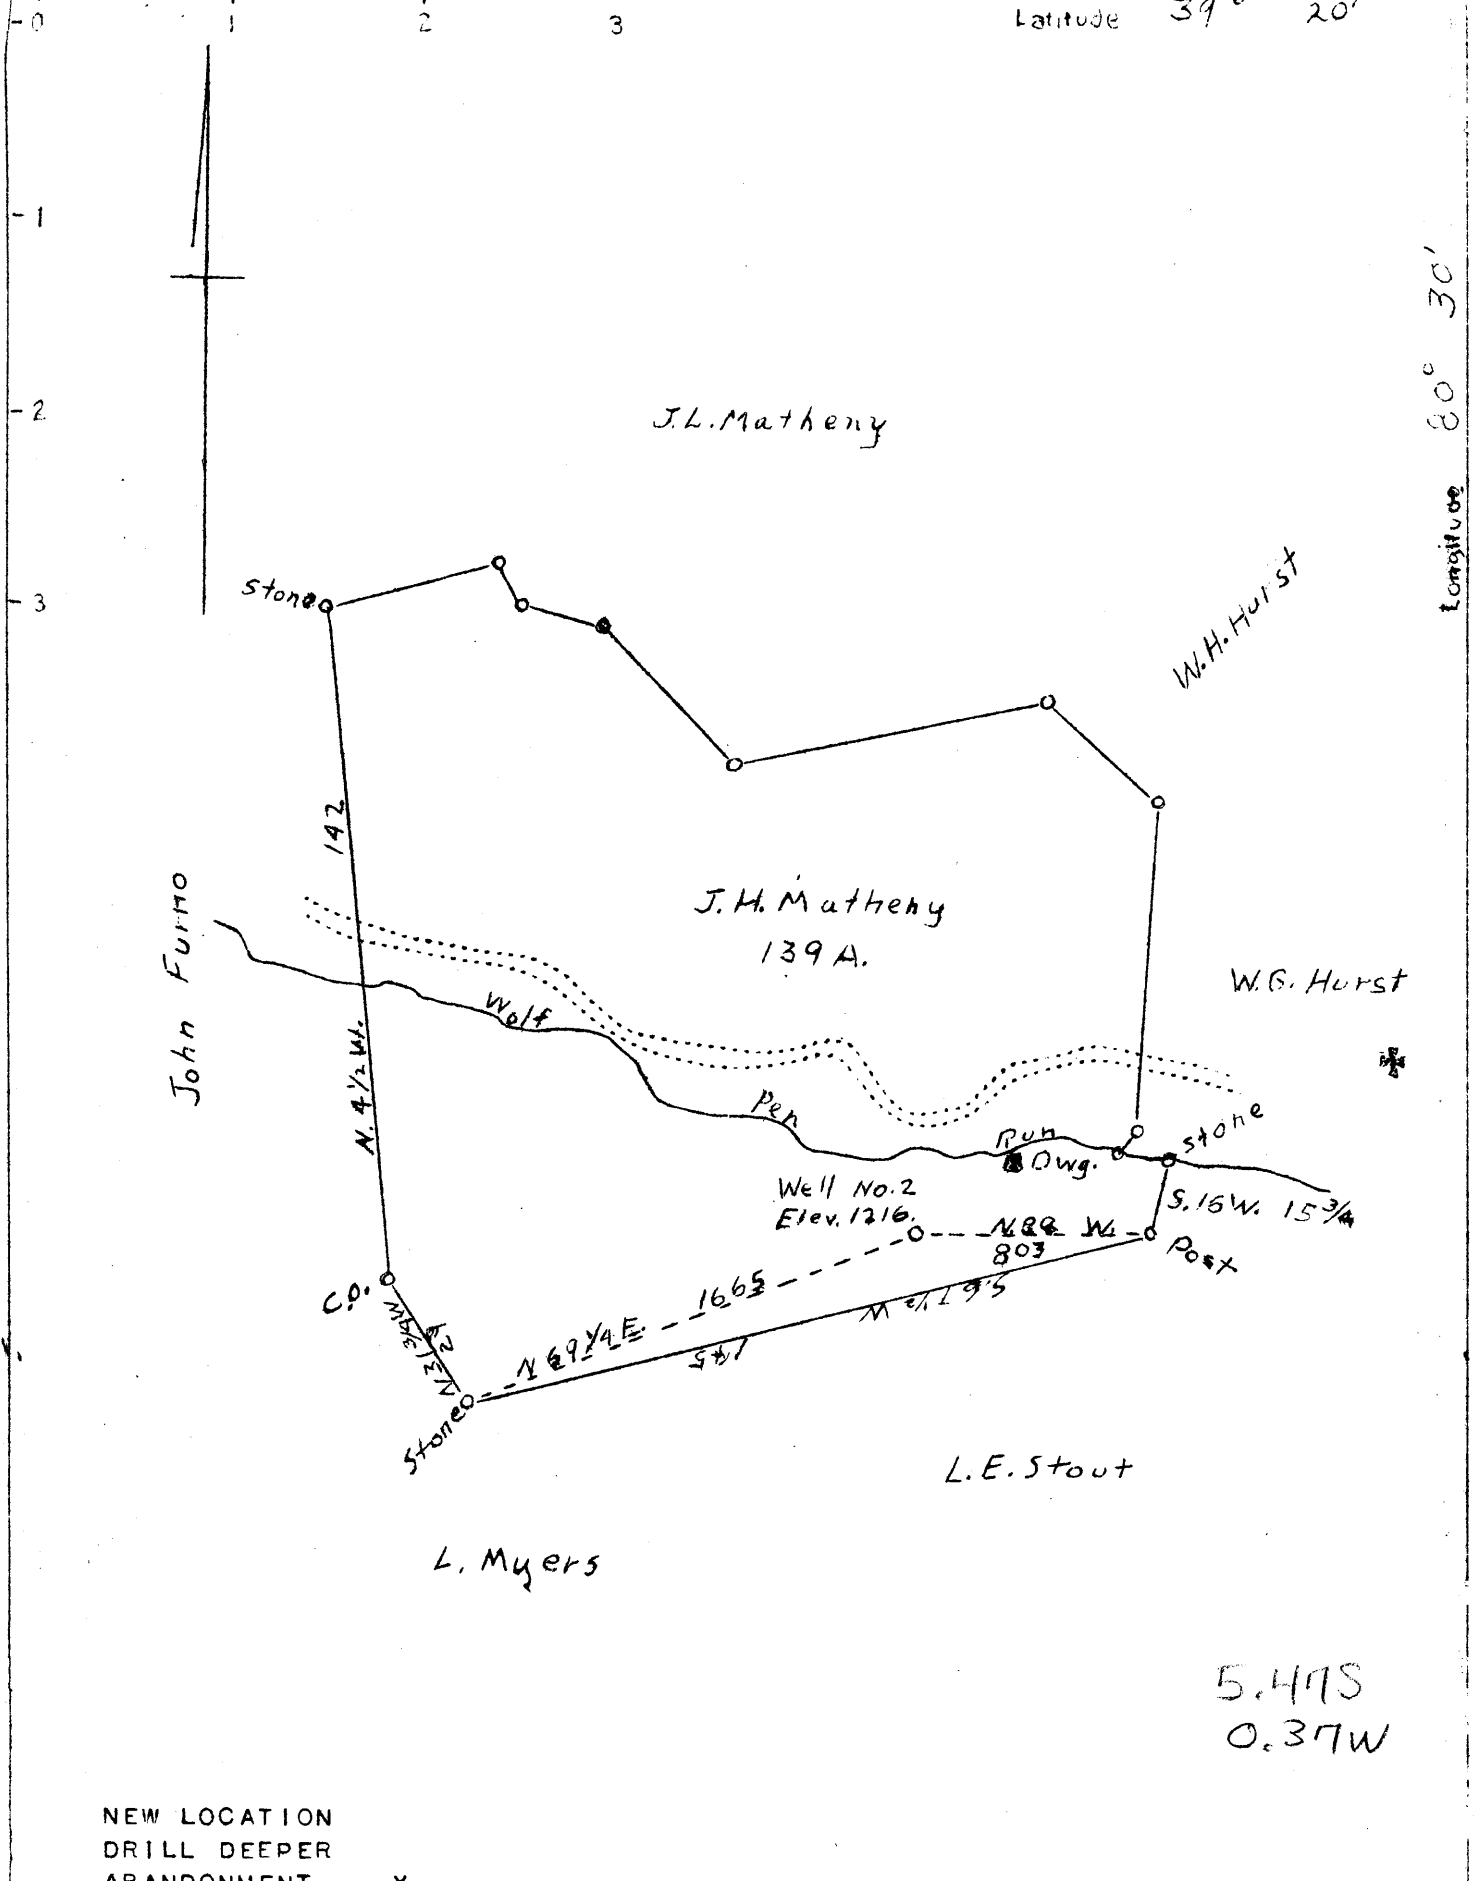

NEW LOCATION
 DRILL DEEPER
 ABANDONMENT X

5.47S
 0.37W

COMPANY WILLIAM MOSES
 ADDRESS 189 W. MAIN ST., SALEM, W.VA.
 FARM J. H. MATHENY
 TRACT ACRES 139 LEASE NO. _____
 WELL (FARM) NO. 2 SERIAL NO. _____
 ELEVATION (SPIRIT LEVEL) 1216
 QUADRANGLE CENTERPOINT
 COUNTY HARRISON DIST. TEN MILE
 ENGINEER A. K. WESTFALL
 ENGINEER'S REGISTRATION NO. _____
 FILE NO. _____ DRAWING NO. _____
 DATE MAR. 10, 1947 SCALE 1"=46 POLES

STATE OF WEST VIRGINIA
 DEPARTMENT OF MINES
 OIL AND GAS DIVISION
 CHARLESTON
 WELL LOCATION MAP
 FILE NO. HAR.-1061-A

+ DENOTES LOCATION OF WELL ON
 UNITED STATES TOPOGRAPHIC MAPS,
 SCALE 1 TO 62,500, LATITUDE AND
 LONGITUDE LINES BEING REPRESENTED
 BY BORDER LINES AS SHOWN.

- DENOTES ONE INCH SPACES ON
 BORDER LINE OF ORIGINAL TRACING.



880

STATE OF WEST VIRGINIA
DEPARTMENT OF MINES
OIL AND GAS DIVISION

WELL RECORD

Permit No. Ab 1061-A

Oil or Gas Well _____
(KIND)

Company William Moses
Address Salem, W. Va.
Farm J. H. Matheny Acres 139
Location (waters) _____
Well No. 2 Elev. 1216
District Jennings County Harrison
The surface of tract is owned in fee by William Moses
William Moses Address Salem, W. Va.
Mineral rights are owned by _____
Address _____

Casing and Tubing	Used in Drilling	Left in Well	Packers
Size			Kind of Packer
16			
13			Size of
10			
8 1/4		<u>1834</u>	Depth set
6 3/8		<u>1893</u>	
5 3/16	<input checked="" type="checkbox"/>		Perf. top
3			Perf. bottom
2	<input checked="" type="checkbox"/>	<u>2800</u>	Perf. top
Liners Used			Perf. bottom

Drilling commenced _____
Drilling completed
Date Shot _____ From _____ To _____
With _____
Open Flow _____ /10ths Water in _____ Inch
_____ /10ths Merc. in _____ Inch
Volume _____ Cu. Ft.
Rock Pressure _____ lbs. _____ hrs.
Oil _____ bbls., 1st 24 hrs.
Fresh water feet _____ feet
Salt water _____ feet _____ feet

CASING CEMENTED _____ SIZE _____ No. Ft. _____ Date _____
COAL WAS ENCOUNTERED AT 450 FEET _____ INCHES
_____ FEET _____ INCHES _____ FEET _____ INCHES
_____ FEET _____ INCHES _____ FEET _____ INCHES

Formation	Color	Hard or Soft	Top	Bottom	Oil, Gas or Water	Depth Found	Remarks
			<u>450</u>	<u>456</u>			
			<u>1885</u>	<u>1945</u>			
			<u>2575</u>	<u>2607</u>			
			<u>2764</u>	<u>2770</u>			
			<u>Total Depth 2805</u>				

