

Surface: Gordon Ashcraft; Wallace, Harrison Co., W.Va.

Coal: Was Wallace Coal & Coke Co. Sold to State of W.Va. for taxes, 1927.  
 Redeemed in 1946. Title now in Miss Margaret A. Tetrick,  
 271 Clay St., Clarksburg, W.Va.

0.455  
 3.90W

New Location   
 Drill Deeper   
 Abandonment

S 3 E 7

Company Road Supply Co.  
 Address Salem, W.Va.  
 Farm S.N. Parrish  
 Tract Acres 77<sup>a</sup> Lease No. \_\_\_\_\_  
 Well (Farm) No. 3 Serial No. \_\_\_\_\_  
 Elevation (Spirit Level) Floor - 1262.85  
Ground - 1258.35  
 Quadrangle Clarksburg  
 County Harrison District Sardis  
 Engineer E.C. Tabler  
 Engineer's Registration No. \_\_\_\_\_  
 File No. \_\_\_\_\_ Drawing No. \_\_\_\_\_  
 Date Oct 3<sup>o</sup>, 1946 Scale 1" = 400'

STATE OF WEST VIRGINIA  
 DEPARTMENT OF MINES  
 OIL AND GAS DIVISION  
 CHARLESTON

WELL LOCATION MAP  
 FILE NO. HAR-1076-A

+ Denotes location of well on United States Topographic Maps, scale 1 to 62,500, latitude and longitude lines being represented by border lines as shown.

- Denotes one inch spaces on border line of original tracing.



900

STATE OF WEST VIRGINIA  
DEPARTMENT OF MINES  
OIL AND GAS DIVISION

WELL RECORD

Permit No. 1076-A

Oil or Gas Well X  
(KIND)


Company Raad Supply Company  
Address 184 East Main St., Salem, W. Va.  
Farm S. N. Parrish Acres 77  
Location (waters).....  
Well No. 3 Elev. 1258.35  
District Sardis County Harrison  
The surface of tract is owned in fee by Gordon Ashcraft  
Address Wallace, W. Va.  
Mineral rights are owned by Miss Margaret A. Tetrick  
271 Clay St., Address Clarksburg, W. Va.  
Drilling commenced October 15, 1914  
Drilling completed December 11, 1914  
Date Shot 9/5/16 From 3038 To.....  
With.....

Casing and Tubing	Used in Drilling	Left in Well	Packers
Size			
16			Kind of Packer.....
18			
10	309	None	Size of.....
8 1/2	1409	None	
6	2333	2333	Depth set.....
5 3/16	2822	2822	
3			Perf. top.....
2			Perf. bottom.....
Liners Used.....			Perf. top.....
			Perf. bottom.....

Open Flow /10ths Water in..... Inch  
/10ths Merc. in..... Inch  
Volume..... Cu. Ft.  
Rock Pressure..... lbs..... hrs.  
Oil..... bbls., 1st 24 hrs.  
Fresh water..... feet..... feet  
Salt water..... feet..... feet

CASING CEMENTED..... SIZE..... No. Ft..... Date.....  
COAL WAS ENCOUNTERED AT 945 FEET 24 INCHES  
..... FEET..... INCHES..... FEET..... INCHES  
..... FEET..... INCHES..... FEET..... INCHES

Formation	Color	Hard or Soft	Top	Bottom	Oil, Gas or Water	Depth Found	Remarks
Conseuctor				16			
Coal, Pittsburgh			943	945			
Little Dunkard			1288	1332			
Big Dunkard			1409	1508			
Salt Sand			1700	1735			
Salt Sand			1860	1930			
Salt Sand			2010	2085			
Maxon Sand			2105	2132			
Big Lime			2160	2210			
Big Injun			2210	2323			
Fifty Foot			2815	2852			
Thirty Foot			2891	2930			
Gas			2928		Gas		
Stray Sand, Gas			2986	3015	Gas		
Gas			3023		Gas		
Gordon Sand			3029	3051			
1st. Pay, Oil			3040	3043	Oil		
Fourth Sand			3054	3066			
Total Depth				3068			

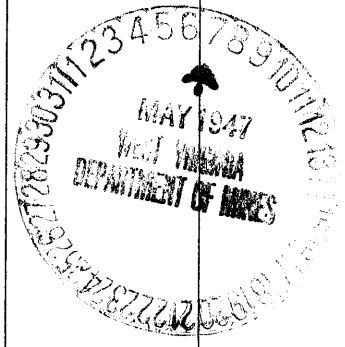

Formation	Color	Hard or Soft	Top	Bottom	Oil, Gas or Water	Depth Found	Remarks

Date July 6, 1947

APPROVED Road Supply Co, Owner

By J. M. Road, Jr., owner  
(Title)