

Ai Reynolds


56 1/2 a

Hugh Lyons
28 1/2 a

Corrinne M. Jackson
90 a

Floranus Reynolds
173 a

Alloytus Reynolds
106 1/2 a

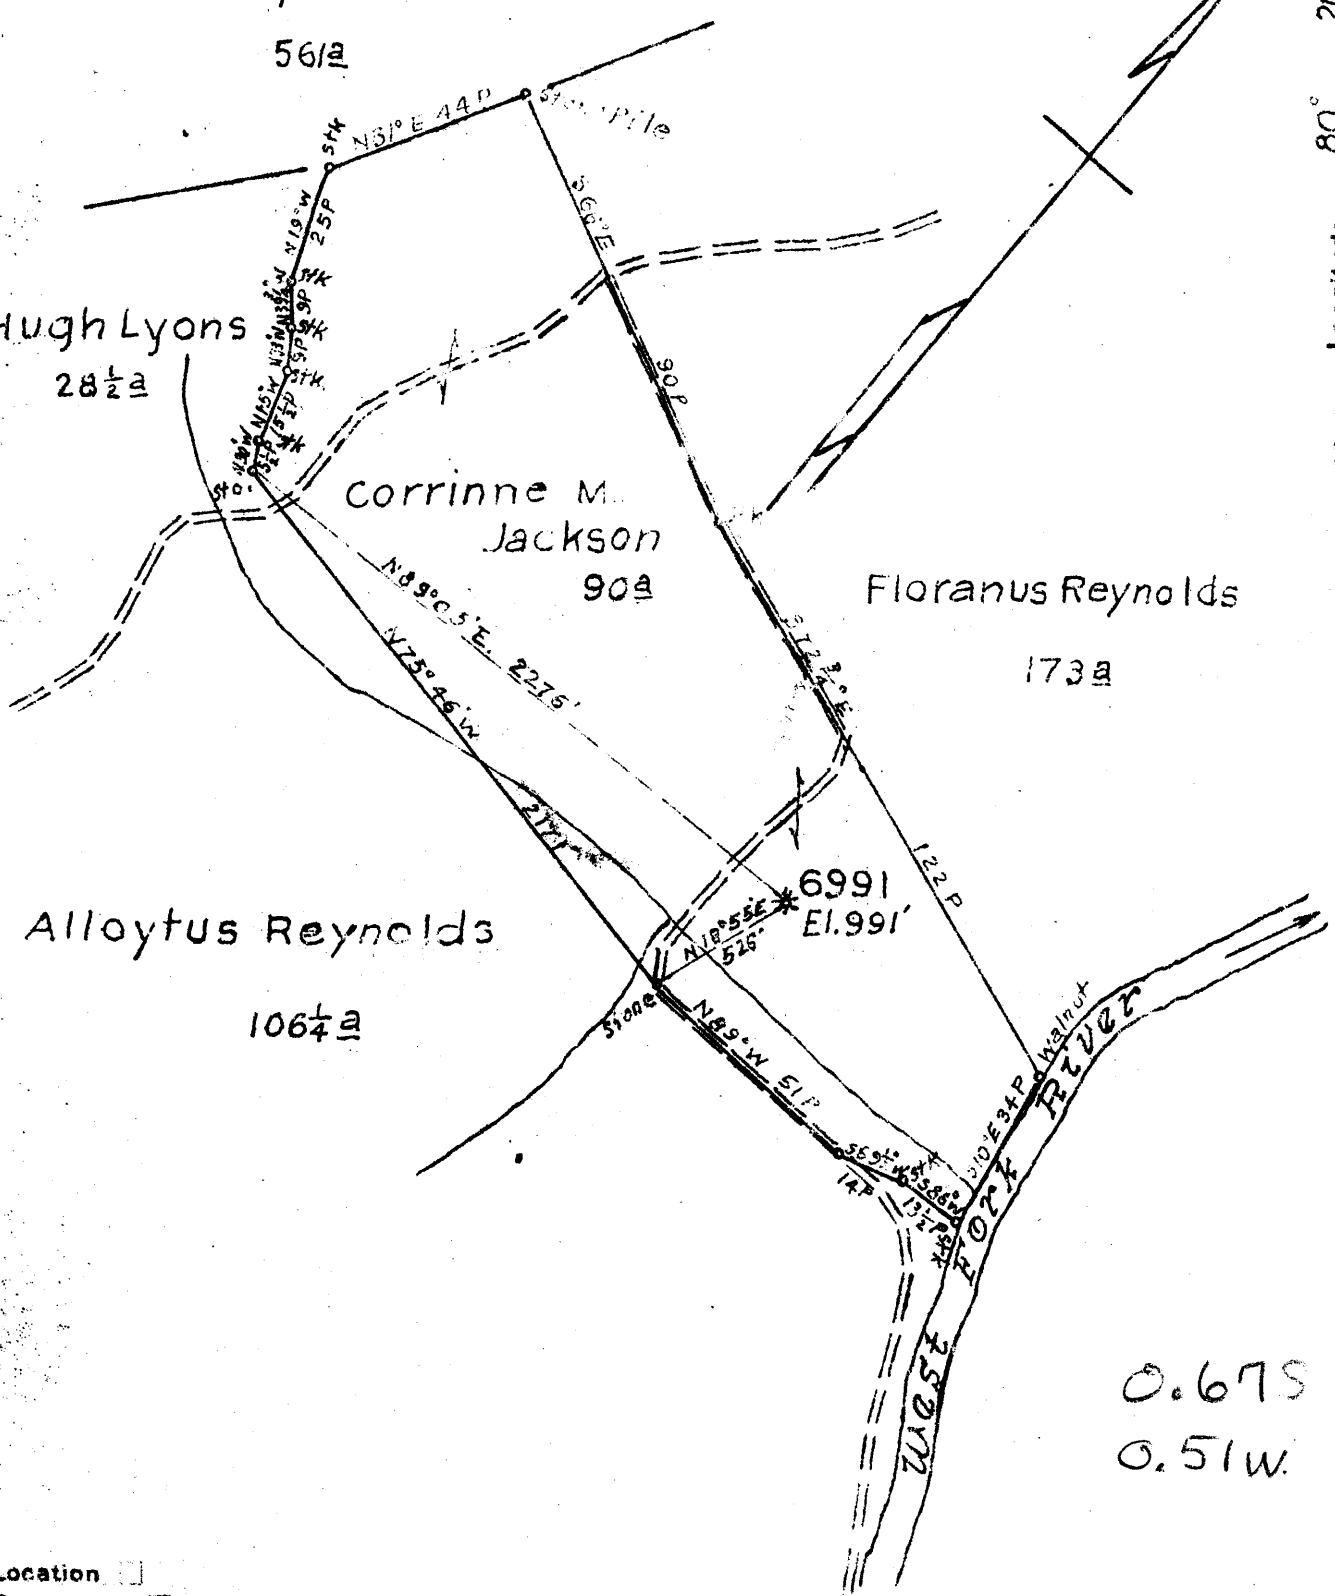

0.675
0.51w

New Location
Drill Deeper
Abandonment

Map Sh. 44 S 10 E 15 FB 522 P-8 13

Company	Hope Natural Gas Co.
Address	Clarksburg, W. Va.
Farm	Corinne M. Jackson
Tract	Acres 90 Lease No. 43733
Well (Farm) No.	Serial N 6991
Elevation (Spirit Level)	991'
Quadrangle	Clarksburg
County	Harrison District Coal
Engineer	W. M. Powers
Engineer's Registration No.	900
File No.	Drawing No.
Date	3-25-48 Scale 1" = 40 P

STATE OF WEST VIRGINIA
DEPARTMENT OF MINES
OIL AND GAS DIVISION
CHARLESTON

WELL LOCATION MAP
FILE NO. HAR-1185-A

+ Denotes location of well on United States Topographic Maps, scale 1 to 62,500. latitude and longitude lines being represented by border lines as shown.

- Denotes one inch spaces on border line of original tracing.



STATE OF WEST VIRGINIA
DEPARTMENT OF MINES
OIL AND GAS DIVISION

1227

WELL RECORD


Permit No. 1155 A Oil or Gas Well Oil (KIND)

Company Hope Natural Gas Company
Address 445 West Main St. Clarksburg, W. Va.
Farm Corinne M. Jackson Acres 90
Location (waters) _____
Well No. 6991 Elev. 991
District Coal County Harrison
The surface of tract is owned in fee by _____
Address _____
Mineral rights are owned by _____
Address _____
Drilling commenced November 19, 1925
Drilling completed January 21, 1926
Date Shot _____ From _____ To _____
With _____
Open Flow _____ /10ths Water in _____ Inch
_____ /10ths Merc. in _____ Inch
Volume _____ Cu. Ft.
Rock Pressure _____ lbs. _____ hrs.
Oil _____ bbls., 1st 24 hrs.
Fresh water none recorded feet _____ feet
Salt water none recorded feet _____ feet

Casing and Tubing	Used in Drilling	Left in Well	Packers
Size			
16			Kind of Packer
13			
10	166	166	Size of
8 1/4	956	956	
6 5/8	1397	1397	Depth set
5 3/16			
3	3066	3066	Perf. top
2			Perf. bottom
Liners Used			Perf. top
			Perf. bottom

CASING CEMENTED NOT SIZE _____ No. Ft. _____ Date _____
COAL WAS ENCOUNTERED AT BELOW FEET _____ INCHES _____
FEET _____ INCHES FEET _____ INCHES
FEET _____ INCHES FEET _____ INCHES

Formation	Color	Hard or Soft	Top	Bottom	Oil, Gas or Water	Depth Found	Remarks
Sand			100	115			
Sand			270	300			
Little Dunkard			390	425			
Big Dunkard			475	530			
Salt sand			684	725			
Second Salt			748	940			
Little Lime			1310	1320			
Big Lime			1340	1410			
Big Injun			1410	1510			
Gantz			1835	1850			
Forty foot			1860	1902			
Thirty foot			1910	2060			
Gordon			2193	2235			
Fifth			2345	2365	gas	2346	
Speechley			3048	3058	gas	3044	
Total depth				3066			

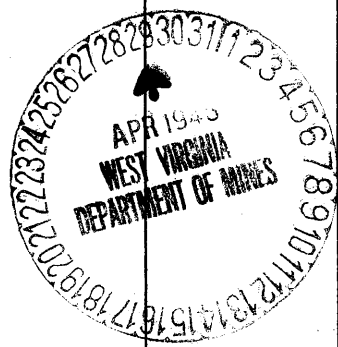

Formation	Color	Hard or Soft	Top	Bottom	Oil, Gas or Water	Depth Found	Remarks

Date April 27, 1948, 19____

APPROVED Hope Natural Gas Company., Owner

By _____

(T.H.)
