

2.25 S  
1.42 W

New Location   
 Drill Deeper   
 Abandonment

Map Sh. 42-S11E19 F.B. 525 P 35.

Company Hope Natural Gas Co  
 Address Clarksburg W. Va.  
 Farm Bertha Maxwell  
 Tract \_\_\_\_\_ Acres 106 Lease No. 45493  
 Well (Farm) No. \_\_\_\_\_ Serial No. 7567  
 Elevation (Spirit Level) 978'  
 Quadrangle Clarksburg SE  
 County Harrison District Simpson  
 Engineer W.M. Sawyer  
 Engineer's Registration No. 900  
 File No. \_\_\_\_\_ Drawing No. \_\_\_\_\_  
 Date 9-28-49 Scale 1"=600'

STATE OF WEST VIRGINIA  
 DEPARTMENT OF MINES  
 OIL AND GAS DIVISION  
 CHARLESTON

**WELL LOCATION MAP**  
 FILE NO. HAR-1362-A

+ Denotes location of well on United States Topographic Maps, scale 1 to 62,500, latitude and longitude lines being represented by border lines as shown.  
 - Denotes one inch spaces on border line of original tracing.



1156

STATE OF WEST VIRGINIA  
DEPARTMENT OF MINES  
OIL AND GAS DIVISION

WELL RECORD

Permit No. 12674


~~Oil~~ Gas Well (KIND)

Company Hope Natural Gas Company.  
 Address 445 West Main St. Clarksburg, W. Va.  
 Farm Bertha Maxwell Acres 106  
 Location (waters) \_\_\_\_\_  
 Well No. 7567 Elev. 978  
 District Simpson County Harrison  
 The surface of tract is owned in fee by \_\_\_\_\_  
 Address \_\_\_\_\_  
 Mineral rights are owned by \_\_\_\_\_  
 Address \_\_\_\_\_  
 Drilling commenced \_\_\_\_\_  
 Drilling completed purchased well  
 Date Shot \_\_\_\_\_ From \_\_\_\_\_ To \_\_\_\_\_  
 With \_\_\_\_\_  
 Open Flow \_\_\_\_\_ /10ths Water in \_\_\_\_\_ Inch  
 \_\_\_\_\_ /10ths Merc. in \_\_\_\_\_ Inch  
 Volume \_\_\_\_\_ Cu. Ft.  
 Rock Pressure no record lbs. \_\_\_\_\_ hrs.  
 Oil \_\_\_\_\_ bbls., 1st 24 hrs.  
 Fresh water \_\_\_\_\_ feet \_\_\_\_\_ feet  
 Salt water \_\_\_\_\_ feet \_\_\_\_\_ feet

Casing and Tubing	Used in Drilling	Left in Well	Packers
Size			
16			Kind of Packer
13			
10	?	?	Size of
8 1/4	?	.2	
6 5/8	?	?	Depth set
5 3/16	?	?	
3			Perf. top
2		1895'	Perf. bottom
Liners Used			Perf. top
			Perf. bottom

CASING CEMENTED \_\_\_\_\_ SIZE \_\_\_\_\_ No. Ft. \_\_\_\_\_ Date \_\_\_\_\_  
 tubing cemented in \_\_\_\_\_  
 COAL WAS ENCOUNTERED AT \_\_\_\_\_ FEET \_\_\_\_\_ INCHES  
 \_\_\_\_\_ FEET \_\_\_\_\_ INCHES FEET \_\_\_\_\_ INCHES  
 \_\_\_\_\_ FEET \_\_\_\_\_ INCHES FEET \_\_\_\_\_ INCHES

Formation	Color	Hard or Soft	Top	Bottom	Oil, Gas or Water	Depth Found	Remarks
Fifth sand			2293	2339	gas	2319	
Total depth				2363			

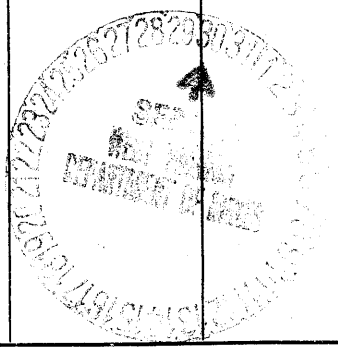

NOV - 4 1949

Formation	Color	Hard or Soft	Top	Bottom	Oil, Gas or Water	Depth Found	Remarks

Date September 28, 1949., 19

APPROVED Hope Natural Gas Company, Owner

By E. H. Tollefson

(Title) Superintendent

**BERTHA MAXWELL NO. 7567 WELL.**

1362A

Simpson District, Harrison County, W. Va.  
By Hope Natural Gas Co., 445 W. Main St., Clarksburg, W. Va.  
Abandoned under permit Har-.....-A?  
On 106 acres,  
Elevation, 978' L.  
Purchased well.  
2" tubing, 1895' (estimated).  
Tubing cemented in.  
No record of coal.  
Gas well. Record to Dept. of Mines dated Sept. 28, 1949.  
Record to MCT from Mrs. Griffith Nov. 4, 1949. Old File No. 1166.

Fifth Sand (gas, 2319')  
Total depth

Top.	Bottom.
2293	- 2339
	2363