

New Location   
 Drill Deeper.....  
 Abandonment..... 8149

Company HOPE NATURAL GAS CO.  
 Address CLARKSBURG, W. VA.  
 Farm Mary Bartlett  
 Tract \_\_\_\_\_ Acres 187 Lease No. 52921  
 Well (Farm) No. 1-2 Serial No. See Plat  
 Elevation (Spirit Level) See Plat  
 Quadrangle WESTON  
 County HARRISON District UNION  
 Engineer Wm Bowers  
 Engineer's Registration No. 900  
 File No. \_\_\_\_\_ Drawing No. \_\_\_\_\_  
 Date 7-17-50 Scale 1" = 30'

STATE OF WEST VIRGINIA  
 DEPARTMENT OF MINES  
 OIL AND GAS DIVISION  
 CHARLESTON

**WELL LOCATION MAP**  
 FILE NO. HAR-1428-A-#8149

+ Denotes location of well on United States Topographic Maps, scale 1 to 62,500, latitude and longitude lines being represented by border lines as shown.

- Denotes one inch spaces on border line of original tracing.



STATE OF WEST VIRGINIA  
DEPARTMENT OF MINES  
OIL AND GAS DIVISION

1233

WELL RECORD

Permit No. 1428-0A


Oil and Gas Well  
(KIND)

Company Hope Natural Gas Company.  
Address 445 West Main St. Clarksburg, W. Va.  
Farm Mary Bartlett Acres 187  
Location (waters) \_\_\_\_\_  
Well No. 8149 Elev. 1068  
District Union County Harrison  
The surface of tract is owned in fee by \_\_\_\_\_  
Address \_\_\_\_\_  
Mineral rights are owned by \_\_\_\_\_  
Address \_\_\_\_\_  
Drilling commenced March 14, 1916  
Drilling completed April 25, 1916  
Date Shot \_\_\_\_\_ From \_\_\_\_\_ To \_\_\_\_\_  
With \_\_\_\_\_  
Open Flow \_\_\_\_\_ /10ths Water in \_\_\_\_\_ Inch  
\_\_\_\_\_ /10ths Merc. in \_\_\_\_\_ Inch  
Volume \_\_\_\_\_ Cu. Ft.  
Rock Pressure \_\_\_\_\_ lbs. \_\_\_\_\_ hrs.  
Oil \_\_\_\_\_ bbls., 1st 24 hrs.  
Fresh water 801 855 feet \_\_\_\_\_ feet  
Salt water none recorded feet \_\_\_\_\_ feet

Casing and Tubing	Used in Drilling	Left in Well	Packers
Size			
16			Kind of Packer
13			
10	146	146	Size of
8 1/4	996	996	
6 5/8	1382	1382	Depth set
5 3/16	2033	2033	
3			Perf. top
2	2968	2968	Perf. bottom
Liners Used			Perf. top
			Perf. bottom

CASING CEMENTED NOT SIZE \_\_\_\_\_ No. Ft. \_\_\_\_\_ Date \_\_\_\_\_  
COAL WAS ENCOUNTERED AT BELOW FEET \_\_\_\_\_ INCHES \_\_\_\_\_  
FEET \_\_\_\_\_ INCHES FEET \_\_\_\_\_ INCHES  
FEET \_\_\_\_\_ INCHES FEET \_\_\_\_\_ INCHES

Formation	Color	Hard or Soft	Top	Bottom	Oil, Gas or Water	Depth Found	Remarks
Little Dunkard			335	355			
Big Dunkard			470	530			
Gas sand			665	690			
First Salt			700	780			
Second Salt			785	880	water 801-855 Gas 801 855		
Little Lime			1255	1295			
Pencil cave			1295	<del>1295</del> 1297			
Big Lime			1297	1357			
BIG INJUN			1357	1472			
Squaw			1490	1520			
Gantz			1735	1752	gas	1745	
Fifty foot			1810	1865			
Thirty foot			1886	1898			
Gordon stray			1950	2018			
Gordon			2022	2070			
Fourth			2072	2127			
Fifth			2216	2230	gas	2219 2225	
Speechley			2916	2930	gas	2918	
Total depth				2968			

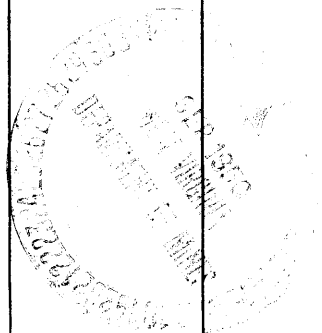

(Over) NOV 18 1950

Formation	Color	Hard or Soft	Top	Bottom	Oil, Gas or Water	Depth Found	Remarks

Date September 6, 1950, 19\_\_\_\_\_

APPROVED Hope Natural Gas Company., Owner

By \_\_\_\_\_

*(Signature)*