

3.22 S
1.75 W

3.20 S
1.72 W

New Location
 Drill Deeper
 Abandonment 1465

FORMERLY HOPE NATURAL GAS CO. N° 1465

Company A. M. SNIDER
 Address HUNDRED, W. VA.
 Farm J. W. HUSTEAD
 Tract _____ Acres 20 Lease No. 4736
 Well (Farm) No. 1 Serial No. 1465
 Elevation (Spirit Level) 1009'
 Quadrangle CLARKSBURG, W. VA.
 County HARRISON District EAGLE
 Engineer HENRY A. HAIN
 Engineer's Registration No. 3150
 File No. A.M.5-6 Drawing No. _____
 Date APRIL 8, 1959 Scale 1" = 400'

STATE OF WEST VIRGINIA
 DEPARTMENT OF MINES
 OIL AND GAS DIVISION
 CHARLESTON

WELL LOCATION MAP
 FILE NO. HAR-1702-A

+ Denotes location of well on United States Topographic Maps, scale 1 to 62,500, latitude and longitude lines being represented by border lines as shown.

- Denotes one inch spaces on border line of original tracing.



1583

STATE OF WEST VIRGINIA
DEPARTMENT OF MINES
OIL AND GAS DIVISION

Quadrangle Clarksburg, W. Va.

Permit No. 1465-1702-82

WELL RECORD

Oil or Gas Well Gas
(KIND)

Company A. M. Snider (R. L. Weston)
Address Hundred, West Virginia
Farm J. W. Husted Acres 20

Location (waters) Ten Mile Creek
Well No. 1465 Elev. 1009
District Eagle County Harrison

The surface of tract is owned in fee by Mrs. Rosa Husted
Route # 1 Address Lumberport, W. Va.

Mineral rights are owned by _____
Address _____

Drilling commenced Nov. 4, 1909

Drilling completed Feb. 7, 1910

Date Shot _____ From _____ To _____

With _____

Open Flow _____ /10ths Water in _____ Inch

_____ /10ths Merc. in _____ Inch

Volume _____ Cu. Ft.

Rock Pressure _____ lbs. _____ hrs.

Oil _____ bbls., 1st 24 hrs.

WELL ACIDIZED _____

WELL FRACTURED _____

RESULT AFTER TREATMENT _____

ROCK PRESSURE AFTER TREATMENT _____

Fresh Water _____ Feet _____ Salt Water _____ Feet _____

Casing and Tubing	Used in Drilling	Left in Well	Packers
Size			
16			Kind of Packer _____
13			<u>H.W. GA.</u>
10	<u>136'</u>		Size of <u>5 x 2</u>
8 1/4	<u>889'</u>		
6 5/8	<u>1316'</u>	<u>1316'</u>	Depth set <u>2099</u>
5 3/16	<u>2068' 8"</u>	<u>2068' 8"</u>	
3			Perf. top _____
2	<u>2321'</u>	<u>2321'</u>	Perf. bottom _____
Liners Used			Perf. top _____
			Perf. bottom _____


CASING CEMENTED _____ SIZE _____ No. Ft. _____ Date _____

COAL WAS ENCOUNTERED AT _____ FEET _____ INCHES

_____ FEET _____ INCHES _____ FEET _____ INCHES

_____ FEET _____ INCHES _____ FEET _____ INCHES

Formation	Color	Hard or Soft	Top	Bottom	Oil, Gas or Water	Depth	Remarks
Pitts. Coal			<u>75' Below</u>				
Dunkard Sand			<u>340</u>	<u>450</u>			
Gas			<u>540-630</u>				
Salt Sand			<u>715</u>	<u>855</u>			
Little Lime			<u>1181</u>	<u>1212</u>			
Big Lime			<u>1220</u>	<u>1306</u>	<u>Gas</u>	<u>1330</u>	
Injun Sand			<u>1306</u>	<u>1390</u>	"	<u>1385 Show</u>	
Squaw Sand			<u>1398</u>	<u>1530</u>			
Berea Sand			<u>1749</u>	<u>1775</u>			
Fifty Foot Sand			<u>1815</u>	<u>1906</u>	<u>Gas</u>	<u>1820</u>	
Thirty Foot Sand			<u>1911</u>	<u>1945</u>			
Stray Sand			<u>2035</u>	<u>2078</u>			
Gordon Sand			<u>2093</u>	<u>2137</u>	<u>Gas</u>	<u>2107</u>	
Fourth Sand			<u>2150</u>	<u>2173</u>			
Fifth Sand			<u>2255</u>	<u>2280</u>	"	<u>2257-62</u>	
Break			<u>2262</u>	<u>2265</u>	"	<u>2271</u>	
Total Depth				<u>2118</u>			
Deeper				<u>2306</u>			

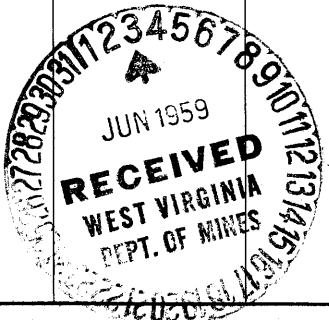

NOV 5 1959