


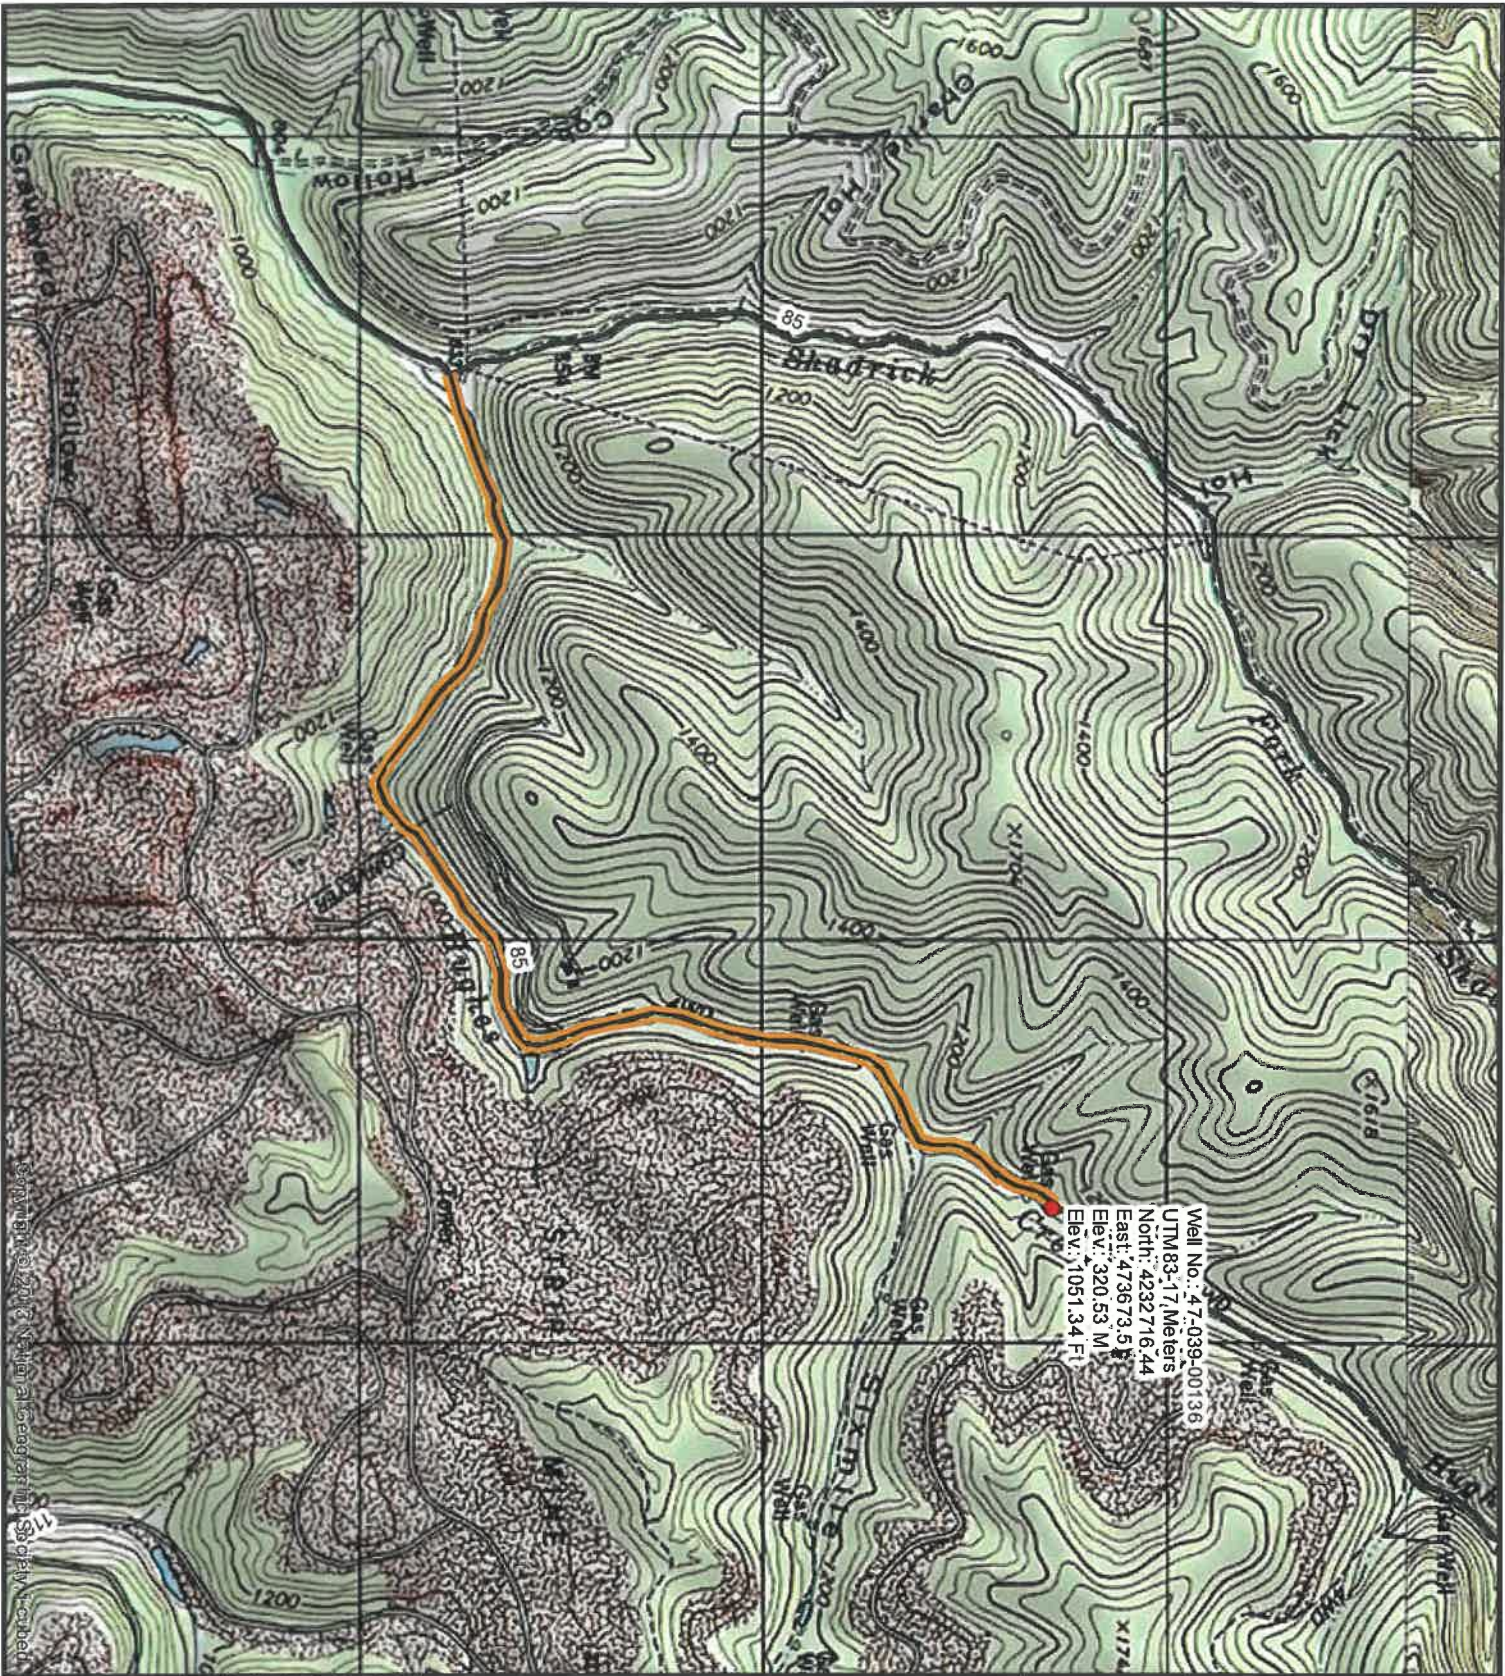

Diversified Gas & Oil
 Corporation
 100 Diversified Way
 Pikeville KY, 41051

07/17/2026


47-039-00136

Well Plugging Map

Legend

- Well
- Access Road
- Pits
- Pad
- Public Roads





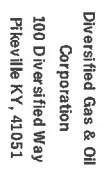

47-039-00136

Legend

- Well
Access Road
Pits
Pad
Public Roads

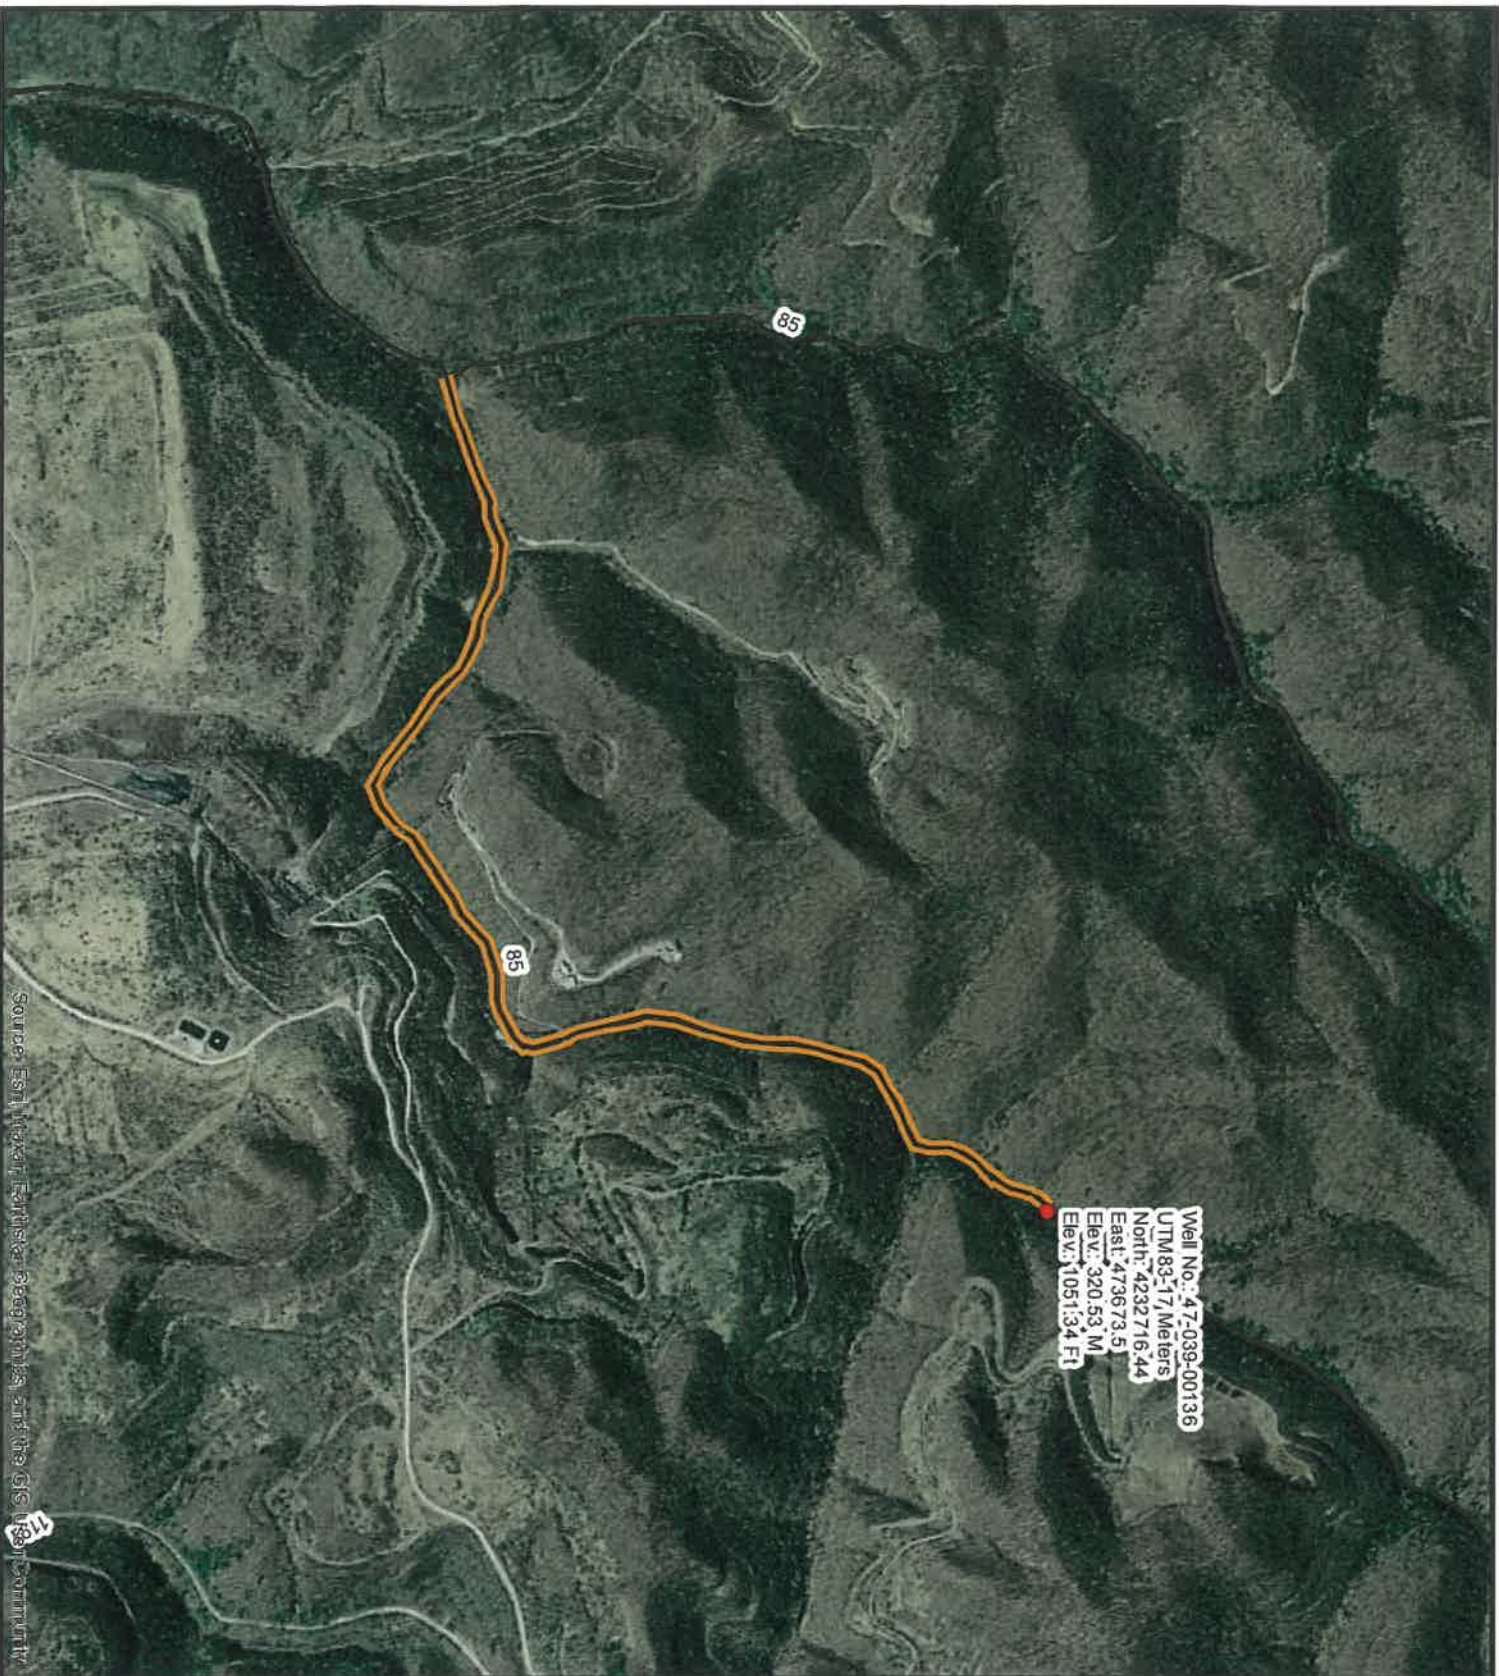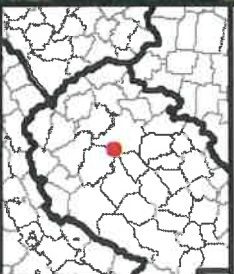

Source: Est. Index, Fertilizer Demand Index, and the GIS User Community.

WW-7
8-30-06



West Virginia Department of Environmental Protection
Office of Oil and Gas
WELL LOCATION FORM: GPS

API: 4703900136 WELL NO.: HUNTINGTON ARABELLA # 46
FARM NAME: Arabella D. Huntington
RESPONSIBLE PARTY NAME: Diversified Production, LLC
COUNTY: Kanawha DISTRICT: Cabin Creek
QUADRANGLE: Montgomery 7.5'
SURFACE OWNER: The West Virginia Land Trust, Inc. c/o Brent Bailey
ROYALTY OWNER: _____
UTM GPS NORTHING: 4232716.44
UTM GPS EASTING: 473673.5 GPS ELEVATION: 1051.34'

The Responsible Party named above has chosen to submit GPS coordinates in lieu of preparing a new well location plat for a plugging permit or assigned API number on the above well. The Office of Oil and Gas will not accept GPS coordinates that do not meet the following requirements:

1. Datum: NAD 1983, Zone: 17 North, Coordinate Units: meters, Altitude: height above mean sea level (MSL) – meters.
2. Accuracy to Datum – 3.05 meters
3. Data Collection Method:

Survey grade GPS ____ : Post Processed Differential ____
Real-Time Differential ____

Mapping Grade GPS X : Post Processed Differential X
Real-Time Differential ____

4. Letter size copy of the topography map showing the well location.

I the undersigned, hereby certify this data is correct to the best of my knowledge and belief and shows all the information required by law and the regulations issued and prescribed by the Office of Oil and Gas.

A blue ink signature of Nick Bungardner, written over a horizontal line.

Signature

Nick Bungardner - Permitting Supervisor

Title

6-18-2026

Date

07/17/2026