




Copyright © 2013 National Geographic Society. All rights reserved.

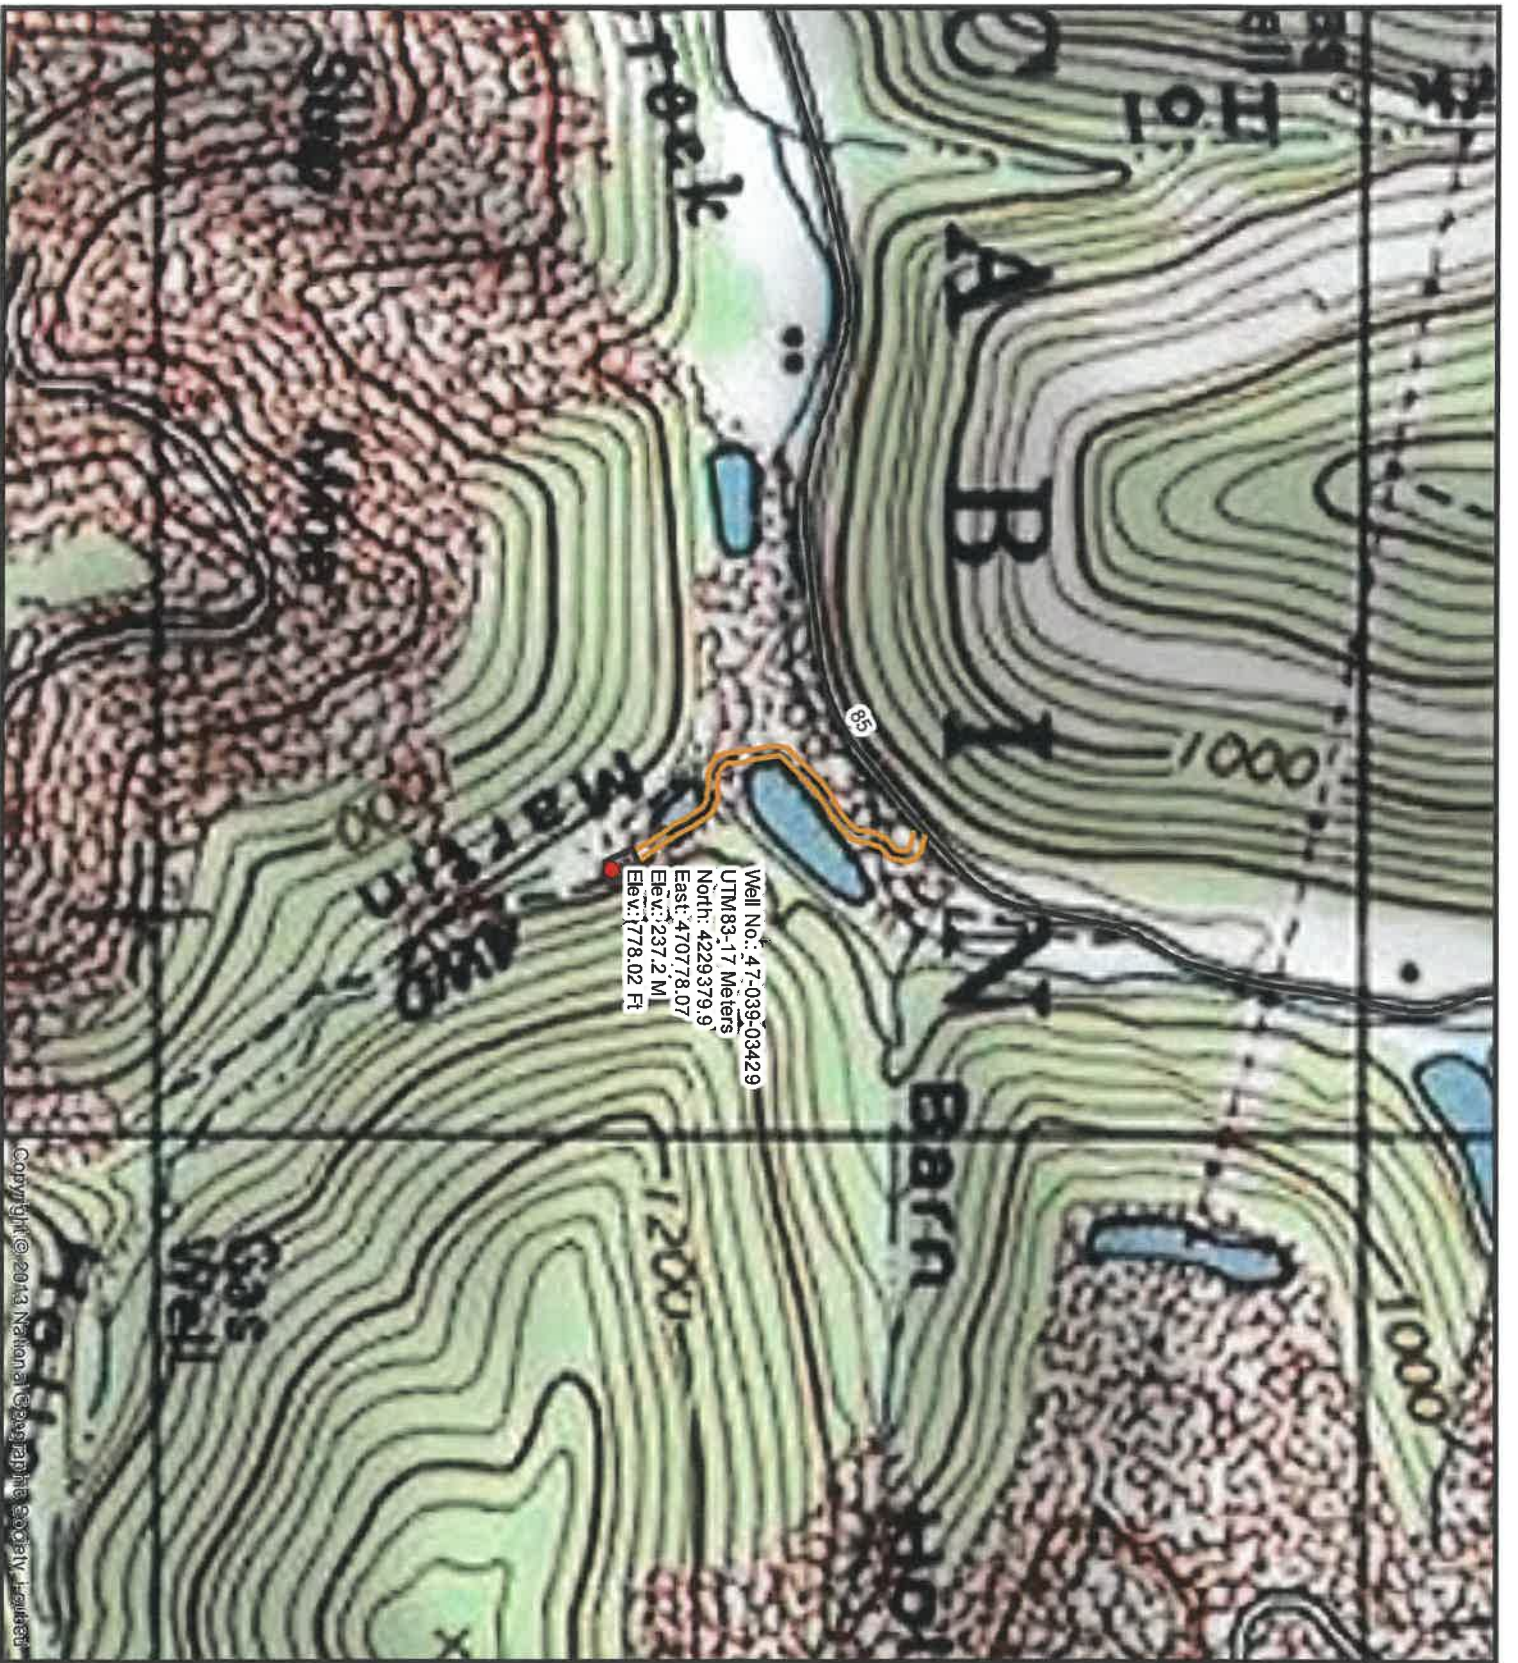

Diversified Gas & Oil
 Corporation
 100 Diversified Way
 Pikeville KY, 41051


07/17/2026

47-039-03429

Well Plugging Map

Legend

- Well
- Pits
- Pad
- Access Road
- Public Roads

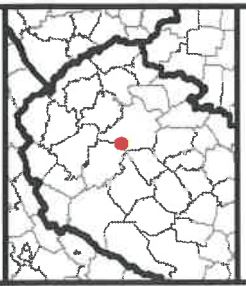

WW-7
8-30-06



West Virginia Department of Environmental Protection
Office of Oil and Gas
WELL LOCATION FORM: GPS

API: 4703903429 WELL NO.: HUNTINGTON HEIRS 13-280

FARM NAME: Arabella D. Huntington

RESPONSIBLE PARTY NAME: Diversified Production, LLC

COUNTY: Kanawha DISTRICT: Cabin Creek

QUADRANGLE: Montgomery 7.5'

SURFACE OWNER: Boone East Development Co.

ROYALTY OWNER: Boone East Development Co.

UTM GPS NORTHING: 4229379.9

UTM GPS EASTING: 470778.07 GPS ELEVATION: 778.02'

The Responsible Party named above has chosen to submit GPS coordinates in lieu of preparing a new well location plat for a plugging permit or assigned API number on the above well. The Office of Oil and Gas will not accept GPS coordinates that do not meet the following requirements:

1. Datum: NAD 1983, Zone: 17 North, Coordinate Units: meters, Altitude: height above mean sea level (MSL) – meters.
2. Accuracy to Datum – 3.05 meters
3. Data Collection Method:

Survey grade GPS ____ : Post Processed Differential ____


Real-Time Differential ____

Mapping Grade GPS X : Post Processed Differential X

Real-Time Differential ____

4. Letter size copy of the topography map showing the well location.

I the undersigned, hereby certify this data is correct to the best of my knowledge and belief and shows all the information required by law and the regulations issued and prescribed by the Office of Oil and Gas.

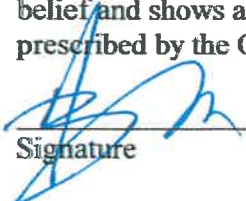
Signature

Nick Bongardner - Permitting Supervisor

Title

6-18-2026
Date

07/17/2026