

New Location
 Drill Deeper
 Abandonment

Company SAM BEREN
 Address 516-4th St., MARIETTA, OHIO
 Farm G.W. BELCHER
 Tract _____ Acres 183 Lease No. 738
 Well (Farm) No. 2-4-15 Serial No. (3140)
 Elevation (Spirit Level) SEE ABOVE (3142)
 Quadrangle CLENDENIN
 County KANAWHA District ELK NW
 Engineer L. P. Kuls
 Engineer's Registration No. 9
 File No. _____ Drawing No. _____
 Date 9-12-49 Scale 1"-1320'

STATE OF WEST VIRGINIA
 DEPARTMENT OF MINES
 OIL AND GAS DIVISION
 CHARLESTON

WELL LOCATION MAP
 FILE NO. KAN-782-A-#2
KAN-783-A-#4
KAN-784-A-#15

+ Denotes location of well on United States Topographic Maps, scale 1 to 62,500, latitude and longitude lines being represented by border lines as shown.

- Denotes one inch spaces on border line of original tracing.



STATE OF WEST VIRGINIA
DEPARTMENT OF MINES
OIL AND GAS DIVISION

1507

783-A

WELL RECORD


Permit No. _____ Oil or Gas Well _____ (KIND)

Company Valley Steel Products Company
 Address Saint Louis, Mo.
 Farm G. W. Belcher Acres 183
 Location (waters) Blue Creek
 Well No. 4 (3142) Elev. 1208'
 District Elk County Kanawha
 The surface of tract is owned in fee by G.W. Belcher Hrs.
 Address Blue Creek, W. Va.
 Mineral rights are owned by Coal Not Operated
 Address _____
 Drilling commenced Oct. 9, 1914
 Drilling completed Dec. 16, 1914
 Date Shot _____ From _____ To _____
 With _____
 Open Flow _____ /10ths Water in _____ Inch
 _____ /10ths Merc. in _____ Inch
 Volume _____ Cu. Ft.
 Rock Pressure _____ lbs. _____ hrs.
 Oil _____ bbls., 1st 24 hrs.
 Fresh water _____ feet _____ feet
 Salt water _____ feet _____ feet

Casing and Tubing	Used in Drilling	Left in Well	Packers
Size			Kind of Packer
16			
13			Size of
10			
8 1/4	665'	None	Depth set
6 5/8	1841'	1841'	
5 3/16	2151'	2151'	Perf. top
3			Perf. bottom
2			Perf. top
Liners Used			Perf. bottom

CASING CEMENTED _____ SIZE _____ No. Ft. _____ Date _____
 COAL WAS ENCOUNTERED AT _____ FEET _____ INCHES
 _____ FEET _____ INCHES FEET _____ INCHES
 _____ FEET _____ INCHES FEET _____ INCHES

Formation	Color	Hard or Soft	Top	Bottom	Oil, Gas or Water	Depth Found	Remarks
Salt Sand			1150	1610			
Maxon Sand			1755	1773			
Little Lime			1783	1817			
Pencil Cave			1832	1837			
Big Lime			1837	1987			
Weir Sand			2121	2247			
TOTAL DEPTH				2247			

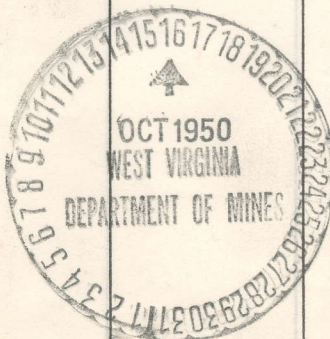

(Over) FEB 23 1951