

Company UNITED FUEL GAS CO.  
 Address CHARLESTON, W. VA.  
 Farm A.J. HINDMAN  
 Tract \_\_\_\_\_ Acres 55 Lease No. 13245  
 Well (Farm) No. 1 Serial No. 1446  
 Elevation (Spirit Level) 720.0'  
 Quadrangle WALTON  
 County KANAWHA District BIG SANDY  
 Engineer Seybert R Ferrell  
 Engineer's Registration No. 2529  
 File No. 78-69 Drawing No. \_\_\_\_\_  
 Date 8-19-54 Scale 1"=400'

STATE OF WEST VIRGINIA  
 DEPARTMENT OF MINES  
 OIL AND GAS DIVISION  
 CHARLESTON

WELL LOCATION MAP  
 FILE NO. KAN-1067-A

+ Denotes location of well on United States Topographic Maps, scale 1 to 62,500, latitude and longitude lines being represented by border lines as shown.

-- Denotes one inch spaces on border line of original tracing.

A.J. HINDMAN No. 1 (1446) - U. F. G. Co. - KAN-1067-A



STATE OF WEST VIRGINIA  
DEPARTMENT OF MINES  
OIL AND GAS DIVISION

1955

Quadrangle Walton

WELL RECORD

Oil or Gas Well Gas  
(KIND)

Permit No. 1067-A


Company UNITED FUEL GAS CO.  
Address P.O. Box 1273, Charleston 25, W. Va.  
Farm A. J. Hindman Acres 55  
Location (waters) Big Sandy Creek  
Well No. 1446 Elev. 720.0'  
District Big Sandy County Kanawha  
The surface of tract is owned in fee by \_\_\_\_\_  
Address \_\_\_\_\_  
Mineral rights are owned by C. T. Fleshman, et al  
Address Clendenin, W. Va.  
Drilling commenced 7-23-24  
Drilling completed 8-29-24  
Date Shot \_\_\_\_\_ From \_\_\_\_\_ To \_\_\_\_\_  
With \_\_\_\_\_  
Open Flow \_\_\_\_\_ /10ths Water in \_\_\_\_\_ Inch  
28 /10ths Merc. in \_\_\_\_\_ Inch  
Volume \_\_\_\_\_ Cu. Ft.  
900,000  
In. 210  
Rock Pressure B.L. 260 lbs. \_\_\_\_\_ hrs.  
Oil \_\_\_\_\_ bbls., 1st 24 hrs.  
Fresh water 180 feet \_\_\_\_\_ feet  
Salt water 975 feet \_\_\_\_\_ feet

Casing and Tubing	Used in Drilling	Left in Well	Packers
Size			
16			Kind of Packer
18			Anchor
10			Size of
8 1/4	<u>498'</u>		<u>3x5-3/16x16</u>
6 5/8		<u>1475'10"</u>	Depth set
5 3/16			<u>1554'</u>
3		<u>1631'9"</u>	Perf. top
2			Perf. bottom
Liners Used			Perf. top
			Perf. bottom

CASING CEMENTED \_\_\_\_\_ SIZE \_\_\_\_\_ No. Ft. \_\_\_\_\_ Date \_\_\_\_\_

COAL WAS ENCOUNTERED AT 335 FEET 60 INCHES  
400 FEET 48 INCHES FEET INCHES  
FEET INCHES FEET INCHES

Formation	Color	Hard or Soft	Top	Bottom	Oil, Gas or Water	Depth Found	Remarks
Soil			0	12			
Sand			12	70			
Slate			70	80			
Sand			80	160			
Slate			160	180			
Sand			180	335			
Coal			335	340			
Sand			340	355			
Slate			355	400			
Coal			400	404			
Slate			404	460			
Sand			460	480			
Slate			480	660			
Sand			660	740			
Slate & Shells			740	850			
Sand			850	870			
Slate			870	890			
Sand			890	1025			
Slate			1025	1080			
Sand			1080	1394			
Little Lime			1394	1411			
Slate			1411	1418			
Lime			1418	1423			
Red Pencil			1423	1429			
Lime			1429	1444			
Pencil			1444	1447			
Big Lime			1447	1565			
Injun			1565	1612			
Slate			1612	1618			
Total depth			1618'				

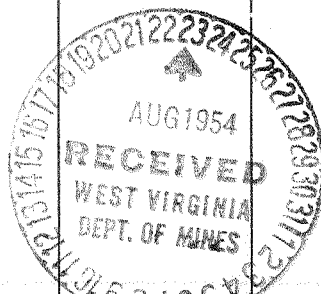

JAN 23 1955

