


Latitude 38° 30'

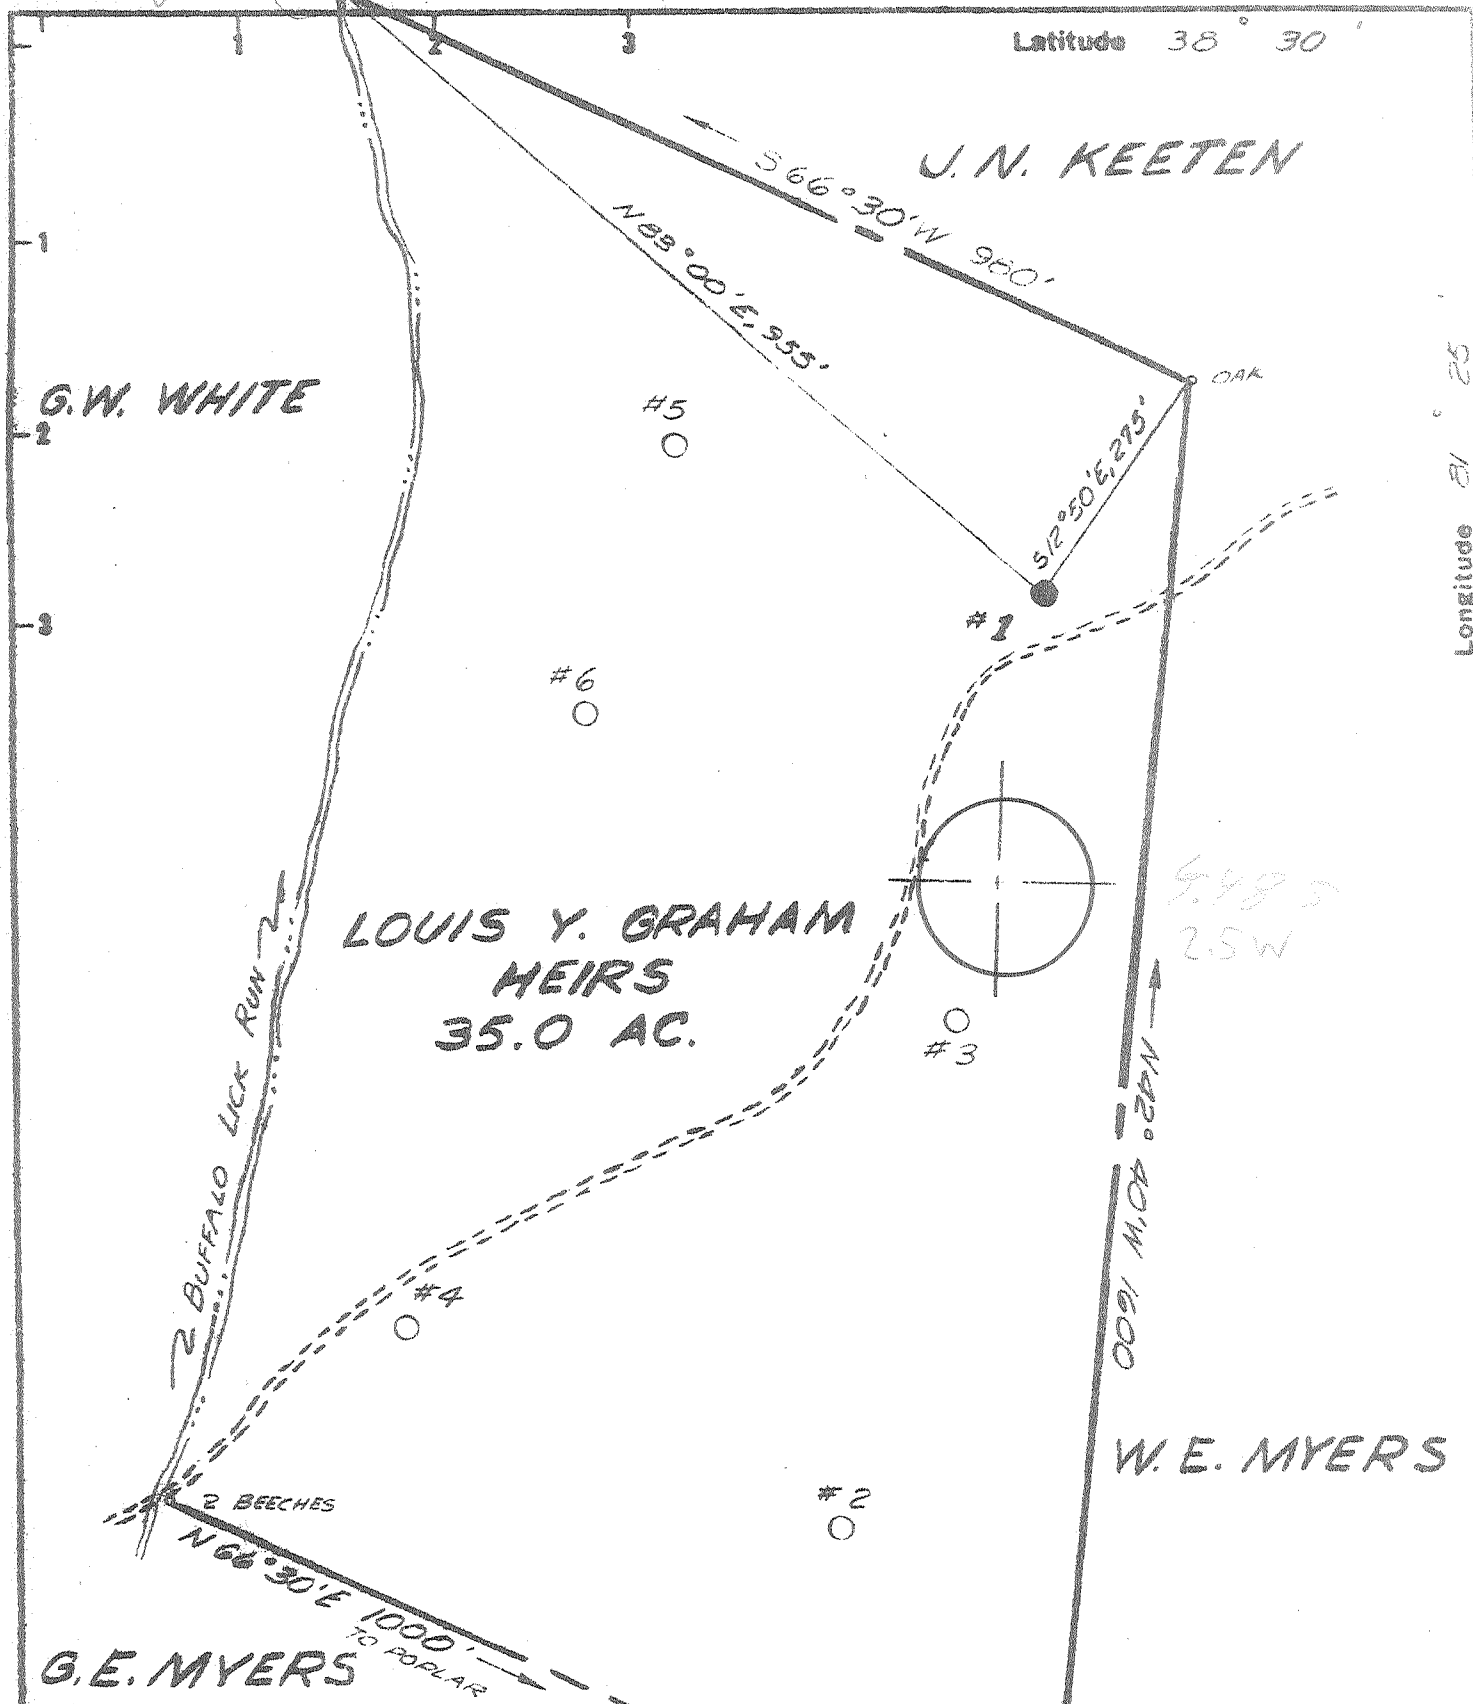

LOUIS Y. GRAHAM HEIRS
35.0 AC.

G.E. MYERS

W.E. MYERS

Minimum Error of Closure 1 IN 200
Source of Elevation _____

- New Location
- Drill Deeper
- Abandonment

"I, the undersigned, hereby certify that this map is correct to the best of my knowledge and belief and shows all the information required by paragraph 6 of the rules and regulations of the oil and gas section of the mining laws of West Virginia."

dated 12/23/48

Company W.D. FRAME
 Address P.O. Box 263, ELKVIEW W.V. 25071
 Farm LOUIS Y. GRAHAM HEIRS
 Tract _____ Acres 35.0 Lease No. _____
 Well (Farm) No. 1 Serial No. _____
 Elevation (Spirit Level) 750.63
 Quadrangle GLENDENNIN NW
 County KANAWHA District EIK
 Engineer L.F. DYE
 COPY OF ORIGINAL PLAT
 Engineer's Registration No. 804
 File No. _____ Drawing No. _____
 Date 2-17-48 Scale 1" = 200'

STATE OF WEST VIRGINIA
DEPARTMENT OF MINES
OIL AND GAS DIVISION
CHARLESTON

WELL LOCATION MAP
FILE NO. KAN-1445-A

+ Denotes location of well on United States Topographic Maps, scale 1 to 62,500 latitude and longitude lines being represented by border lines as shown.

- Denotes one inch spaces on border line of original tracing.

47-039