


LATITUDE 38° 30'

LONGITUDE 81° 20'

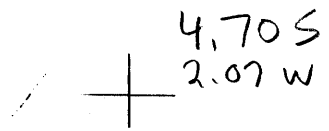

7'5 OGIS topo location

7.5' loc \_\_\_\_\_ 15' loc \_\_\_\_\_  
 \_\_\_\_\_ (calc.) \_\_\_\_\_

Company Ohio Fuel  
 Farm G G Reynolds 2  
 Quad Clendenin 15'  
 County Kanawha  
 District Big Sandy

WELL LOCATION MAP  
 File No. 40773 70800  
#804 in 1914 WV6E5  
 Kanawha County Report

## G. G. Reynolds No. 2 Well Record (804).

Located in Big Sandy district on divide between Falling Rock and Leatherwood creeks, 3.2 miles south of Reamer station. Authority, Ohio Fuel Oil Company. Completed, March 12, 1913. Elevation 1105' A. T. B.

	Thickness Feet.	Total Feet.
Slate .....	10	10
Sand .....	60	70
Slate .....	30	100
Sand .....	75	175
Slate .....	10	185
Sand and shells.....	375	560
Coal, Winifrede?.....	5	565
Sand .....	195	760
Black lime and slate.....	60	820
Sand .....	100	920
Slate .....	5	925
Lime and sand.....	35	960
Salt sand.....	510	1470
Red rock.....	10	1480
Lime .....	40	1520
Red rock.....	32	1552
Lime and sand.....	123	1675
Slate .....	5	1680
Little Lime.....	30	1710
Slate and shells.....	25	1735
Pencil cave.....	4	1739
Big lime.....	180	1919
Red sand.....	117	2036
White sand, "Weir".....	95	2131
Oil sand.....	7	2138
Total depth.....		2146
Oil Well in Weir sand.		

In the eastern part of Big Sandy district, on Morris creek, several wells have recently been drilled by the Raven Carbon Company on property of King Land Company.

## King Land Company No. 3 Well Record (657).

Located in Big Sandy district on East fork of Morris creek, 1.5 miles southeast of Turner. Authority, Raven Carbon Company; completed April 4, 1913. Elevation 820' A. T. B.

	Thickness Feet.	Total Feet.
Conductor .....	15	15
Unrecorded .....	30	45
Lime .....	25	70
Coal, Stockton-Lewiston.....	5	75
Sand .....	60	135
Slate .....	10	145
Sand .....	20	165