


Latitude 39° 45'

Longitude 80° 20'

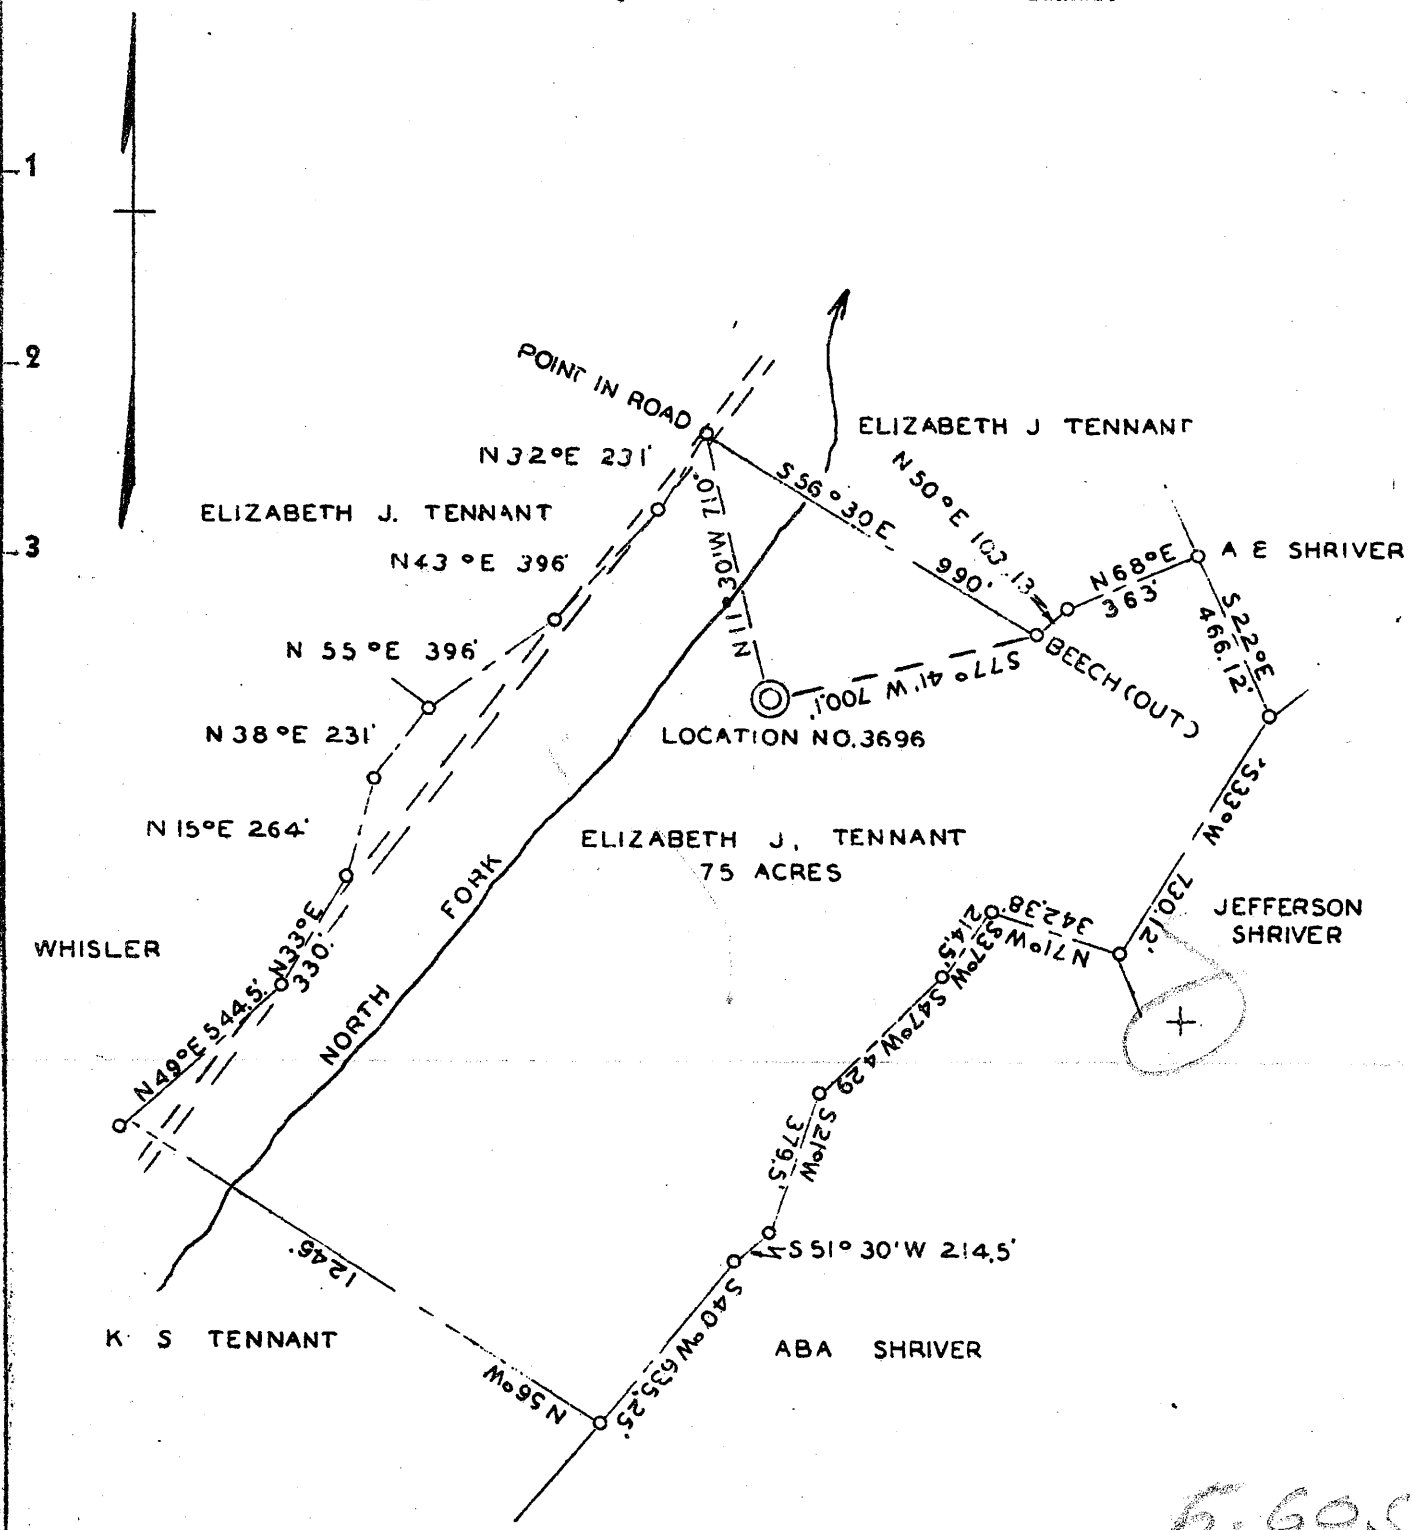

5.605  
1.630

COAL OWNED BY ELIZABETH J. TENNANT

- New Location:
- Drill Deeper:
- Abandonment:

INV MAP P-26-8

Company THE MANUFACTURERS LIGHT AND HEAT CO.  
 Address 800 UNION TRUST BLDG. PITTSBURGH, PA.  
 Farm ELIZABETH J. TENNANT  
 Tract \_\_\_\_\_ Acres 75 Lease No. 20219  
 Well (Farm) No. 1 Serial No. 3696  
 Elevation (Spirit Level) 1102.23'  
 Quadrangle MANNINGTON N. E.  
 County MONONGALIA District BATTELLE  
 Engineer DONALD K. BELL  
 Engineer's Registration No. \_\_\_\_\_  
 File No. BK.16 PG.67 Drawing No. Y-10-895  
 Date APRIL 21, 1943 Scale 1" = 500'

STATE OF WEST VIRGINIA  
 DEPARTMENT OF MINES  
 OIL AND GAS DIVISION  
 CHARLESTON  
 WELL LOCATION MAP  
 File No. MON-155

+ Denotes location of well on United States Topographic Maps, scale 1 to 62,500, latitude and longitude lines being represented by border lines as shown.  
 - Denotes one inch spaces on border line of original tracing.



WEST VIRGINIA DEPARTMENT OF MINES  
OIL & GAS DIVISION  
W E L L R E C O R D

Permit No. Mon 155				Gas Well
Mannington Quad.				CASING & TUBING
Company	The Mfrs. Light & Heat Co.			
Address	800 Union Trust Bldg., Pittsburgh, Pa.			
Farm	Elizabeth J. Tennant	Acres 75	10	217'5 Same
Location	--		8 1/2	1403'3 "
Well No	1- 3696	Elev. 1102	6 5/8	2164'8 "
District	Battolle	Monongalia County		
Surface	Elizabeth J. Tennant, R.D. #1, Burton, W.Va.			? Packer
Mineral	The Mfrs. Light & Heat Co, 800 Union Trust Bldg., Pittsburgh, Pa.			Coal 906' 72"
Commenced	7-7-43			
Completed	8-25-43			
Open flow	22/10ths W in 1 1/2"			
Volume	82717 G.F.			
Rock Pressure	280 lbs. 48 hrs.			
Fresh Water	90'			

Soil	0	50	30' Sand	2938	2961
Red Rock	50	60	Slate & Lime	2961	2980
Slate & Lime	60	445	Red Rock	2980	2985
Slate & Shell	445	515	Gordon Stray	2985	3038
Sand	515	555	Pink Rock	3038	3041
Slate & Lime	555	600	Gordon Sand	3041	3095
Sand	600	652	Slate	3095	3100
Slate & Lime	652	700	4th Sand	3100	3134
Red Rock	700	705	Slate	3134	3153
Lime	705	808	5th Sand	3153	3184
Slate	808	814	Slate & Lime	3184	3438
Lime	814	890	TOTAL DEPTH		3438
Slate	890	906			
- Pitts. Coal	906	912 -	S.L. 2147		
Lime	912	945	Gas 2211-2219 S.L. 2214		
Sand	945	955	Show of gas 3156-3158		
Shells	955	980	Gas at 3293		
Lime & Slate	980	1010			
Sand	1010	1072			
Slate & Lime	1072	1090			
Red Rock	1090	1095			
Slate	1095	1105			
Red Rock	1105	1108			
Lime	1108	1112			
Red Rock	1112	1120			
Slate & Lime	1120	1190			
Red Rock	1190	1200			
Slate, Shell, Lime	1200	1314			
Sand	1314	1330			
Lime & Slate	1330	1385			
Big Dunkard	1385	1404			
Slate & Lime	1404	1445			
Sand	1445	1497	<i>upper Freeport ss</i>		
Lime, Slate, Shells	1497	1585			
Gas Sand	1585	1680			
Slate & Shells	1680	1730			
Sand	1730	1768			
Slate, Lime, Shell	1768	1895			
Sand	1895	1915			
Slate & Shell	1915	1945			
Lime	1945	2008			
Red Rock	2008	2030			
Lime & Slate	2030	2105			
Big Lime	2105	2200			
Big Injun	2200	2412			
Slate	2412	2440			
Lime & Shells	2440	2700			
Sand	2700	2765	<i>Murrysville</i>		
Gritty Lime	2765	2838			
Slate	2838	2845			
50' Sand	2845	2920			
Slate	2920	2938			