

New Location
 Drill Deeper
 Abandonment

Company Uffington Gas Company
 Address Uffington, W. Va.
 Farm Geo. W. Price Farm
 Tract Acres 67 1/4 Lease No.
 Well (Farm) No. 1 Serial No.
 Elevation (Spirit Level) 1048 (ft.)
 Quadrangle Morgantown SW
 County Monongalia District Clinton
 Engineer C. R. Duncan
 Engineer's Registration No. 315
 File No. Drawing No.
 Date Nov. 12 1958 Scale 1" = 40 P

STATE OF WEST VIRGINIA
 DEPARTMENT OF MINES
 OIL AND GAS DIVISION
 CHARLESTON

WELL LOCATION MAP
 FILE NO. MON-238

+ Denotes location of well on United States Topographic Maps, scale 1 to 62,500, latitude and longitude lines being represented by border lines as shown.

- Denotes one inch spaces on border line of original tracing.



STATE OF WEST VIRGINIA
DEPARTMENT OF MINES
OIL AND GAS DIVISION 7

Quadrangle Morgantown

Permit No. Mon-238

WELL RECORD

Oil or Gas Well Gas
(KIND)

Company Uffington Gas
Address Box 870, Morgantown, W. Va.
Farm Geo. W. Price Acres 67 1/2
Location (waters) Booths Creek
Well No. 1 Elev. 1048
District Clinton County Monongalia
The surface of tract is owned in fee by Geo. W. Price
Address _____
Mineral rights are owned by Geo. W. Price W. Va. _____
Address R.D. #1, Morgantown
Drilling commenced 12/27/58
Drilling completed 1/26/59
Date Shot 1/29/59 From 1072 To 1092
With 10 qt Nitroglycerine
Open Flow 20 /10ths Water in 1/4 Inch
_____/10ths Merc. in _____ Inch
Volume 2,191 cu ft Cu. Ft.
Rock Pressure _____ lbs. _____ hrs.
Oil _____ bbls., 1st 24 hrs.
WELL ACIDIZED _____
WELL FRACTURED _____


Casing and Tubing	Used in Drilling	Left in Well	Packers
Size			Kind of Packer <u>None</u>
16			<u>6" Seton steel shoe</u>
13			<u>8" Seton collar</u>
10	<u>41'-6"</u>	<u>41'-6"</u>	Size of <u>10" seton threads</u>
8 3/4	<u>333'-1"</u>	<u>333'-1"</u>	Depth set _____
6 3/8	<u>1014'-8"</u>	<u>1014'-8"</u>	Perf. top _____
5 3/16			Perf. bottom _____
3			Perf. top _____
2			Perf. bottom _____
Liners Used			

CASING CEMENTED None SIZE _____ No. Ft. _____ Date _____
COAL WAS ENCOUNTERED AT 206 FEET Blossom INCHES
374 FEET 12" INCHES FEET INCHES
FEET INCHES FEET INCHES

RESULT AFTER TREATMENT

ROCK PRESSURE AFTER TREATMENT _____
Fresh Water 25 Hole full Feet 75-3-10" bailers Fresh per hr. Salt Water 575+ hole full at 600 Feet

Formation	Color	Hard or Soft	Top	Bottom	Oil, Gas or Water	Depth	Remarks
Sand	Yellow	Soft	0	5			
Lime	Grey	Hard	5	20			
Red rock	Red	Soft	20	35	Water	25	Hole full & run over top.
Slate	Grey	Soft	40	61			
Sand	Blue	Soft	61	122	Water	75	3-10" bailers per hr.
Slate	Blue	Soft	122	130			
Red Rock	Red	Soft	130	136			
Slate & Lime shells	Grey	Medium	136	157			
Lime	Grey	Hard	157	175			
Slate & lime shells	Grey	Medium	175	206			
Gritty lime	Grey	Hard	206	213			
Blossom of coal	at 206						
Sand	Grey	Hard	213	248			
Slatu	Grey	Soft	248	255			
Gritty lime	Grey	Hard	255	345			
Slate & lime shells	Grey	Medium	345	374			
Coal, bony	Black	Soft	374	375	Smell of gas in coal; coal was mixed with slate.		
A. Sand	White	Medium	375	455			
Slate & shells	Grey	Medium	455	473			
B. Sand	White	Medium	473	510			
Slate	Blue	Soft	510	520			
Shale & shells	Grey	Medium	520	526			

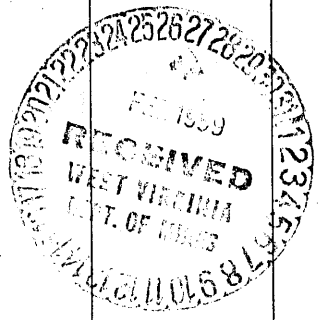

Formation	Color	Hard or Soft	Top ⁷	Bottom	Oil, Gas or Water	Depth Found	Remarks
Lime	Grey	Hard	526	532			
Sand	White	Medium	532	551			
Slate	Grey	Medium	551	565			
Sand	White	Medium	565	650	Fresh water	575	
					Fresh water	600	- - - Hole full
Slate	Grey	Soft	650	665			
Slate	Black	Soft	666	686			
Sand	Grey	Hard	686	710			
Slate	Grey	Soft	710	718			
Red Rock	Red	Soft	718	726			
Lime	Grey	Hard	726	736			
Red rock	Red	Soft	736	748			
Slate & shells	Grey	Medium	748	770			
Lime	Grey	Medium	770	831			
Gritty lime	Grey	Medium	831	855		1053	
Slate	Grey	Soft	855	865			
Lime	Grey	Top <u>Hard</u>	865	873			
Slate	Blue	Soft	873	878			
Lime	Grey	Hard	878	890			
Red Rock	Red	Soft	890	900			
Slate	Grey	Soft	900	925			
Lime	Grey	Hard	925	935			
Slate	Grey	Soft	935	943			
Red rock	Red	Soft	943	948			
Slate	Grey	Medium	948	956			
Little Lime	Grey	Hard	956	960			
Slate	Grey	Soft	960	965			
Big Lime	Grey	Medium	965	1048			
Red Lime & Blue Shale		Medium	1048	1053			
Injun Sand	Grey	Medium	1053	1144	Gas	1077 to 1081	10/10 water 1/8" 387 cu.ft.
Sand & slate	Dark Grey	Medium	1144	1175			
Slate & shells	Dark Grey	Medium	1175	1240			
Gritty lime	Dark Grey	Hard	1240	1250	Shot with 10 qt. in 20 ft. & increased gas to 20/10 water 1/4" or 2,191 cu. ft.		
Squaw Sand	Dark Grey	Medium	1250	1290			
Slate	Grey	Soft	1290	1293			
Sand	Grey	Medium	1293	1308			
Slate	Dark Grey	Soft	1308	1310			
<u>TOTAL DEPTH</u>			<u>1310 FT.</u>				

Date 2/3/59, 19

APPROVED H. Wilson, Owner

By Contractor (Title)