

61 00367 P

WW-7
8-30-06



West Virginia Department of Environmental Protection
Office of Oil and Gas
WELL LOCATION FORM: GPS

API: 47-061-00367 WELL NO.: 7145

FARM NAME: Miller

RESPONSIBLE PARTY NAME: Erika Whetstone

COUNTY: Monongalia DISTRICT: Clinton

QUADRANGLE: Gladesville

SURFACE OWNER: Howard J. and Bonnie J. Trickett

ROYALTY OWNER: _____

UTM GPS NORTHING: 4,369,793.518 METERS

UTM GPS EASTING: 594,168.856 METERS GPS ELEVATION: 569.970 METERS (1870')

The Responsible Party named above has chosen to submit GPS coordinates in lieu of preparing a new well location plat for a plugging permit or assigned API number on the above well. The Office of Oil and Gas will not accept GPS coordinates that do not meet the following requirements:

- Datum: NAD 1983, Zone: 17 North, Coordinate Units: meters, Altitude: height above mean sea level (MSL) – meters.
- Accuracy to Datum – 3.05 meters
- Data Collection Method:
Survey grade GPS : Post Processed Differential
Real-Time Differential _____
Mapping Grade GPS _____ : Post Processed Differential _____
Real-Time Differential _____

RECEIVED
Office of Oil and Gas
AUG 23 2017
WV Department of Environmental Protection

4. Letter size copy of the topography map showing the well location.


I the undersigned, hereby certify this data is correct to the best of my knowledge and belief and shows all the information required by law and the regulations issued and prescribed by the Office of Oil and Gas.

Erika Whetstone
Signature

Permitting Supervisor
Title

8/14/17
Date

09/15/2017

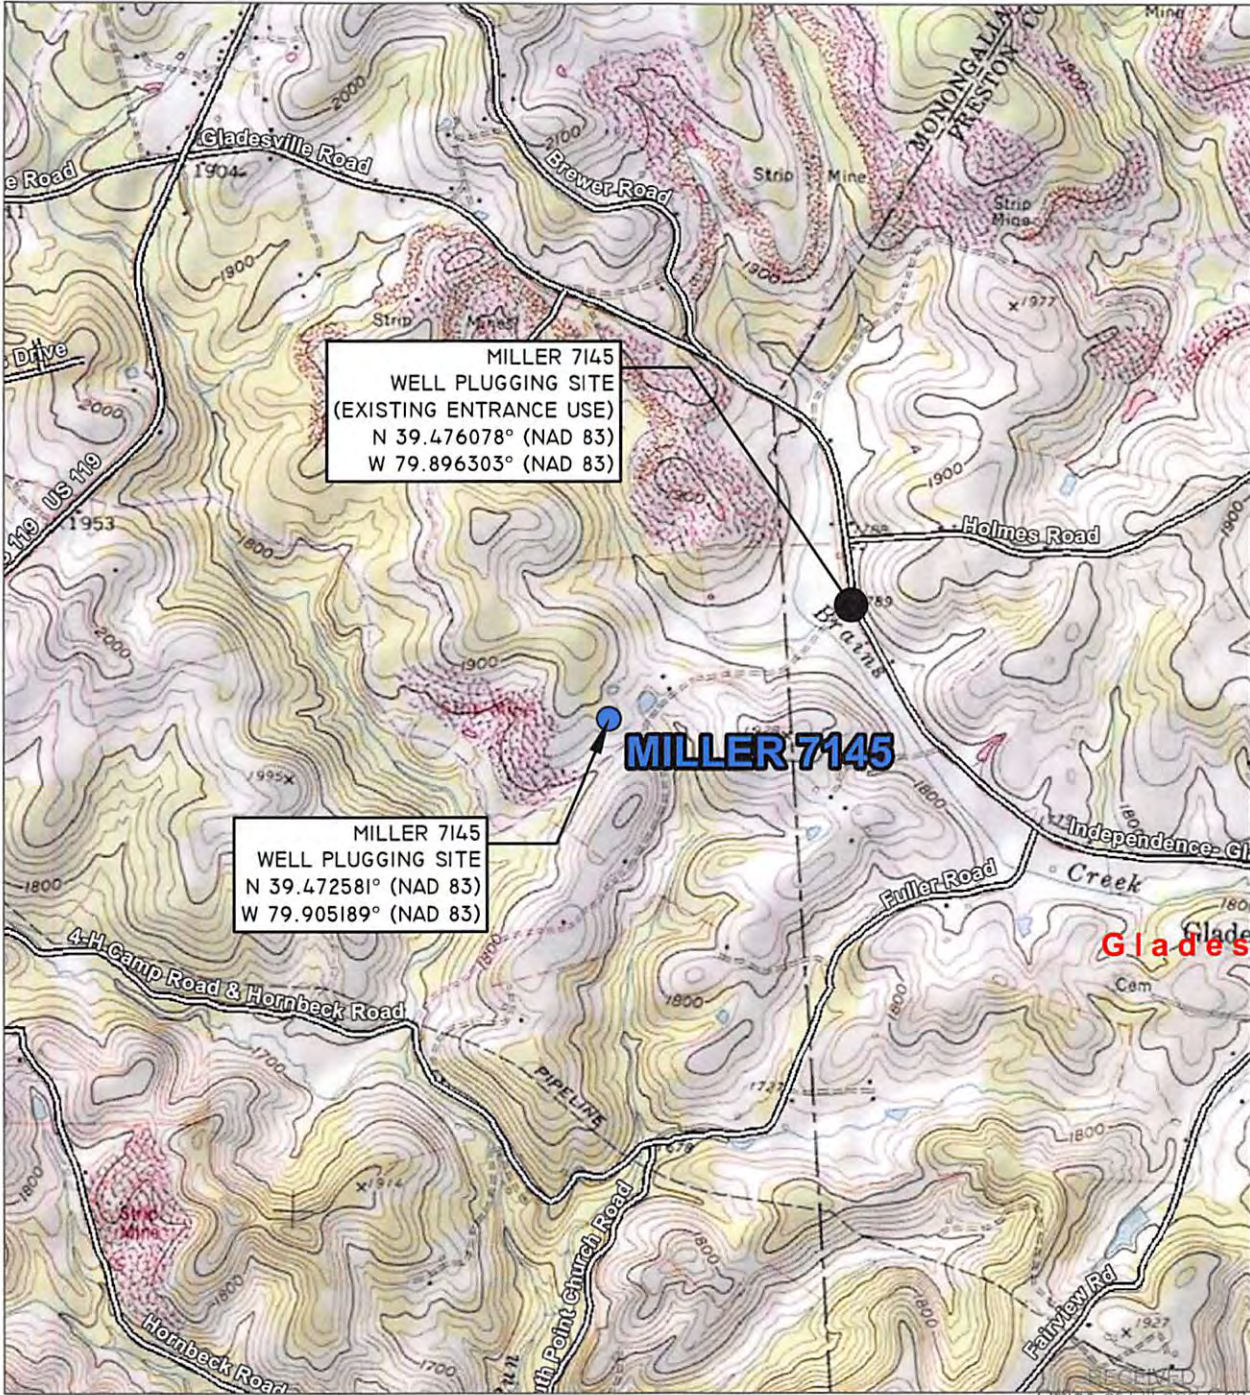

MILLER 7145
WELL PLUGGING SITE
(EXISTING ENTRANCE USE)
N 39.476078° (NAD 83)
W 79.896303° (NAD 83)

MILLER 7145
WELL PLUGGING SITE
N 39.472581° (NAD 83)
W 79.905189° (NAD 83)

MILLER 7145

Office of Oil and Gas

LOCATION MAP
GLADESVILLE, WV 7.5M USGS QUADRANGLE
SCALE: 1"=2000'

AUG 23 2017



WV Department of
Environmental Protection

Blue Mountain Inc.
Engineers and Land Surveyors
Woman Owned Small Business
11023 Mason Dixon Hwy.
Burton, WV 26562-9656
(304) 662-6486

LOCATION MAP
GAS WELL PLUGGING
MILLER 7145 GAS WELL
CLINTON DISTRICT
MONONGALIA COUNTY, WV
CONSOL GAS COMPANY
200 HALLAM ROAD
WASHINGTON, PA 15301

DRAWN BY: LLF
CHECKED BY: WPF
DATE: 06/06/2017
SCALE: 1"=2000'
WATERSHED: HEADWATERS THREE FORK CREEK
PAGE 4 OF 4