



West Virginia Department of Environmental Protection
Office of Oil and Gas
WELL LOCATION FORM: GPS

API: 47-061-00394 WELL NO.: 7029
FARM NAME: W. L. TENNANT
RESPONSIBLE PARTY NAME: CNX GAS COMPANY LLC
COUNTY: MONONGALIA DISTRICT: CLAY 3
QUADRANGLE: BLACKSVILLE 7.5 MIN. 250
SURFACE OWNER: W. L. TENNANT, J. A. MOORE
ROYALTY OWNER: ALBERT D. JONES, ET. AL.
UTM GPS NORTHING: 4,392,296.21 METERS
UTM GPS EASTING: 571,095.980 METERS GPS ELEVATION: 360.198 METERS

The Responsible Party named above has chosen to submit GPS coordinates in lieu of preparing a new well location plat for a plugging permit on the above well. The Office of Oil and Gas will not accept GPS coordinates that do not meet the following requirements:

1. Datum: NAD 1983, Zone: 17 Coordinate Units: meters Altitude: Height above mean sea level (MSL) - meters
2. Accuracy to Datum - 3.05 meters
3. Data Collection Method: Survey Grade GPS : Post Processed Differential Real-Time Differential
Mapping Grade GPS : Post Processed Differential Real-Time Differential

I the undersigned hereby state this data is correct to the best of my knowledge and belief and shows all the information required by law and the regulation issued and prescribed by the Office of Oil and Gas.


Signature J. Michael Evans
J. MICHAEL EVANS, PS

Title WV Professional Surveyor #900

Date July 31, 2014



CNX USE: NAD 27 WV NORTH SPC: 7029 = 429,561.47' 1,811,080.88' ELEV. = 1,181.75'

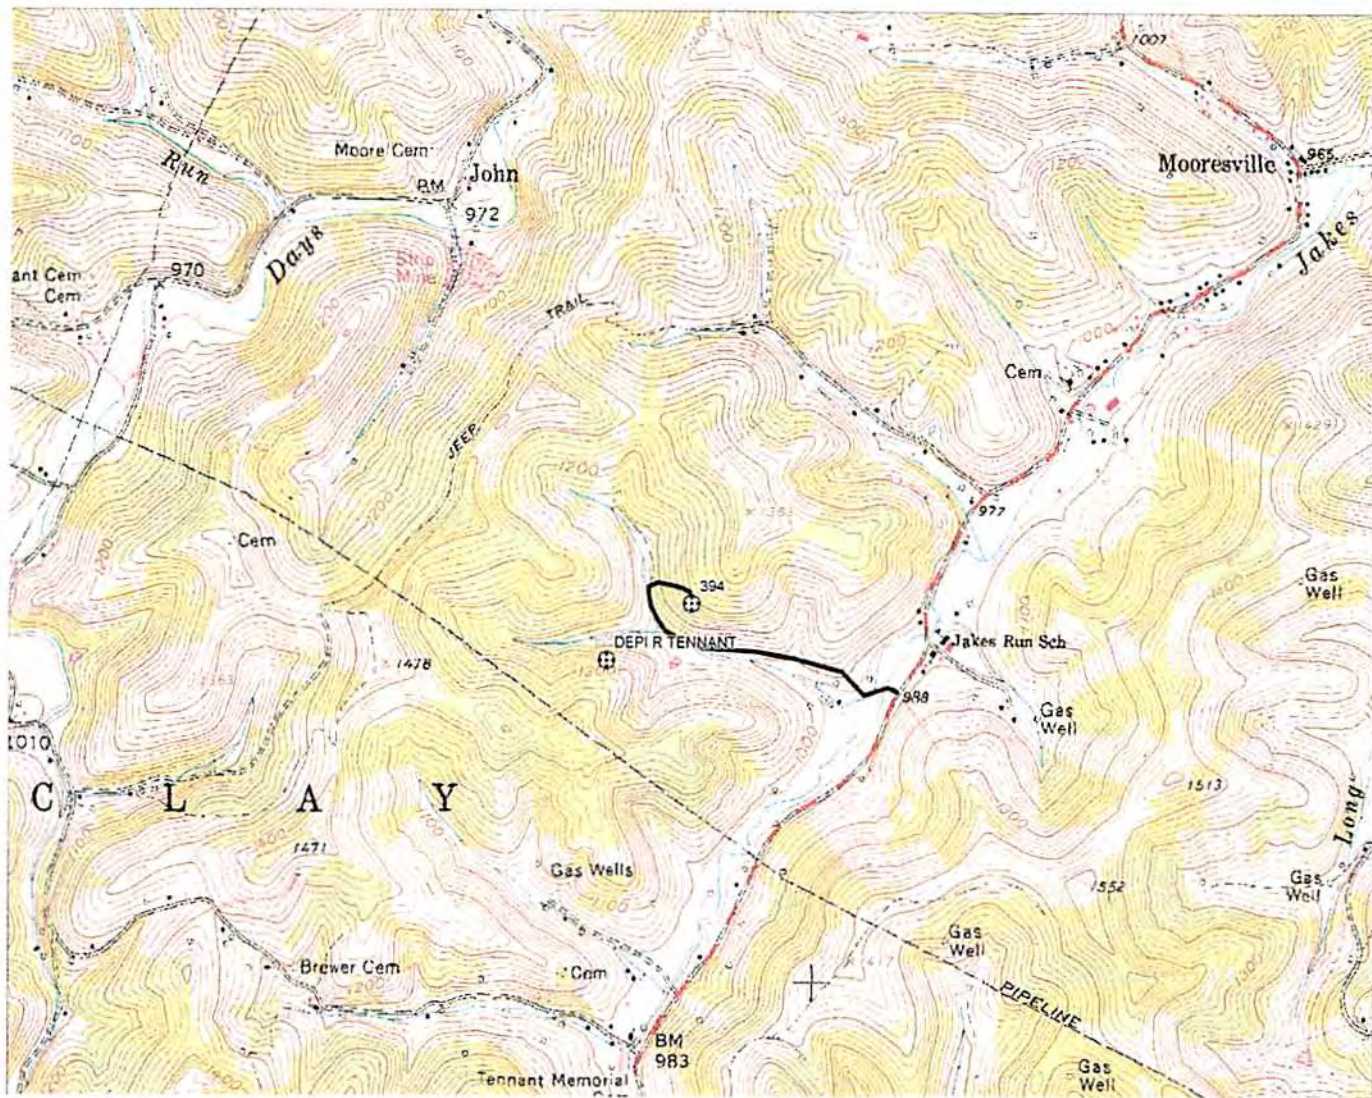

Handwritten:
 Harold Kut
 8/20/14

NORTH

SURFACE OWNER:

W. L. TENNANT, ET. AL.
 C/O ALBERT D. JONES
 248 LONG DRAIN ROAD
 CORE, WV 26529

ADDITIONAL CONTACTS:

DEB. & GEORGE STREET
 1340 JAKES RUN ROAD
 FAIRVIEW, WV 26570
 304-290-8670

DRAWINGS TO ACCOMPANY FORM WW-9

_____ CNX Gas Company LLC

_____ P. O. Box 1248

_____ Jane Lew, WV 26378

WATERSHED: _____ JAKES RUN

DISTRICT: _____ CLAY _____ CO. _____ MONONGALIA

QUAD.: _____ BLACKSVILLE _____ O.W.N. _____ 7029

DATE: _____ JULY 31, 2014 _____ PG. _____ OF _____

LAND SURVEYING SERVICES
 21 Cedar Lane
 Bridgeport, WV 26330
 304-842-2018 or 5762