


JUN 22 2026

Northeast Natural
Energy LLC
Proposed Plugging of
DJ EDDY 6 (061-00477)
Clay District
Monongalia County, WV


TOP HOLE (NAD 83)
N) 419096.4
E) 1782217.1
LAT.) 39°38'55.5"
LONG.) 80°09'41.7"
DEC. LAT.) 39.648756
DEC. LONG.) 80.161577

TOP HOLE (NAD 27)
N) 419059.3
E) 1813654.1
LAT.) 39°38'55.2"
LONG.) 80°09'42.4"
DEC. LAT.) 39.648675
DEC. LONG.) 80.161783

TOP HOLE (UTM NAD 83)
N) 4389109.6
E) 571933.3

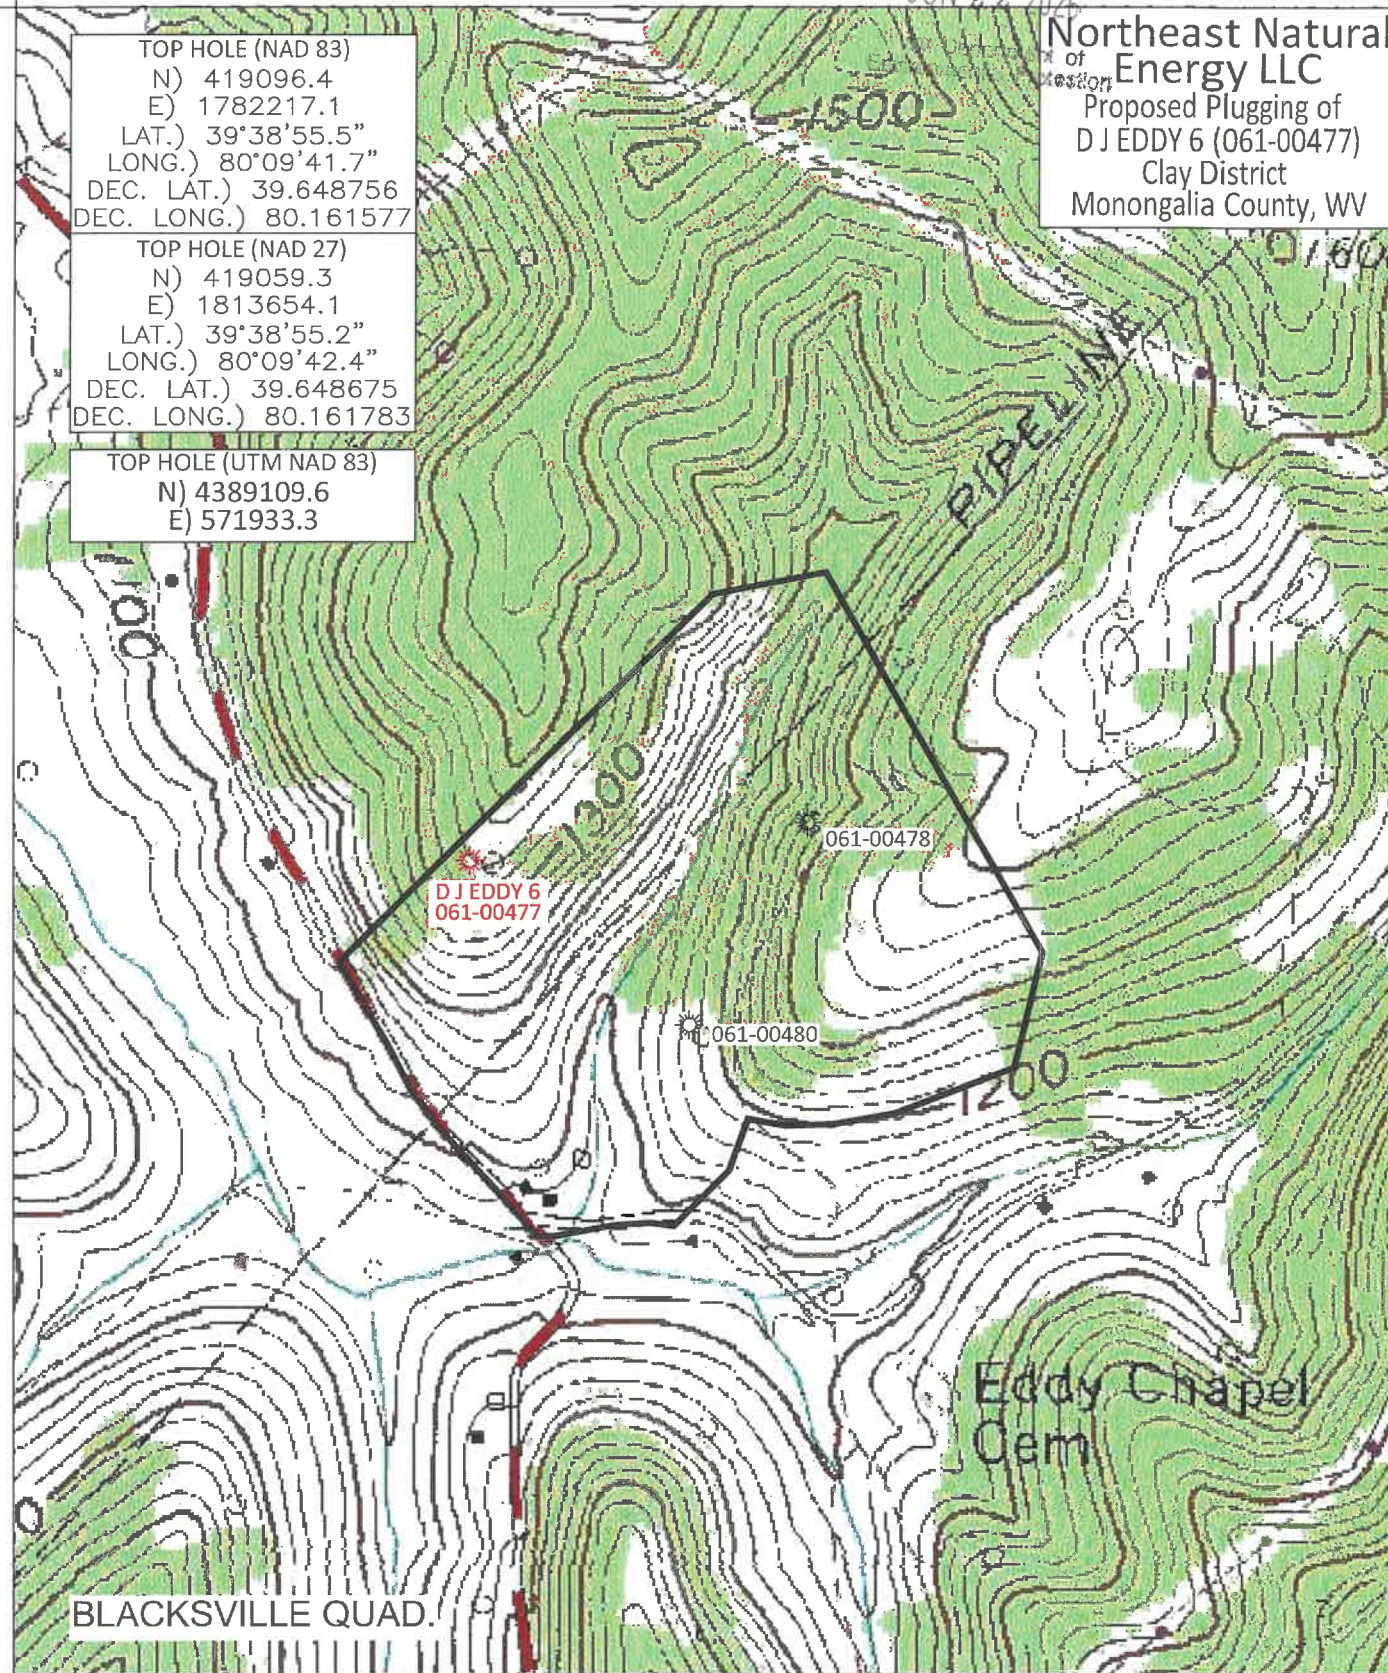

BOORD, BENCHEK and ASSOC., INC.
Engineering, Surveying, Construction,
and Mining Services
Southpointe, PA 15317 Phone: 724-746-1055

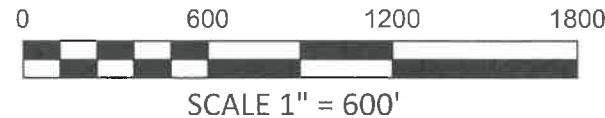

MAY 22, 2023

08/21/2026



West Virginia Department of Environmental Protection
Office of Oil and Gas

WELL LOCATION FORM: GPS

API: 47 061 00477 WELL NO.: 6
FARM NAME: DJ Eddy
RESPONSIBLE PARTY NAME: NNE Resources LLC
COUNTY: Monongalia DISTRICT: Clay
QUADRANGLE: Blacksville
SURFACE OWNER: James P Cummins and Nancy Ann Cummins
ROYALTY OWNER: Emory Peak Minerals, LLC, Et al.
UTM GPS NORTHING: 4389109.6
UTM GPS EASTING: 571933.3 GPS ELEVATION: 1338'

The Responsible Party named above has chosen to submit GPS coordinates in lieu of preparing a new well location plat for a plugging permit or assigned API number on the above well. The Office of Oil and Gas will not accept GPS coordinates that do not meet the following requirements:

1. Datum: NAD 1983, Zone: 17 North, Coordinate Units: meters, Altitude: height above mean sea level (MSL) – meters.
2. Accuracy to Datum – 3.05 meters
3. Data Collection Method:

Survey grade GPS ☒ : Post Processed Differential _____

Real-Time Differential ☒ _____

Mapping Grade GPS _____: Post Processed Differential _____

Real-Time Differential _____

4. Letter size copy of the topography map showing the well location.

I the undersigned, hereby certify this data is correct to the best of my knowledge and belief and shows all the information required by law and the regulations issued and prescribed by the Office of Oil and Gas.

Holl m
Signature

Regulatory Manager
Title

6-8-26
Date

RECEIVED
Office of Oil and Gas
JUN 22 2026
WV Department of
Environmental Protection

08/21/2026