


NORTH

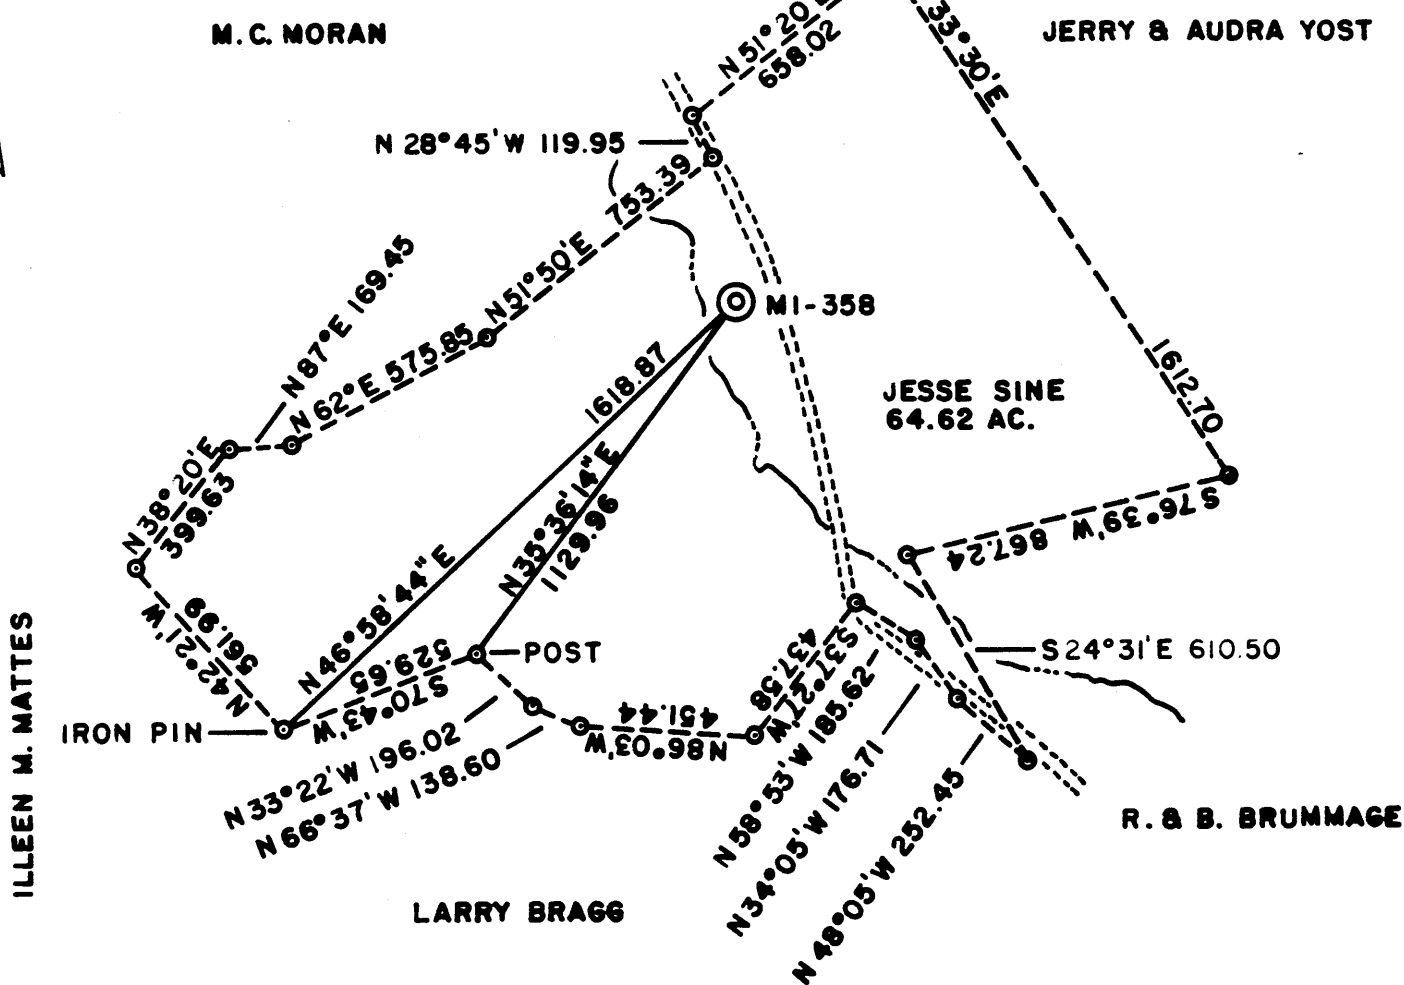


(+) DENOTES LOCATION OF WELL ON UNITED STATES TOPOGRAPHIC MAPS

FILE NO. \_\_\_\_\_  
DRAWING NO. \_\_\_\_\_  
SCALE 1" = 500'  
MINIMUM DEGREE OF ACCURACY 1 IN 5000  
PROVEN SOURCE OF ELEVATION COMPANY SURVEY TIED INTO U.S.G.S. NETWORK

I THE UNDERSIGNED, HEREBY CERTIFY THAT THIS PLAT IS CORRECT TO THE BEST OF MY KNOWLEDGE AND BELIEF AND SHOWS ALL THE INFORMATION REQUIRED BY LAW AND THE REGULATIONS ISSUED AND PRESCRIBED BY THE DEPARTMENT OF MINES.

(SIGNED) R. Nelson McCoy  
R.P.E. \_\_\_\_\_ L.L.S. 119

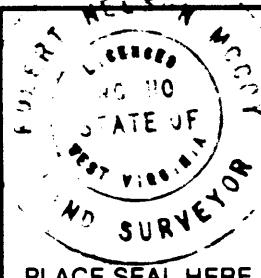

PLACE SEAL HERE

STATE OF WEST VIRGINIA  
DEPARTMENT OF MINES  
OIL AND GAS DIVISION



DATE FEBRUARY 23, 1984  
OPERATOR'S WELL NO. MI-358  
API WELL NO. \_\_\_\_\_

WELL TYPE: OIL \_\_\_ GAS \_\_\_ LIQUID INJECTION \_\_\_ WASTE DISPOSAL \_\_\_ STATE COUNTY PERMIT  
(IF "GAS,") PRODUCTION \_\_\_ STORAGE \_\_\_ DEEP \_\_\_ SHALLOW X ABANDONED X

LOCATION: ELEVATION 1129.24 WATER SHED JAKES RUN  
DISTRICT CLAY COUNTY MONONGALIA  
QUADRANGLE BLACKSVILLE W.V. PA. 7.5 415 WC

SURFACE OWNER JESSE SINE ACREAGE 64.62  
OIL & GAS ROYALTY OWNER UNKNOWN LEASE ACREAGE \_\_\_\_\_

LEASE NO. \_\_\_\_\_  
PROPOSED WORK: DRILL \_\_\_ CONVERT \_\_\_ DRILL DEEPER \_\_\_ REDRILL X FRACTURE OR STIMULATE \_\_\_ PLUG OFF OLD FORMATION \_\_\_ PERFORATE NEW FORMATION \_\_\_ OTHER PHYSICAL CHANGE IN WELL (SPECIFY) \_\_\_\_\_

PLUG AND ABANDON \_\_\_ CLEAN OUT AND REPLUG X  
TARGET FORMATION NONE ESTIMATED DEPTH \_\_\_\_\_

WELL OPERATOR CONSOLIDATION COAL COMPANY DESIGNATED AGENT ROGER E. DUCKWORTH  
ADDRESS P.O. BOX 1314 MORGANTOWN W.V. 26505 ADDRESS P.O. BOX 1314 MORGANTOWN W.V. 26505

OCT 29 1984

STATE OF WEST VIRGINIA  
DEPARTMENT OF MINES  
OIL AND GAS WELLS DIVISION

**RECEIVED**  
MAY 23 1985

**AFFIDAVIT OF PLUGGING AND FILLING WELL** OIL & GAS DIVISION

AFFIDAVIT SHOULD BE MADE IN TRIPPLICATE. ONE COPY MAILED TO THE DEPARTMENT. ONE COPY TO EACH COAL OPERATOR AND THE THIRD COPY (AND EXTRA COPIES IF REQUIRED) SHOULD BE MAILED TO EACH COAL OPERATOR AT THEIR RESPECTIVE ADDRESSES.

Consolidation Coal Company <small>COAL OPERATOR OR OWNER</small> P. O. Box 1314, Morgantown, WV 26507-1314 <small>ADDRESS</small> SAME <small>COAL OPERATOR OR OWNER</small> SAME <small>ADDRESS</small> JESSE SINE <small>LEASE OR PROPERTY OWNER</small> RT.2 , FAIRVIEW, W.VA. <small>ADDRESS</small>	Consolidation Coal Company <small>NAME OF WELL OPERATOR</small> P. O. Box 1314, Morgantown, WV 26507-1314 <small>COMPLETE ADDRESS</small> MAY 21 19 85 <small>WELL AND LOCATION</small> CLAY District MONONGALIA County Well No. M1-358 Farm
---	---

STATE INSPECTOR SUPERVISING PLUGGING DON ELLIS

**AFFIDAVIT**

STATE OF WEST VIRGINIA,  
County of Monongalia } ss:

Larry L. Yost and Ralph Wright  
being first duly sworn according to law depose and say that they are experienced in the work of plugging and filling oil and gas wells and were employed by Consolidation Coal Company well operator, and participated in the work of plugging and filling the above well, that said work was commenced on the 8th day of May, 1985, and that the well was plugged and filled in the following manner:

SAND OR ZONE RECORD	FILLING MATERIAL	PLUGS USED	CASING	
			CSG PULLED	CSG LEFT IN
FORMATION	Clean wellbore to 1520 ft. Ran extra caliper thru coal	SIZE & KIND 8" -	105ft.	?
	No casing; Ran coal protection string as follows; 780 ft. of 4½" casing; 652 ft. of 2 3/8" tubing; Latchdown at 759 ft.; Float valve at 780 ft. Swedge at 780 ft.			
	Circulated cement to surface as follows: 375 sks. of Poz Mix; 675 sks. of expanding type cement ; 1,000 gal. of mud flush.			
	Let set, bailed dry, set monument.			
COAL SEAMS		DESCRIPTION OF MONUMENT		
(NAME) Pittsburgh-		5 ft. of 4½" casing with plaque stating Consol M1-358 47-61-0752-P		
(NAME) 640 Ft.				
(NAME)				
(NAME)				

*Handwritten:* May 5-23-85

and that the work of plugging and filling said well was completed on the 21st day of May, 1985

And further deponents saith not.

Sworn to and subscribed before me this 22 day of May, 1985

*Handwritten signatures:*  
Larry L. Yost  
Ralph Wright  
[Signature]

My commission expires:

June 29, 1987

Notary Public:  
47-61-0752-P