


4706101131P

J.E. Snider #1 LOCATION MAP

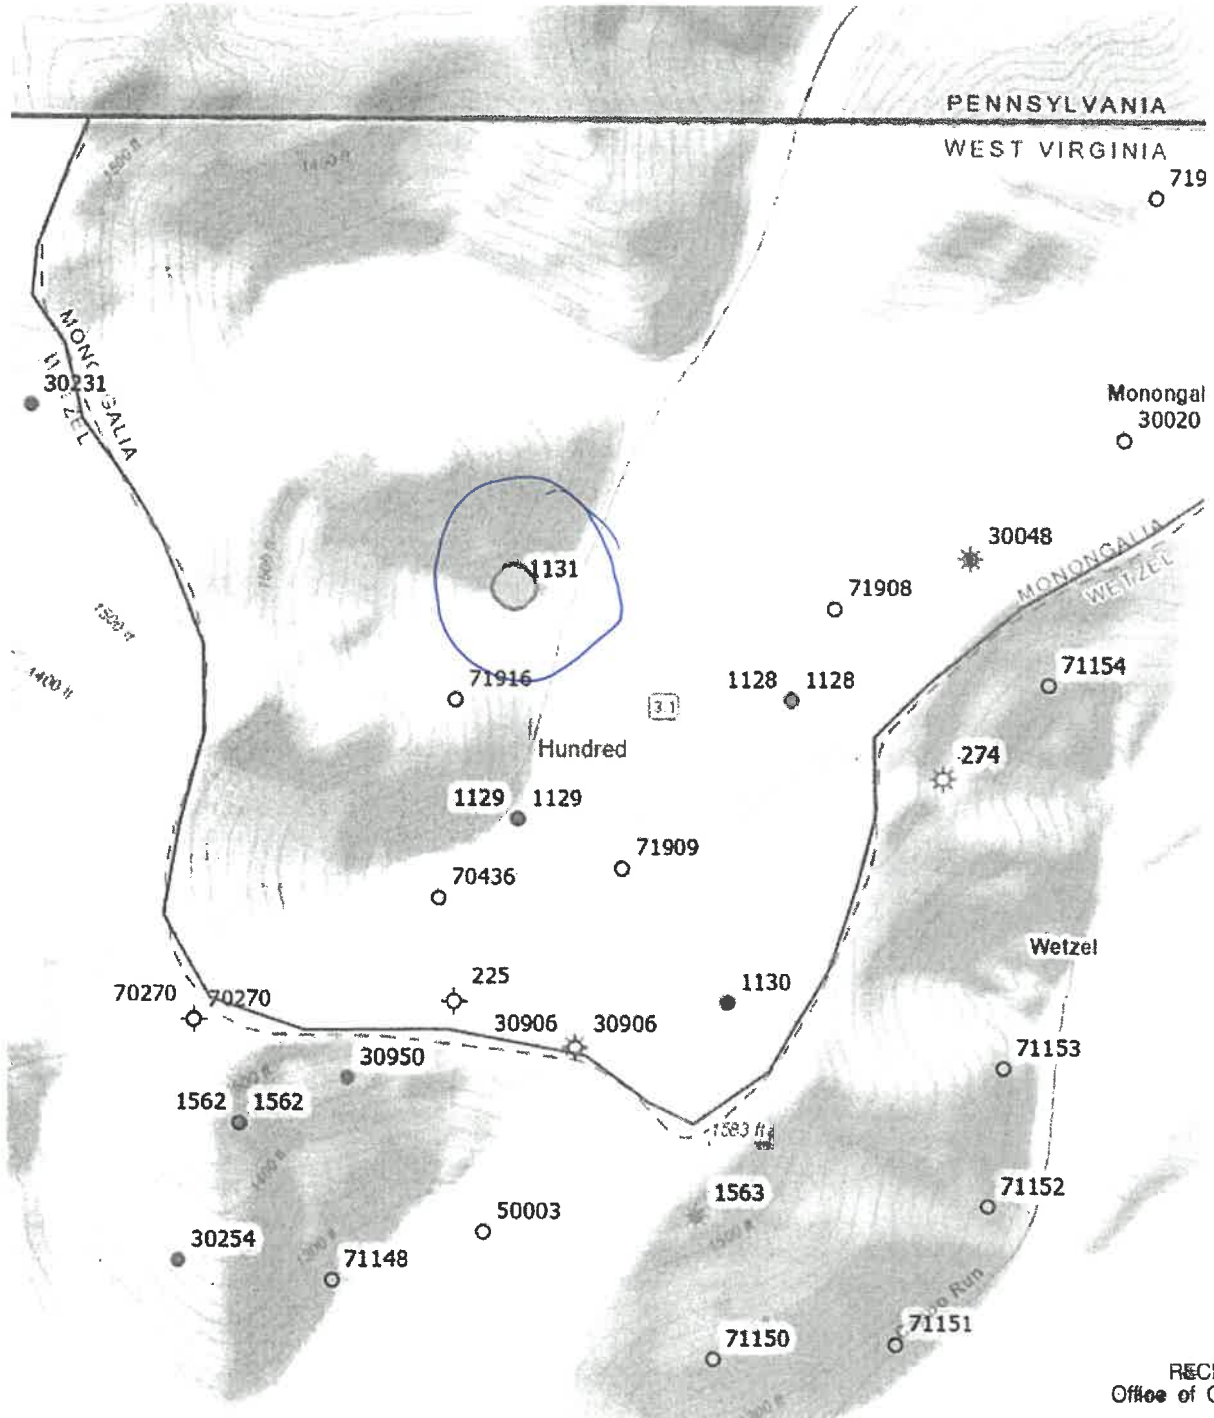

RECEIVED
Office of Oil and Gas

MAY 06 2026

WV Department of
Environmental Protection

06/26/2026

4706101131P

WW-7
8-30-06



West Virginia Department of Environmental Protection
Office of Oil and Gas
WELL LOCATION FORM: GPS

API: 47-061-01131 WELL NO.: J.E. Snider 1
FARM NAME: J.E. Snider
RESPONSIBLE PARTY NAME: Pillar Energy LLC
COUNTY: Monongalia DISTRICT: Battelle
QUADRANGLE: Hundred
SURFACE OWNER: Allan R Shipman
ROYALTY OWNER: Diamond Energy Acqstn Group LLC
UTM GPS NORTHING: 4396477.30
UTM GPS EASTING: 550048.20 GPS ELEVATION: 1342'

The Responsible Party named above has chosen to submit GPS coordinates in lieu of preparing a new well location plat for a plugging permit or assigned API number on the above well. The Office of Oil and Gas will not accept GPS coordinates that do not meet the following requirements:

1. Datum: NAD 1983, Zone: 17 North, Coordinate Units: meters, Altitude: height above mean sea level (MSL) – meters.
2. Accuracy to Datum – 3.05 meters
3. Data Collection Method:

Survey grade GPS ____: Post Processed Differential ____


Real-Time Differential ____

Mapping Grade GPS ____: Post Processed Differential ____

Real-Time Differential ____

4. Letter size copy of the topography map showing the well location.

I the undersigned, hereby certify this data is correct to the best of my knowledge and belief and shows all the information required by law and the regulations issued and prescribed by the Office of Oil and Gas.

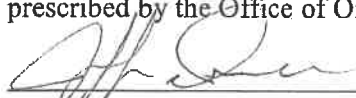
Signature

CEO

Title

3-11-26

Date

RECEIVED
Office of Oil and Gas

MAY 06 2026

WV Department of
Environmental Protection

06/26/2026