

39°40'

LATITUDE

1,050

LONGITUDE 98°06' 02.08"

NORTH

EASTHAM

HARTLEY

CHARLES H. & FRED A PHILLIPS
128.75 ACRES


was George Estel

BREIDING

PRICE

WRIGHT

KING

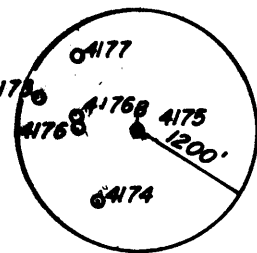

(+) DENOTES LOCATION OF WELL ON UNITED STATES TOPOGRAPHIC MAPS

FILE NO. _____
 DRAWING NO. _____
 SCALE 1" = 600'
 MINIMUM DEGREE OF ACCURACY 1 IN 5000
 PROVEN SOURCE OF ELEVATION COMPANY SURVEY TIED INTO U.S.G.S. NETWORK

I THE UNDERSIGNED, HEREBY CERTIFY THAT THIS PLAT IS CORRECT TO THE BEST OF MY KNOWLEDGE AND BELIEF AND SHOWS ALL THE INFORMATION REQUIRED BY LAW AND THE REGULATIONS ISSUED AND PRESCRIBED BY THE DEPARTMENT OF ENERGY.
 (SIGNED) Paul D. Halbert
 R.P.E. _____ L.L.S. 862

PLACE SEAL HERE

STATE OF WEST VIRGINIA
 DEPARTMENT OF ENERGY
 OIL AND GAS DIVISION



DATE 2-27 1998
 OPERATOR'S WELL NO. 4175
 API WELL NO. _____

WELL TYPE: OIL ___ GAS ___ LIQUID INJECTION ___ WASTE DISPOSAL ___
 (IF "GAS,") PRODUCTION ___ STORAGE ___ DEEP ___ SHALLOW X ABANDONED X
 STATE COUNTY PERMIT

LOCATION: ELEVATION 1404.69 WATERSHED RANGE RUN
 DISTRICT BATTELLE COUNTY MONONGALIA

QUADRANGLE WADESTOWN
 SURFACE OWNER CHARLES H. & FRED A. PHILLIPS ACREAGE 128.75

OIL & GAS ROYALTY OWNER _____ LEASE ACREAGE _____

PROPOSED WORK: DRILL ___ CONVERT ___ DRILL DEEPER ___ REDRILL ___ FRACTURE OR STIMULATE ___ PLUG OFF OLD FORMATION ___ PERFORATE NEW FORMATION ___ OTHER PHYSICAL CHANGE IN WELL (SPECIFY) _____

W00 2709651

PLUG AND ABANDON X CLEAN OUT AND REPLUG _____

JUN 17 1994

TARGET FORMATION NONE ESTIMATED DEPTH _____
 WELL OPERATOR CONSOLIDATION COAL CO. DESIGNATED AGENT ROGER E. DUCKWORTH
 ADDRESS P.O. BOX 1314 MORGANTOWN WV 26505 ADDRESS P.O. BOX 1314 MORGANTOWN W.V. 26505

FORM WW-6 FALLS INC. 00808

COUNTY NAME PERMIT

JAN 18 1996

Permitting
Office of Oil & Gas

AFFIDAVIT OF PLUGGING AND FILLING WELL

AFFIDAVIT SHOULD BE MADE IN TRIPLICATE, one copy mailed to the Division, one copy to be retained by the Well Operator and the third copy (and extra copies if required) should be mailed to each coal operator at their respective addresses.

Consolidation Coal Company
Coal Operator or Owner
P.O. Box 1314, Morgantown, WV 26507-1314
Address

Coal Operator or Owner
Address
Charles Phillips
Lease or Property Owner
Route 1, Box 211, Wadestown, WV
Address

Consolidation Coal Company
Name of Well Operator
P.O. Box 1314, Morgantown, WV 26507-1314
Complete Address

October 07, 19 94
WELL AND LOCATION

Battelle District
Monongalia County

WELL NO. 4175

Charles Phillips Farm

STATE INSPECTOR SUPERVISING PLUGGING

Randal Micko

AFFIDAVIT

STATE OF WEST VIRGINIA,

County of Harrison

SS:

Kevin Wright

and


Glen Andrew Lang

being first duly sworn according to law depose and say that they are experienced in the work of plugging and filling oil and gas wells and were employed by Consolidation Coal Company, well operator, and participated in the work of plugging and filling the above well, that said work was commenced on the 19th day of September 19 94, and that the well was plugged and filled in the following manner:

Sand or Zone Record Formation	Filling Material	Plugs Used Size & Kind	Casing	
			CSG PULLED	CSG LEFT IN
Cleaned hole with 11" bit to and cleaned 7 7/8" hole from casing from 1028' to 1145', left 8" casing in hole from 1145' to bottom. Eight inch 1190'. Cut 8" casing at 1380' casing every 2' thru Pittsburgh Coal 1243, 1241, 1239, 1237, 1235. Cleaned 7 7/8" hole thru Pittsburg Coal 1235, to 1243. Ran coal protection string as follows: 181.80' of 2" tubing followed by 1413.91' from 1623.71' back to surface using 990 sacks of poz mix and 190 sacks of thixotropic cement. Latch down plug at 1407.61'. Float valve at 1441.91'. Swedge at 1442.91'. Cement did curculate. Used 1000 gallons of mud flush. Displaced cement to 1407.61' with water, let set and bailed dry. TOTAL DEPTH 1,655 feet	1028'. Reduced hole to 7 7/8" 1028' to 1655'. Pulled 8" casing cemented from 1145' to 1280, 1180, 1080,. Cut 8" Pittsburgh Coal 1243, 1241, 1239, 1237, 1235. Cleaned 7 7/8" hole thru Pittsburg Coal 1235, to 1243. Ran coal protection string as follows: 181.80' of 2" tubing followed by 1413.91' of 4 1/2" casing. Cemented hole using 990 sacks of poz mix and 190 sacks of thixotropic cement. Latch down plug at 1407.61'. Float valve at 1441.91'. Swedge at 1442.91'. Cement did curculate. Used 1000 gallons of mud flush. Displaced cement to 1407.61' with water, let set and bailed dry. TOTAL DEPTH 1,655 feet			
<u>Coal Seams</u>			<u>Description of Monument</u>	
(Name) <u>Pittsburgh</u>	<u>1235 feet to 1243 feet</u>	<u>5' of 4 1/2" casing with plaque stating: Consolidation Coal Co. Well 4175</u>		
(Name)		<u>Permit #47-061-1162-P</u>		

and that the work of plugging and filling said well was completed on the 4th day of October, 19 94.

And further deponents swear not

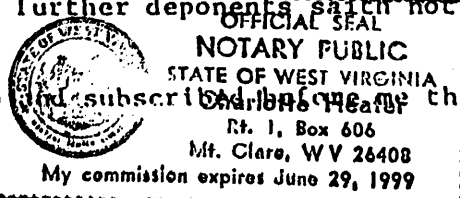

Sworn to and subscribed to before me this

7th day of October, 19 94

Kevin S. Wright
Glen Andrew Lang

Charlotte Heater
Notary Public

My commission expires: June 29, 1999