

6101454CP

WW-7  
8-30-06

RECEIVED  
Office of Oil and Gas

SEP 26 2017

WV Department of  
Environmental Protection



West Virginia Department of Environmental Protection  
Office of Oil and Gas  
**WELL LOCATION FORM: GPS**

API: 47-061-01454 WELL NO.: L114

FARM NAME: Phillips

RESPONSIBLE PARTY NAME: Erika Whetstone

COUNTY: Monongalia DISTRICT: Battelle

QUADRANGLE: Wadestown

SURFACE OWNER: JOHN & SHIRLEY JONES

ROYALTY OWNER: \_\_\_\_\_

UTM GPS NORTHING: 4,388,464.735 meters

UTM GPS EASTING: 556,349.986 meters GPS ELEVATION: 1107.74ft

The Responsible Party named above has chosen to submit GPS coordinates in lieu of preparing a new well location plat for a plugging permit or assigned API number on the above well. The Office of Oil and Gas will not accept GPS coordinates that do not meet the following requirements:

1. Datum: NAD 1983, Zone: 17 North, Coordinate Units: meters, Altitude: height above mean sea level (MSL) – meters.
2. Accuracy to Datum – 3.05 meters
3. Data Collection Method:

Survey grade GPS x: Post Processed Differential X

Real-Time Differential \_\_\_\_\_

Mapping Grade GPS \_\_\_\_\_: Post Processed Differential \_\_\_\_\_

Real-Time Differential \_\_\_\_\_

4. **Letter size copy of the topography map showing the well location.**


I the undersigned, hereby certify this data is correct to the best of my knowledge and belief and shows all the information required by law and the regulations issued and prescribed by the Office of Oil and Gas.

Erika Whetstone  
Signature

Permitting Supervisor  
Title

9/7/17  
Date

10/13/2017

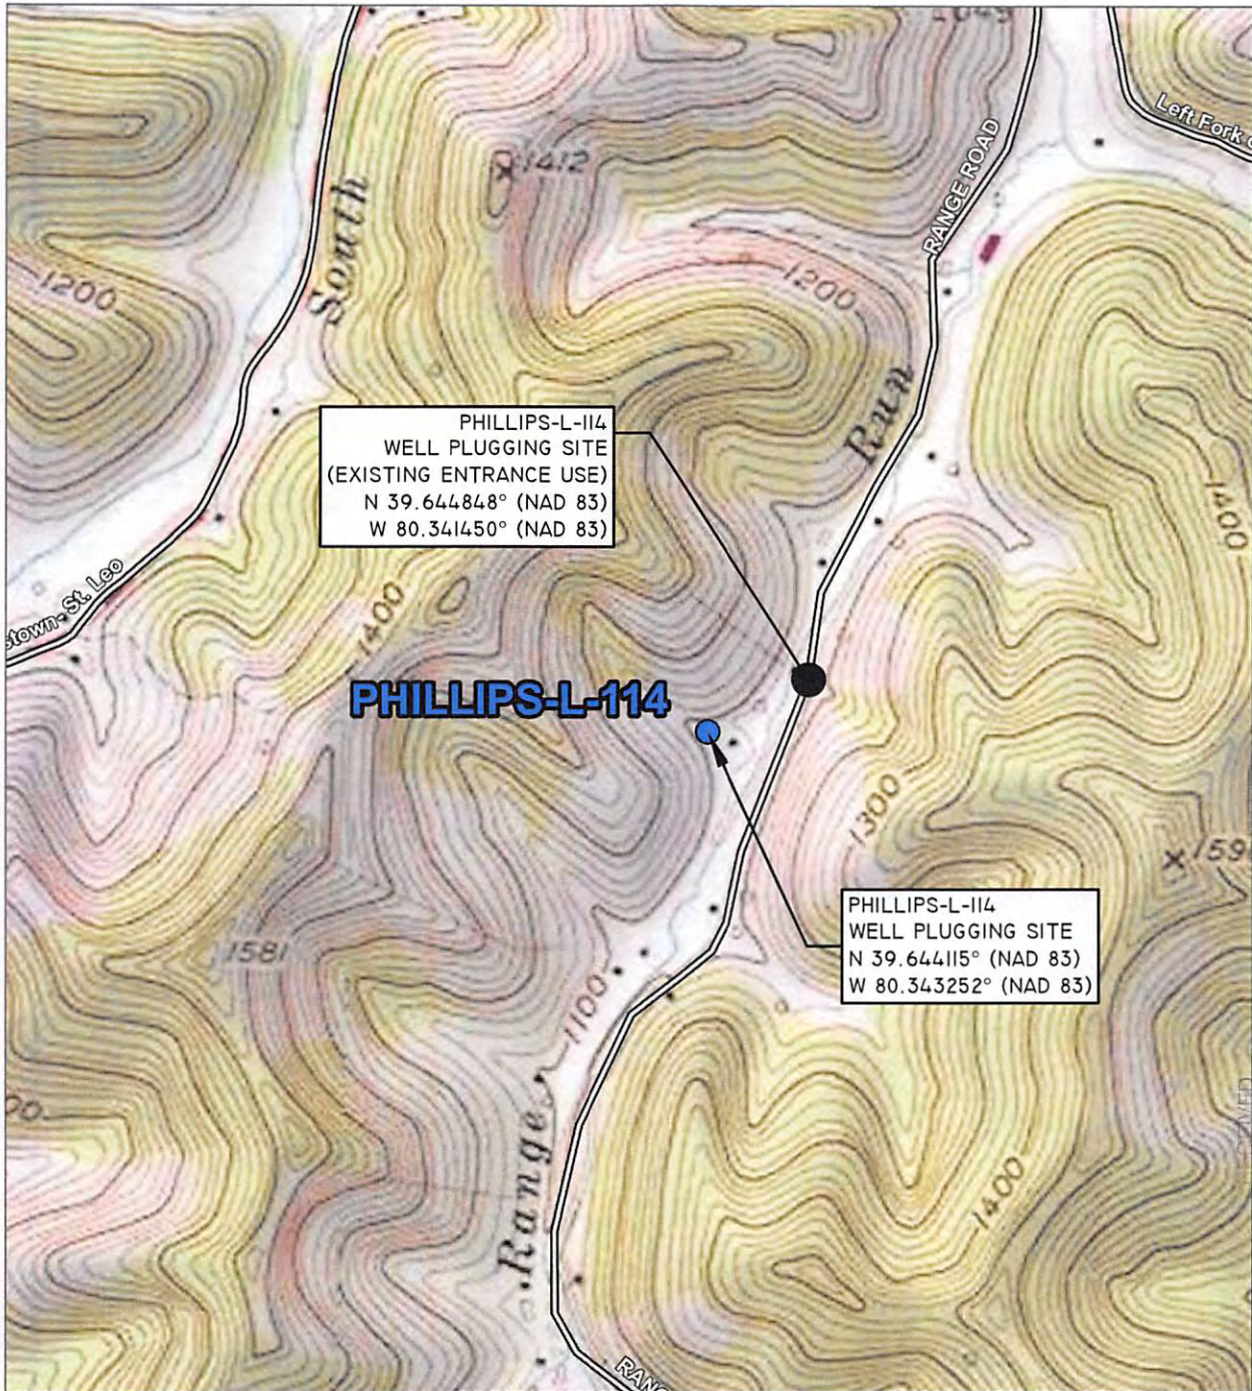

Office of Oil and Gas

SEP 26 2017

West Virginia Department of Environmental Protection

LOCATION MAP  
 WADESTOWN, WV 7.5M USGS QUADRANGLE  
 SCALE: 1"=1000'



**Blue Mountain Inc.**  
 Engineers and Land Surveyors  
 Woman Owned Small Business  
 11023 Mason Dixon Hwy.  
 Burton, WV 26562-9656  
 (304) 662-6486

LOCATION MAP  
 GAS WELL PLUGGING  
 PHILLIPS-L-114 GAS WELL  
 BATTELLE DISTRICT  
 MONONGALIA COUNTY, WV  
 CNX GAS COMPANY, LLC  
 200 HALLAM ROAD  
 WASHINGTON, PA 15301

DRAWN BY: LLF
CHECKED BY: WPF
DATE: 08/28/2017
SCALE: 1"=1000'
WATERSHED: WEST VIRGINIA FORK
PAGE <u>2</u> OF <u>2</u>