


LATITUDE 39 - 42 - 30
5,200'
Scaled Coord. 8,150'
LONGITUDE 80 - 17 - 30

Well References:
S84E, 155' to 9" Blazed & Painted Locust Snag
N45W, 152' to 4" Blazed and Painted Sugar Maple

WE WV 5568 Stake
NAD 1927 WV NORTH COOR:
N 432,982.4 E 1,771,972.3

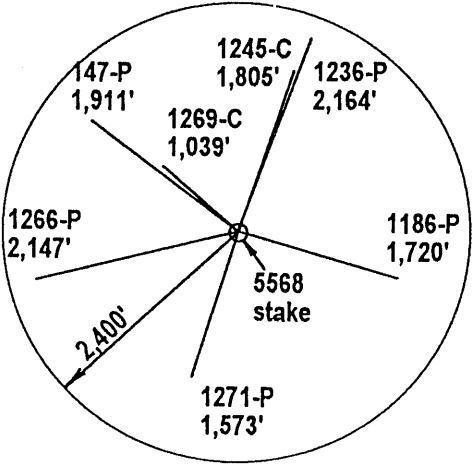


PROPERTY LINES		
Id	Bearing	Distance
L1	N 37°10'00" E	554.40'
L2	S 28°03'38" E	314.70'
L3	N 39°17'01" E	336.28'
L4	S 74°38'55" E	474.50'
L5	N 27°51'05" E	20.00'
L6	N 74°38'55" W	1010.52'
L7	N 44°49'00" W	695.71'
L8	S 36°40'54" W	212.50'
L9	S 22°51'22" E	28.00'
L10	S 52°00'00" E	554.40'

(*) DENOTES LOCATION OF WELL ON UNITED STATES TOPOGRAPHIC MAPS

FILE NUMBER: _____
DRAWING NUMBER: _____
SCALE: 1" = 660 feet
MINIMUM DEGREE OF ACCURACY: 1 in 2500
PROVEN SOURCE OF ELEVATION: GPS Survey

I THE UNDERSIGNED, HEREBY CERTIFY THAT THIS PLAT IS CORRECT TO THE BEST OF MY KNOWLEDGE AND BELIEF AND SHOWS ALL THE INFORMATION REQUIRED BY LAW AND THE REGULATIONS ISSUED AND PRESCRIBED BY THE DEPARTMENT OF ENERGY.

(SIGNED) *J. Michael Evans*
J. Michael Evans, PS 900

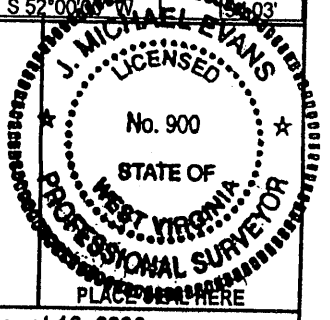

STATE OF WEST VIRGINIA
DIVISION OF ENVIRONMENTAL PROTECTION
OFFICE OF OIL AND GAS
#10 McJUNKIN ROAD
NITRO, WV 25143-2606
FORM WW-6

LAND SURVEYING SERVICES
21 CEDAR LANE, BRIDGEPORT, WV 26330
PHONE: 304-842-2018 OR 842-5762

DATE: August 12, 2003
OPERATORS WELL NO.: 5568
API WELL NO. _____
STATE COUNTY PERMIT

WELL TYPE: OIL ___ GAS LIQUID INJECTION ___ WASTE DISPOSAL ___
(IF "GAS") PRODUCTION STORAGE ___ DEEP ___ SHALLOW
LOCATION: ELEVATION 1468' WATERSHED Honey Run
DISTRICT Battelle COUNTY Monongalia
QUADRANGLE Wadestown 7.5'

SURFACE OWNER Brent W. Leegan LEASE NUMBER _____
OIL & GAS ROYALTY OWNER Brent W. Leegan ACREAGE 179.54
LEASE ACREAGE 179.54

PROPOSED WORK: DRILL CONVERT ___ DRILL DEEPER ___ REDRILL ___ FRACTURE OR STIMULATE ___ PLUG OFF OLD FORMATION ___
PERFORATE NEW FORMATION ___ OTHER PHYSICAL CHANGE (SPECIFY) _____

TARGET FORMATION Bayard PLUG & ABANDON ___ CLEAN OUT & REPLUG ___
ESTIMATED DEPTH 3750'

WELL OPERATOR Dominion Exploration & Production, Inc. DESIGNATED AGENT Rodney J. Biggs
ADDRESS P. O. Box 1248, Jane Lew, WV 26378 ADDRESS P. O. Box 1248, Jane Lew, WV 26378

(Maple-Wadestown 51)

SEP 12 2003

COUNTY NAME PERMIT MONO 1480

State of West Virginia
Department of Environmental Protection
Office of Oil and Gas

MP

Well Operator's Report of Well Work

Farm name: Leegan, Brent W. Operator Well No.: 5568

LOCATION: Elevation: 1468' Quadrangle: Wadestown 7.5

District: Battelle County: Monongalia
Latitude: 8,150 Feet South of 39 Deg. 42 Min. 30 Sec.
Longitude 5,200 Feet West of 80 Deg. 17 Min. 30 Sec.

Company: Dominion Exploration & Production, Inc

	Casing & Tubing	Used in drilling	Left in well	Cement fill up Cu. Ft.
Address: P O Box 1248 Jane Lew, WV 26378				
Agent: Rodney J. Biggs				
Inspector: Terry Urban				
Date Permit Issued: 09/10/2003				
Date Well Work Commenced: 10/31/2003	13 3/4"	30'	30'	Sand In
Date Well Work Completed: 11/14/2003				
Verbal Plugging N/A	9 5/8"	1191'	1191'	500 sks
Date Permission granted on: N/A				
Rotary X Cable Rig	7"	2211'	2211'	625 sks
Total Depth (feet): 3773'				
Fresh Water Depth (ft.): 130'	4 1/2"	3730'	3730'	165 sks
Salt Water Depth (ft.): N/A				
Is coal being mined in area (N/Y)? Y				
Coal Depths (ft.): 1961'				

OPEN FLOW DATA

Bayard/5th Sand 3471-3535
4th Sand 3368-3378'
Producing formation 50' Pay zone depth (ft) 3117-3159'
Gas: Initial open flow 353 MCF/d Oil: Initial open flow 0 Bbl/d
Final open flow 133 MCF/d Final open flow 0 Bbl/d
Time of open flow between initial and final tests 12 Hours
Static rock Pressure 525 psig (surface pressure) after 12 Hours

*Commingled

Second producing formation _____ Pay zone depth (ft) _____
Gas: Initial open flow _____ MCF/d Oil: Initial open flow _____ Bbl/d
Final open flow _____ MCF/d Final open flow _____ Bbl/d
Time of open flow between initial and final tests _____ Hours
Static rock Pressure _____ psig (surface pressure) after _____ Hours

NOTE: ON BACK OF THIS FORM PUT THE FOLLOWING: 1). DETAILS OF PERFORATED INTERVALS, FRACTURING OR STIMULATING, PHYSICAL CHANGE, ETC. 2). THE WELL LOG WHICH IS A SYSTEMATIC DETAILED GEOLOGICAL RECORD OF ALL FORMATIONS, INCLUDING COAL ENCOUNTERED BY THE WELLBORE.

Signed: *Rodney J. Biggs*
By: Rodney J. Biggs
Date: 1/8/03

MP FEB 13 2004

NO PERFORATIONS 1700

WELL 5568

11/14/2003 PERFED AND FRACED AS FOLLOWS:

BAYARD/5TH SAND, 3471 - 3535', 24 HOLES, BD 2919#, AVG RATE 20 BPM, AVG PRESS 3064#, 385 BBLs, TOT SAND 25,200#, ISIP 2650#

4TH SAND, 3368 - 3378', 22 HOLES, BD 3067#, AVG RATE 20 BPM, AVG PRESS 3010#, 290 BBLs, TOT SAND 15,200# ISIP 2510#

50', 3117 - 3159', 20 HOLES, BD 4700#, AVG RATE 15 BPM, AVG PRESS 3425#, 295 BBLs, TOT SAND 15,000#, ISIP 3010#

Clay	0	10
Sand & Shale	10	285
Sand	285	290
Sand & Shale	290	842
RR & Shale	842	854
Sand & Shale	854	1392
RR & Shale	1392	1757
Sand	1757	1854
Sand & Shale	1854	1961
Coal	1961	1965
Sand & Shale	1965	2015
RR & Shale	2015	2022
Sand & Shale	2022	2414

FORMATION TOPS

Big Lime	2417	2480
Keener	2486	2532
Greenbrier Injun	2547	2603
Pocono Injun	2611	2687
50 Foot Sand	3109	3160
30 Foot Sand	3220	3267
4 th Sand	3359	3381
5 th Sand	3459	3501
Bayard	3531	3537
Lower Byard	3573	3581
LTD		3766'