

LATITUDE 39° 42' 30"


9,303'

12,037'

LONGITUDE 80° 12' 30"


TOPG. LOC.
BLACKSVILLE QUAD.
7 1/2' SERIES

NORTH

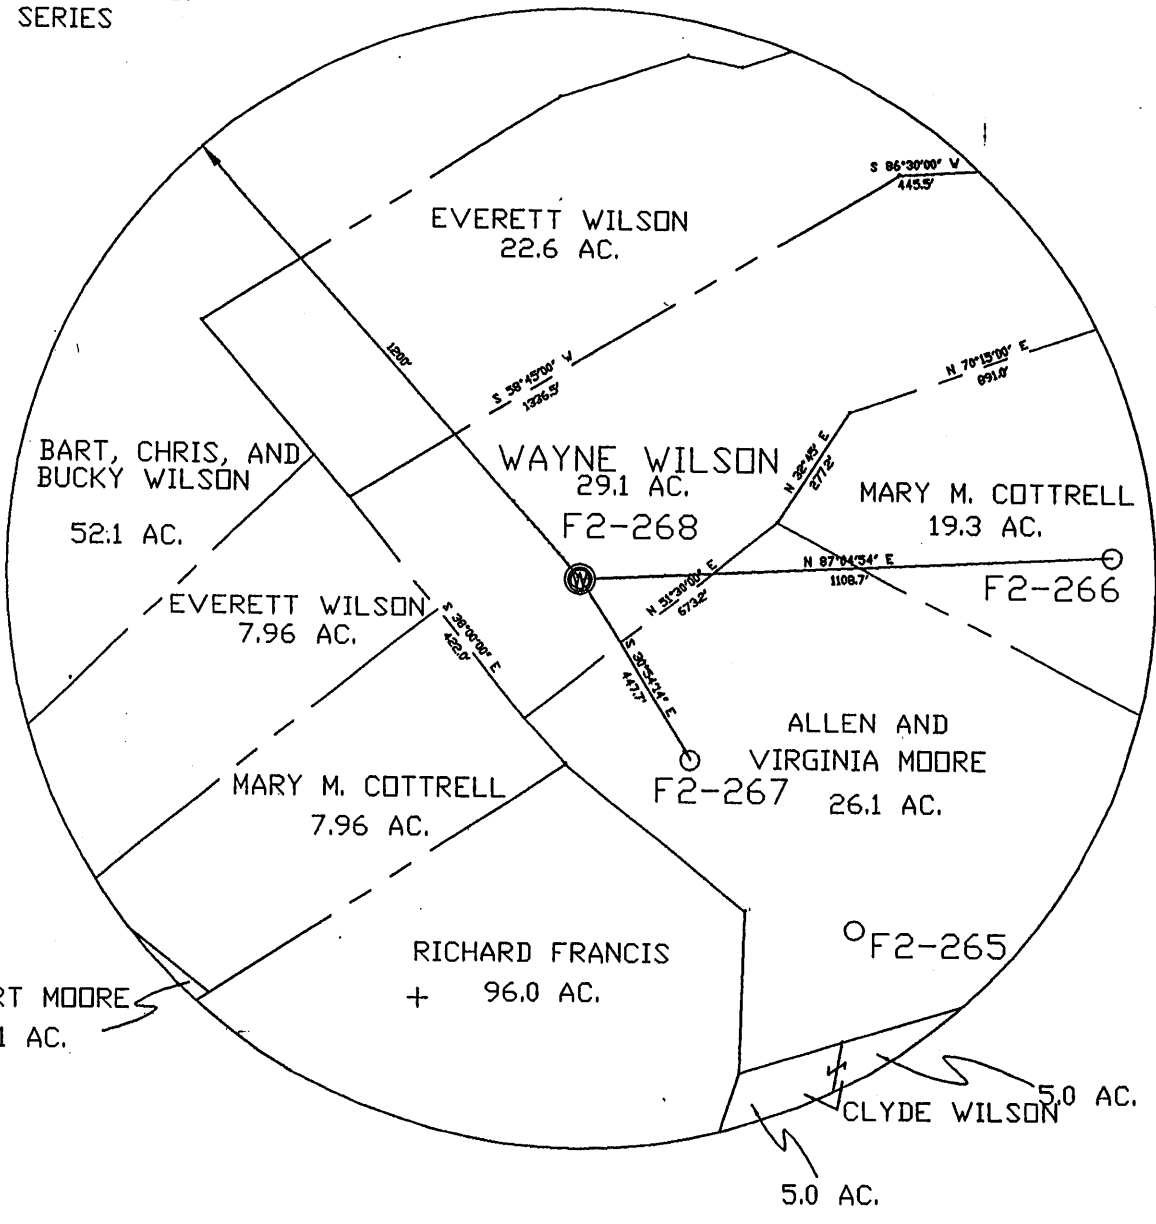

FILE NO. WELL F2-268
 DRAWING NO. F2-268
 SCALE 1"=400'
 MINIMUM DEGREE OF
 ACCURACY 1/2500'
 PROVEN SOURCE OF
 ELEVATION USGS B.M.

I THE UNDERSIGNED, HEREBY CERTIFY
 THAT THIS PLAT IS CORRECT TO THE
 BEST OF MY KNOWLEDGE AND BELIEF AND
 SHOWS ALL THE INFORMATION REQUIRED
 BY LAW AND THE REGULATIONS ISSUED
 AND PRESCRIBED BY THE DEPARTMENT OF
 MINES.
 (SIGNED) John F. Ewell, Jr.
 R.P.E. 11133 L.L.S.

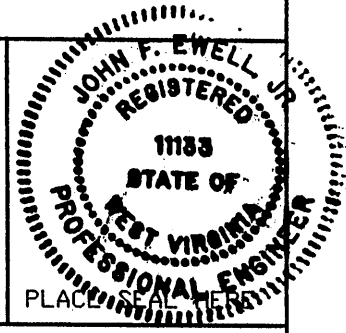

(+) DENOTES LOCATION OF
 WELL ON UNITED STATES
 TOPOGRAPHIC MAPS

FORM IV-6
 (8-78)

STATE OF WEST VIRGINIA
 DEPARTMENT OF ENVIRONMENTAL PROTECTION
 OIL AND GAS DIVISION

DATE JULY 12, 20 04
 OPERATOR'S WELL NO F2-268
 API WELL NO.
47-061-01491P
 STATE COUNTY PERMIT

Was 06171115

WELL TYPE: OIL X GAS X LIQUID INJECTION WASTE DISPOSAL
 (IF "GAS", PRODUCTION STORAGE DEEP SHALLOW X
 LOCATION: ELEVATION 1,320' WATERSHED DAYS RUN
 DISTRICT CLAY COUNTY MONONGALIA
 QUADRANGLE BLACKSVILLE

SURFACE OWNER WAYNE WILSON ACREAGE 29.1
 OIL & GAS ROYALTY OWNER UNKNOWN LEASE ACREAGE
 LEASE NO. J.N. WILSON, 110.25 AC.

PROPOSED WORK: DRILL CONVERT DRILL DEEPER REDRILL X FRACTURE OR
 STIMULATE PLUG OFF OLD FORMATION PERFORATE NEW
 FORMATION OTHER PHYSICAL CHANGE IN WELL (SPECIFY)

PLUG AND ABANDON CLEAN OUT AND REPLUG X
 TARGET FORMATION BAYARD SAND ESTIMATED DEPTH 3,200'
 WELL OPERATOR EASTERN ASSOC. COAL CORP. DESIGNATED AGENT EDWARD Y. HOY
 ADDRESS 1044 MIRACLE RUN ROAD ADDRESS 1044 MIRACLE RUN ROAD
FAIRVIEW WV, 26570 FAIRVIEW WV, 26570

MOND 1491 P

STATE OF WEST VIRGINIA
DEPARTMENT OF ENVIRONMENTAL PROTECTION
OFFICE OF OIL AND GAS

AFFIDAVIT OF PLUGGING AND FILLING WELL

AFFIDAVIT SHOULD BE IN TRIPLICATE, one copy mailed to the Department, one copy to be retained by the Well Operator and the third copy (and extra copies if required) should be mailed to each coal operator at their respective addresses.

Farm name: J.N. Wilson tract, current owner, Wayne Wilson Operator Well No.: F2-268

LOCATION: Elevation: 1,320' Quadrangle: Blacksville
District: Clay County: Monongalia
Latitude: 12,037 Feet South of 39 Deg. 42 Min. 30 Sec.
Longitude: 9,303 Feet West of 80 Deg. 12 Min. 30 Sec.

Well Type: OIL GAS

Company: Eastern Associated Coal Corp. Coal Operator Eastern Associated Coal Corp.
1044 Miracle Run Road or Owner 1044 Miracle Run Road
Fairview, WV 26570 Fairview, WV 26570

Agent: Edward Y. Hoy Coal Operator _____
or Owner _____

Permit Issued Date: August 5, 2004

AFFIDAVIT

STATE OF WEST VIRGINIA,
County of Monongalia ss:

Kenneth M. Gump and James Wheeler being first duly sworn according to law depose and say that they are experienced in the work of plugging and filling oil and gas wells and were employed by the above named well operator, and participated in the work of plugging and filling the above well, and Terry Urban, Oil and Gas Inspector representing the Director, say that said work was commenced on the 12th day of December, 2004, and that the well was plugged and filled in the following manner:

TYPE	FROM	TO	PIPE REMOVED	LEFT
	Cleaned out with 10" bit to 661'. Recovered large amounts of wood and iron.			
	Cleaned out with 8" bit to 735'. Lost bit and jars. Pulled 268' of 2" tubing from hole. Recovered 6.25 gallons of metal fines from hole.			
	Set swivel mill up and ran 9-7/8" hole opener to 1,027'.			
	Fished bit and jars out of hole.			
	Ran 7-1/2" mill to 1,342'.			
	Logged hole with Century Geophysical. Log shows Pittsburgh coal at 985' to 992'.			
	Pumped bottom plug with 100 sacks of cement.			
	Attempted to tag bottom plug but gel was too thick. Thinned gel with chemicals and ran mill back to 1,092'.			
	Ran 4-1/2" casing to 1,092' with latch down plug.			
	Pumped top plug with 970 sacks of cement and 150 sacks of E1K cement. Swabbed water off plug.			

Description of monument: 4 1/2" Pipe with metal plate, API #, and date plugged and that the work of plugging and filling said well was completed on the 6th day of May, 2005.
And further deponents saith not. Kenneth M. Gump

James Wheeler

Sworn and subscribe before me this 20th day of June, 2005
My commission expires: July 7, 2007

[Signature]
Notary Public

Oil and Gas Inspector: [Signature] 6/22/05

RECEIVED
Office of Oil & Gas
Office of Chief
JUN 24 2005
WV Department of
Environmental Protection

OFFICIAL SEAL
NOTARY PUBLIC
STATE OF WEST VIRGINIA
EDWARD Y. HOY
306 Alta Vista Avenue
Fairmont, West Virginia 26554
My Commission Expires July 7, 2007

J 1671 NOW