


Latitude 39° 40'

Longitude 80° 05'

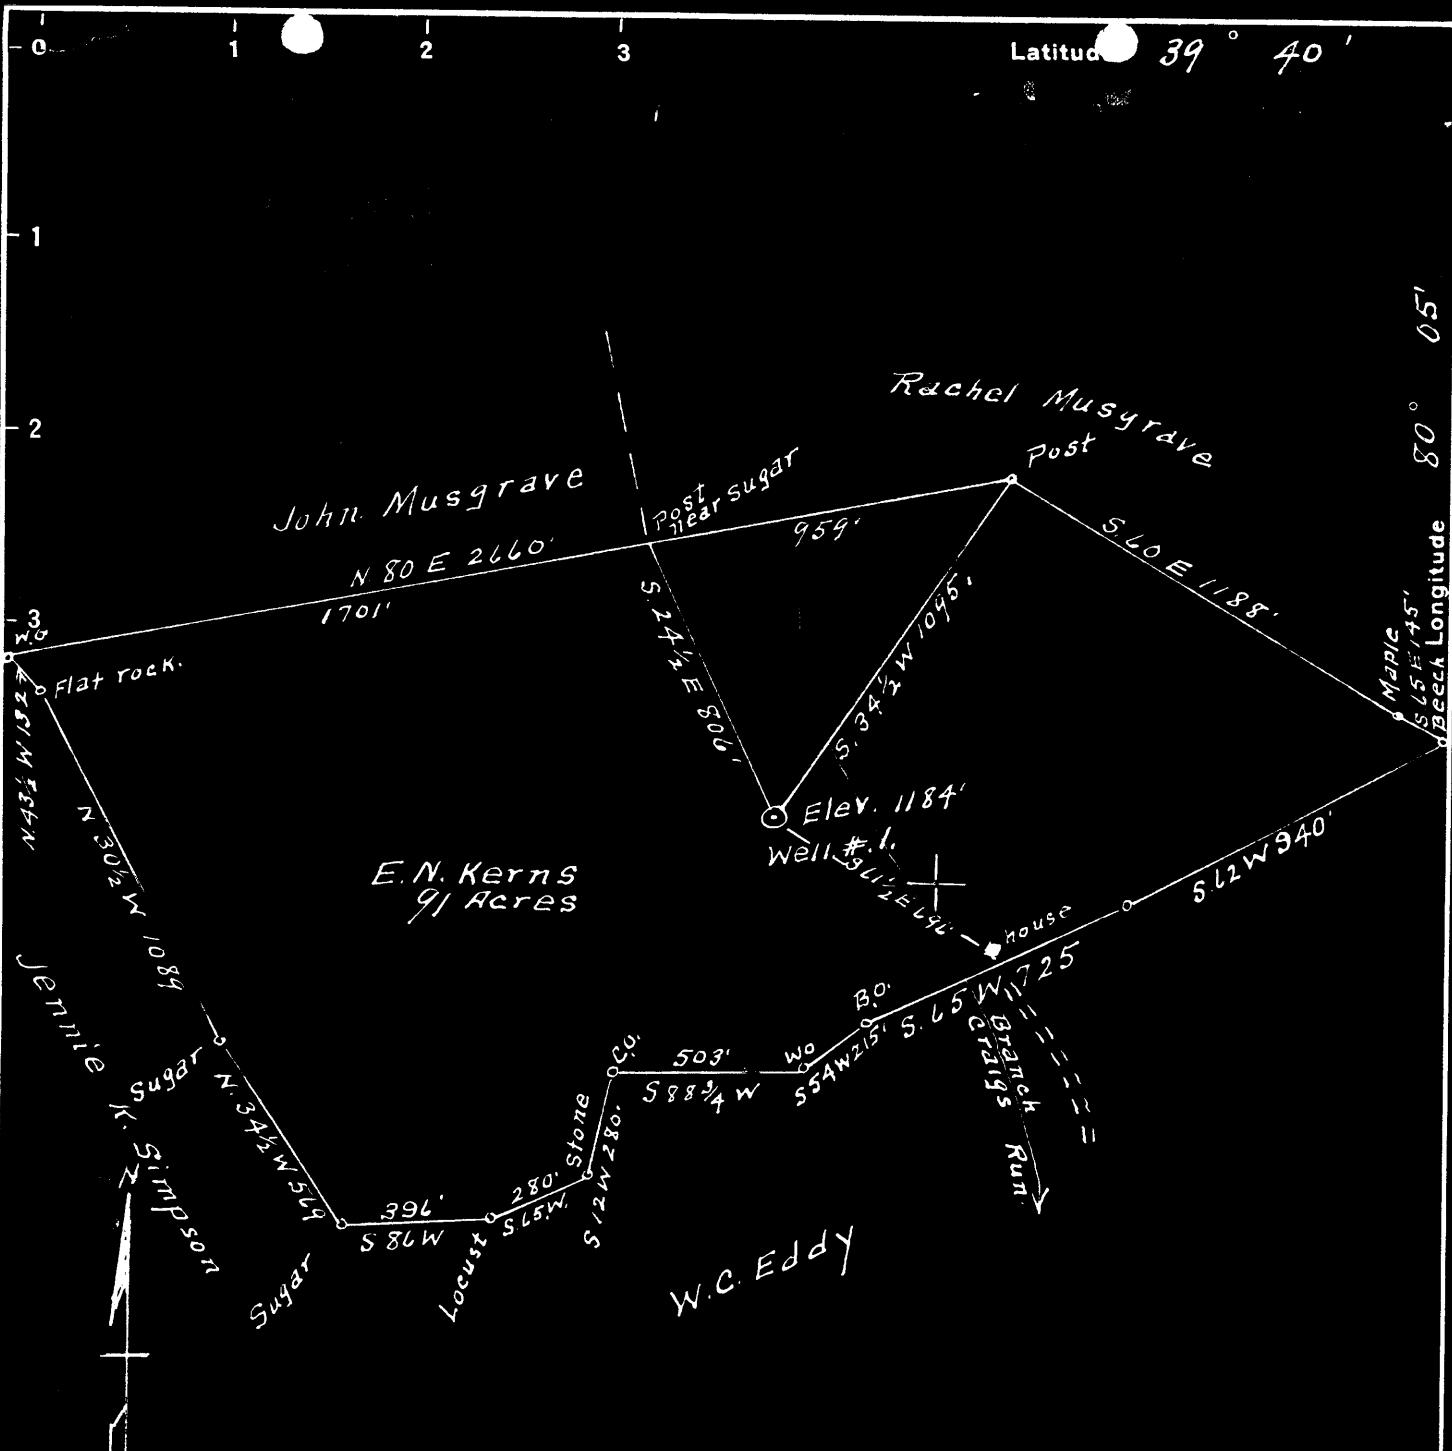

Surface = Hines Lumber Co, Chicago, Ill.  
 Coal = Pittsburgh Consolidated Coal Co  
 Osage W. Va.

New Location   
 Drill Deeper   
 Abandonment

Company E.L. Shelhaer  
 Address Brownsville, Pa  
 Farm E.N. Kerns  
 Tract 1 Acres 91 Lease No. \_\_\_\_\_  
 Well (Farm) No. 1 Serial No. \_\_\_\_\_  
 Elevation (Spirit Level) 1184  
 Quadrangle Blacksville  
 County Monongalia District Grant  
 Engineer A.S. Headley  
 Engineer's Registration No. 2021  
 File No. \_\_\_\_\_ Drawing No. \_\_\_\_\_  
 Date 11-20-1950 Scale 1" = 500'

STATE OF WEST VIRGINIA  
 DEPARTMENT OF MINES  
 OIL AND GAS DIVISION  
 CHARLESTON

**WELL LOCATION MAP**  
 FILE NO. MON-479-A

+ Denotes location of well on United States Topographic Maps, scale 1 to 62,500, latitude and longitude lines being represented by border lines as shown.

- Denotes one inch spaces on border line of original tracing.